


SCALE: 1" = 300'

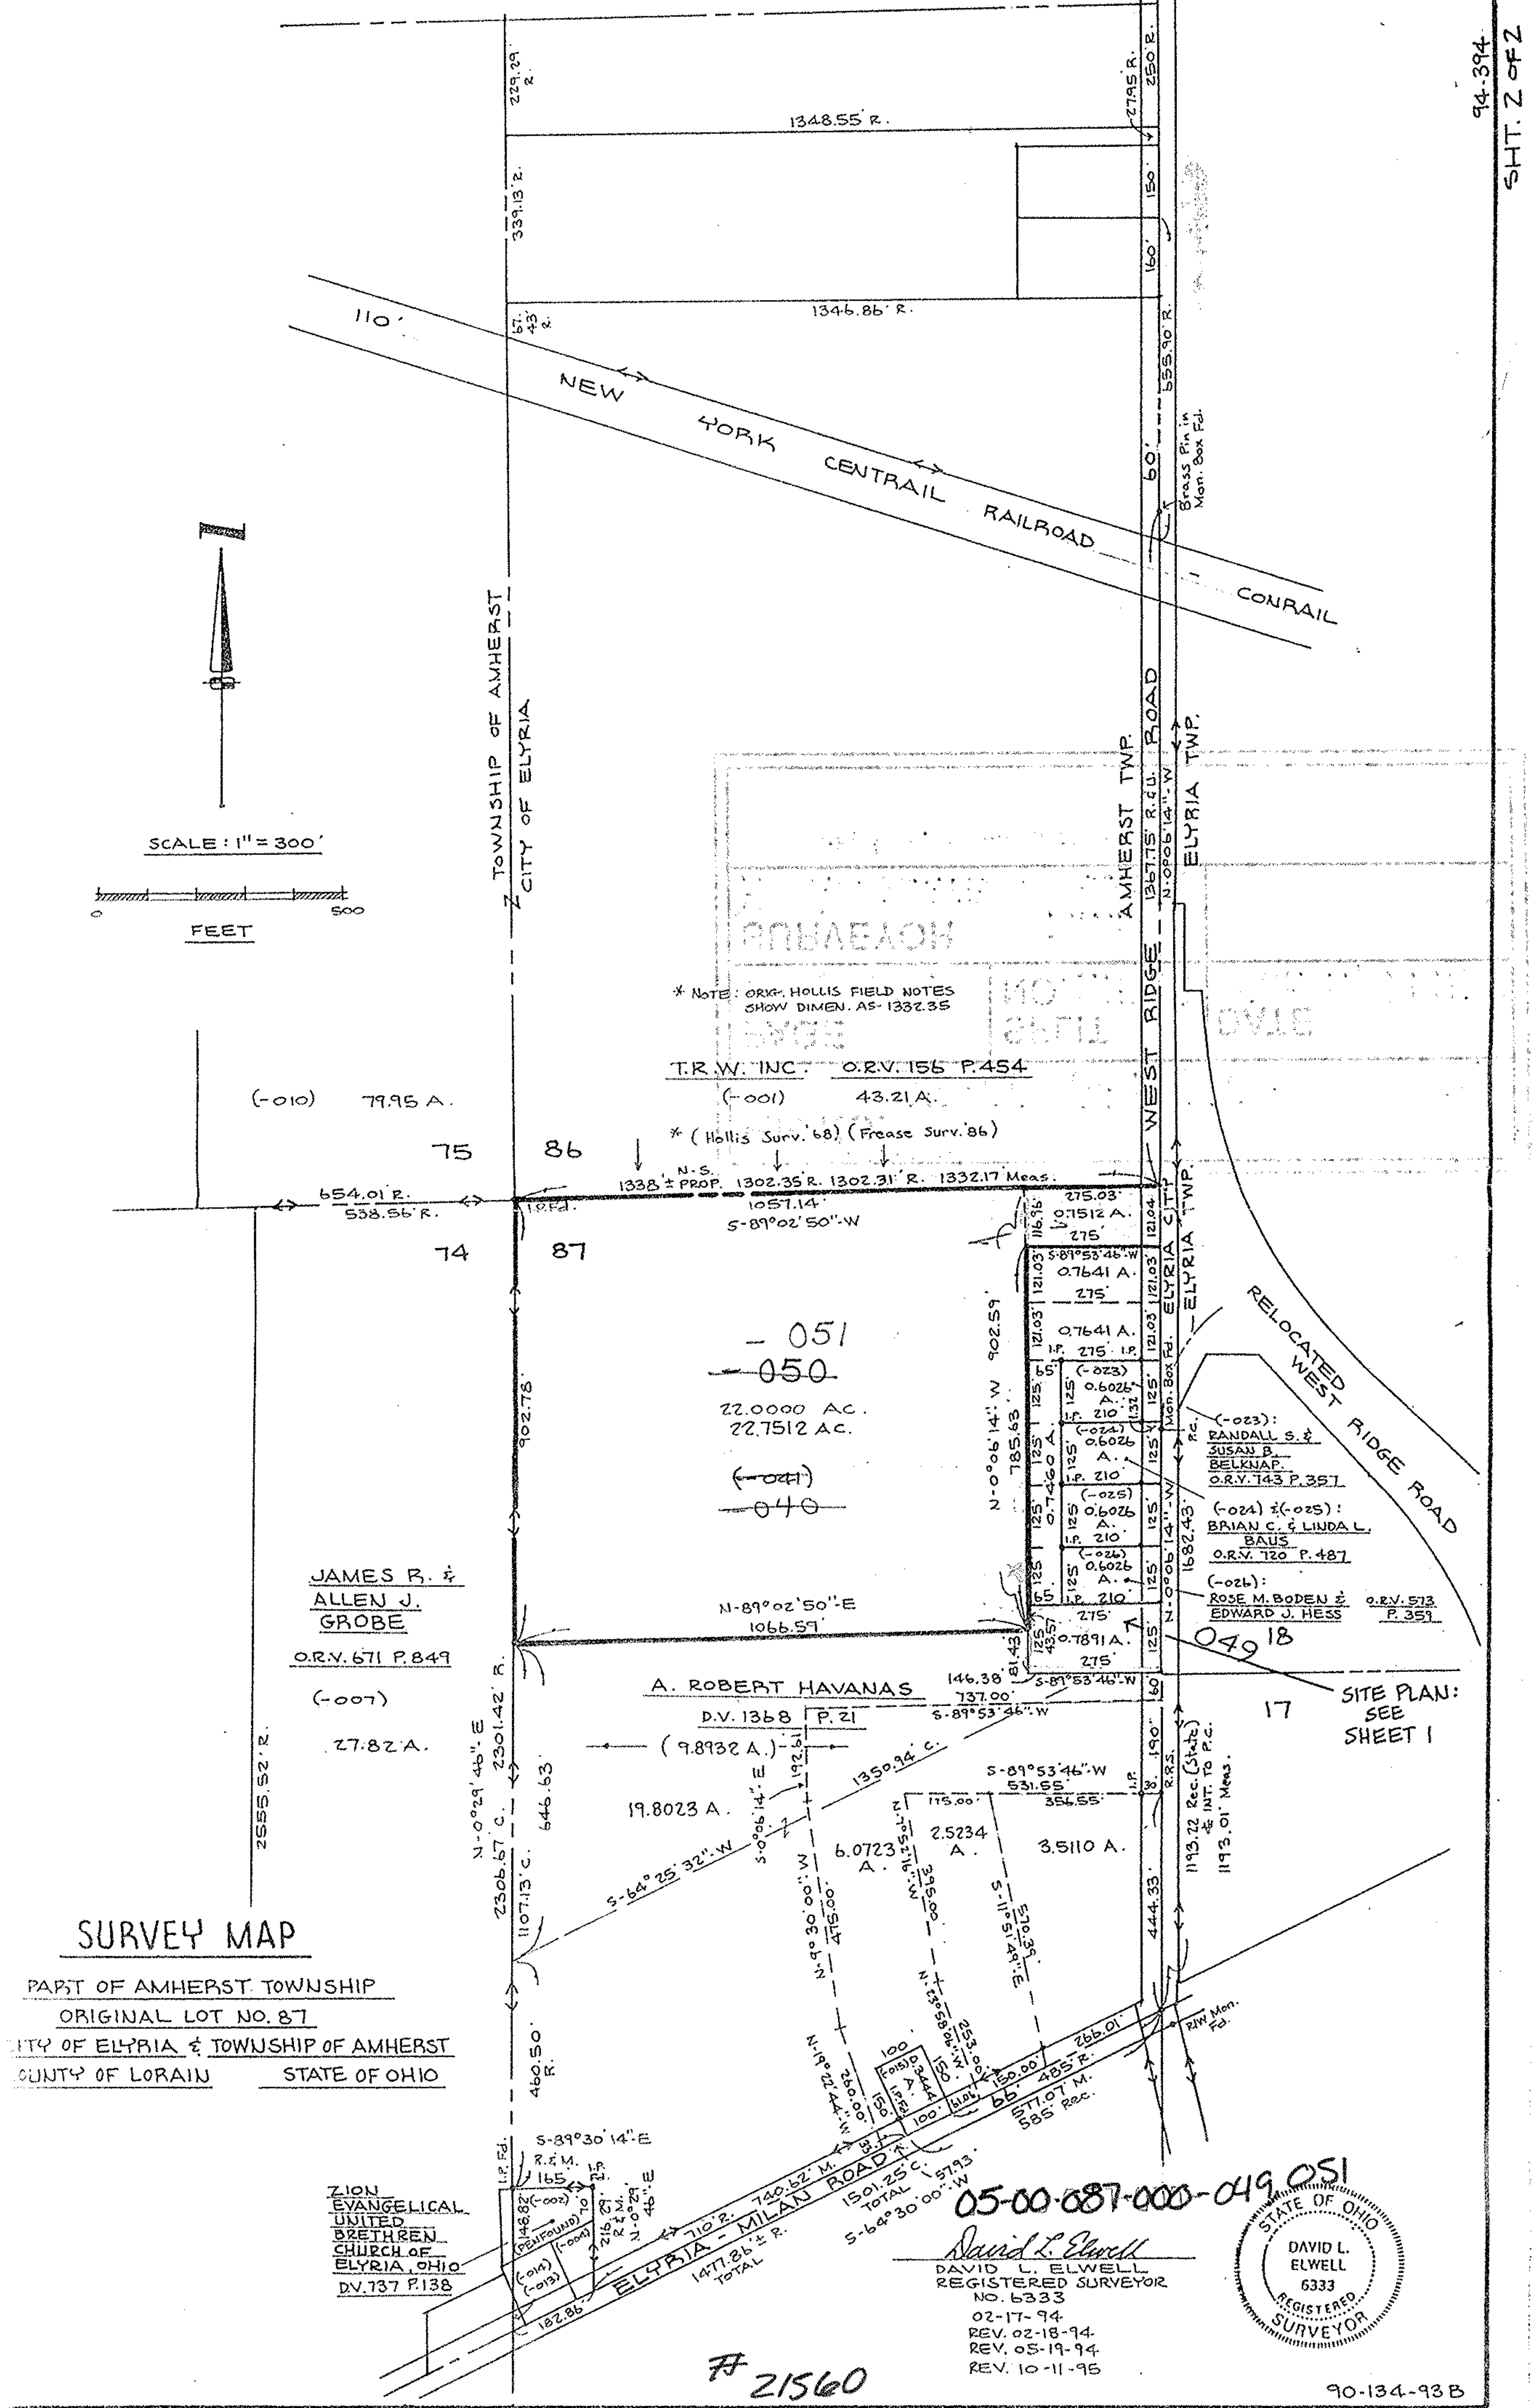

\* NOTE: ORIG. HOLLIS FIELD NOTES SHOW DIMEN. AS 1332.35

T.R.W. INC. O.R.V. 155 P.454

(-001) 43.21 A.

\* (Hollis Surv. 68) (Frease Surv. 86)

N.S. 1338 ± PROP. 1302.35 R. 1302.31 R. 1332.17 Meas.

- 051  
- 050  
22.0000 AC.  
22.7512 AC.  
(-041)  
- 040

JAMES R. &  
ALLEN J.  
GROBE  
O.R.V. 671 P.849

(-007)  
27.82 A.

A. ROBERT HAVANAS  
D.V. 1368 P.21

(9.8932 A.)

19.8023 A.

6.0723 A.

2.5234 A.

3.5110 A.

(-023):  
RANDALL S. &  
SUSAN B.  
BELKNAP.  
O.R.V. 743 P.357

(-024) & (-025):  
BRIAN C. & LINDA L.  
BAUS  
O.R.V. 720 P.487

(-026):  
ROSE M. BODEN & EDWARD J. HESS  
O.R.V. 573 P.359

17 SITE PLAN:  
SEE SHEET 1


### SURVEY MAP

PART OF AMHERST TOWNSHIP  
ORIGINAL LOT NO. 87  
CITY OF ELYRIA & TOWNSHIP OF AMHERST  
COUNTY OF LORAIN STATE OF OHIO

ZION  
EVANGELICAL  
UNITED  
BRETHREN  
CHURCH OF  
ELYRIA, OHIO  
D.V. 737 P.138

05-00-087-000-049.051

David L. Elwell  
DAVID L. ELWELL  
REGISTERED SURVEYOR  
NO. 6333  
02-17-94  
REV. 02-18-94  
REV. 05-19-94  
REV. 10-11-95

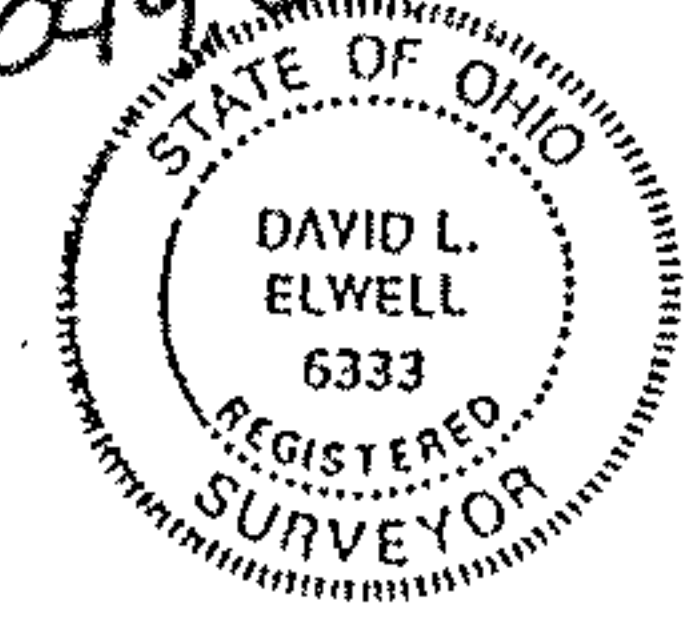

# 21560