
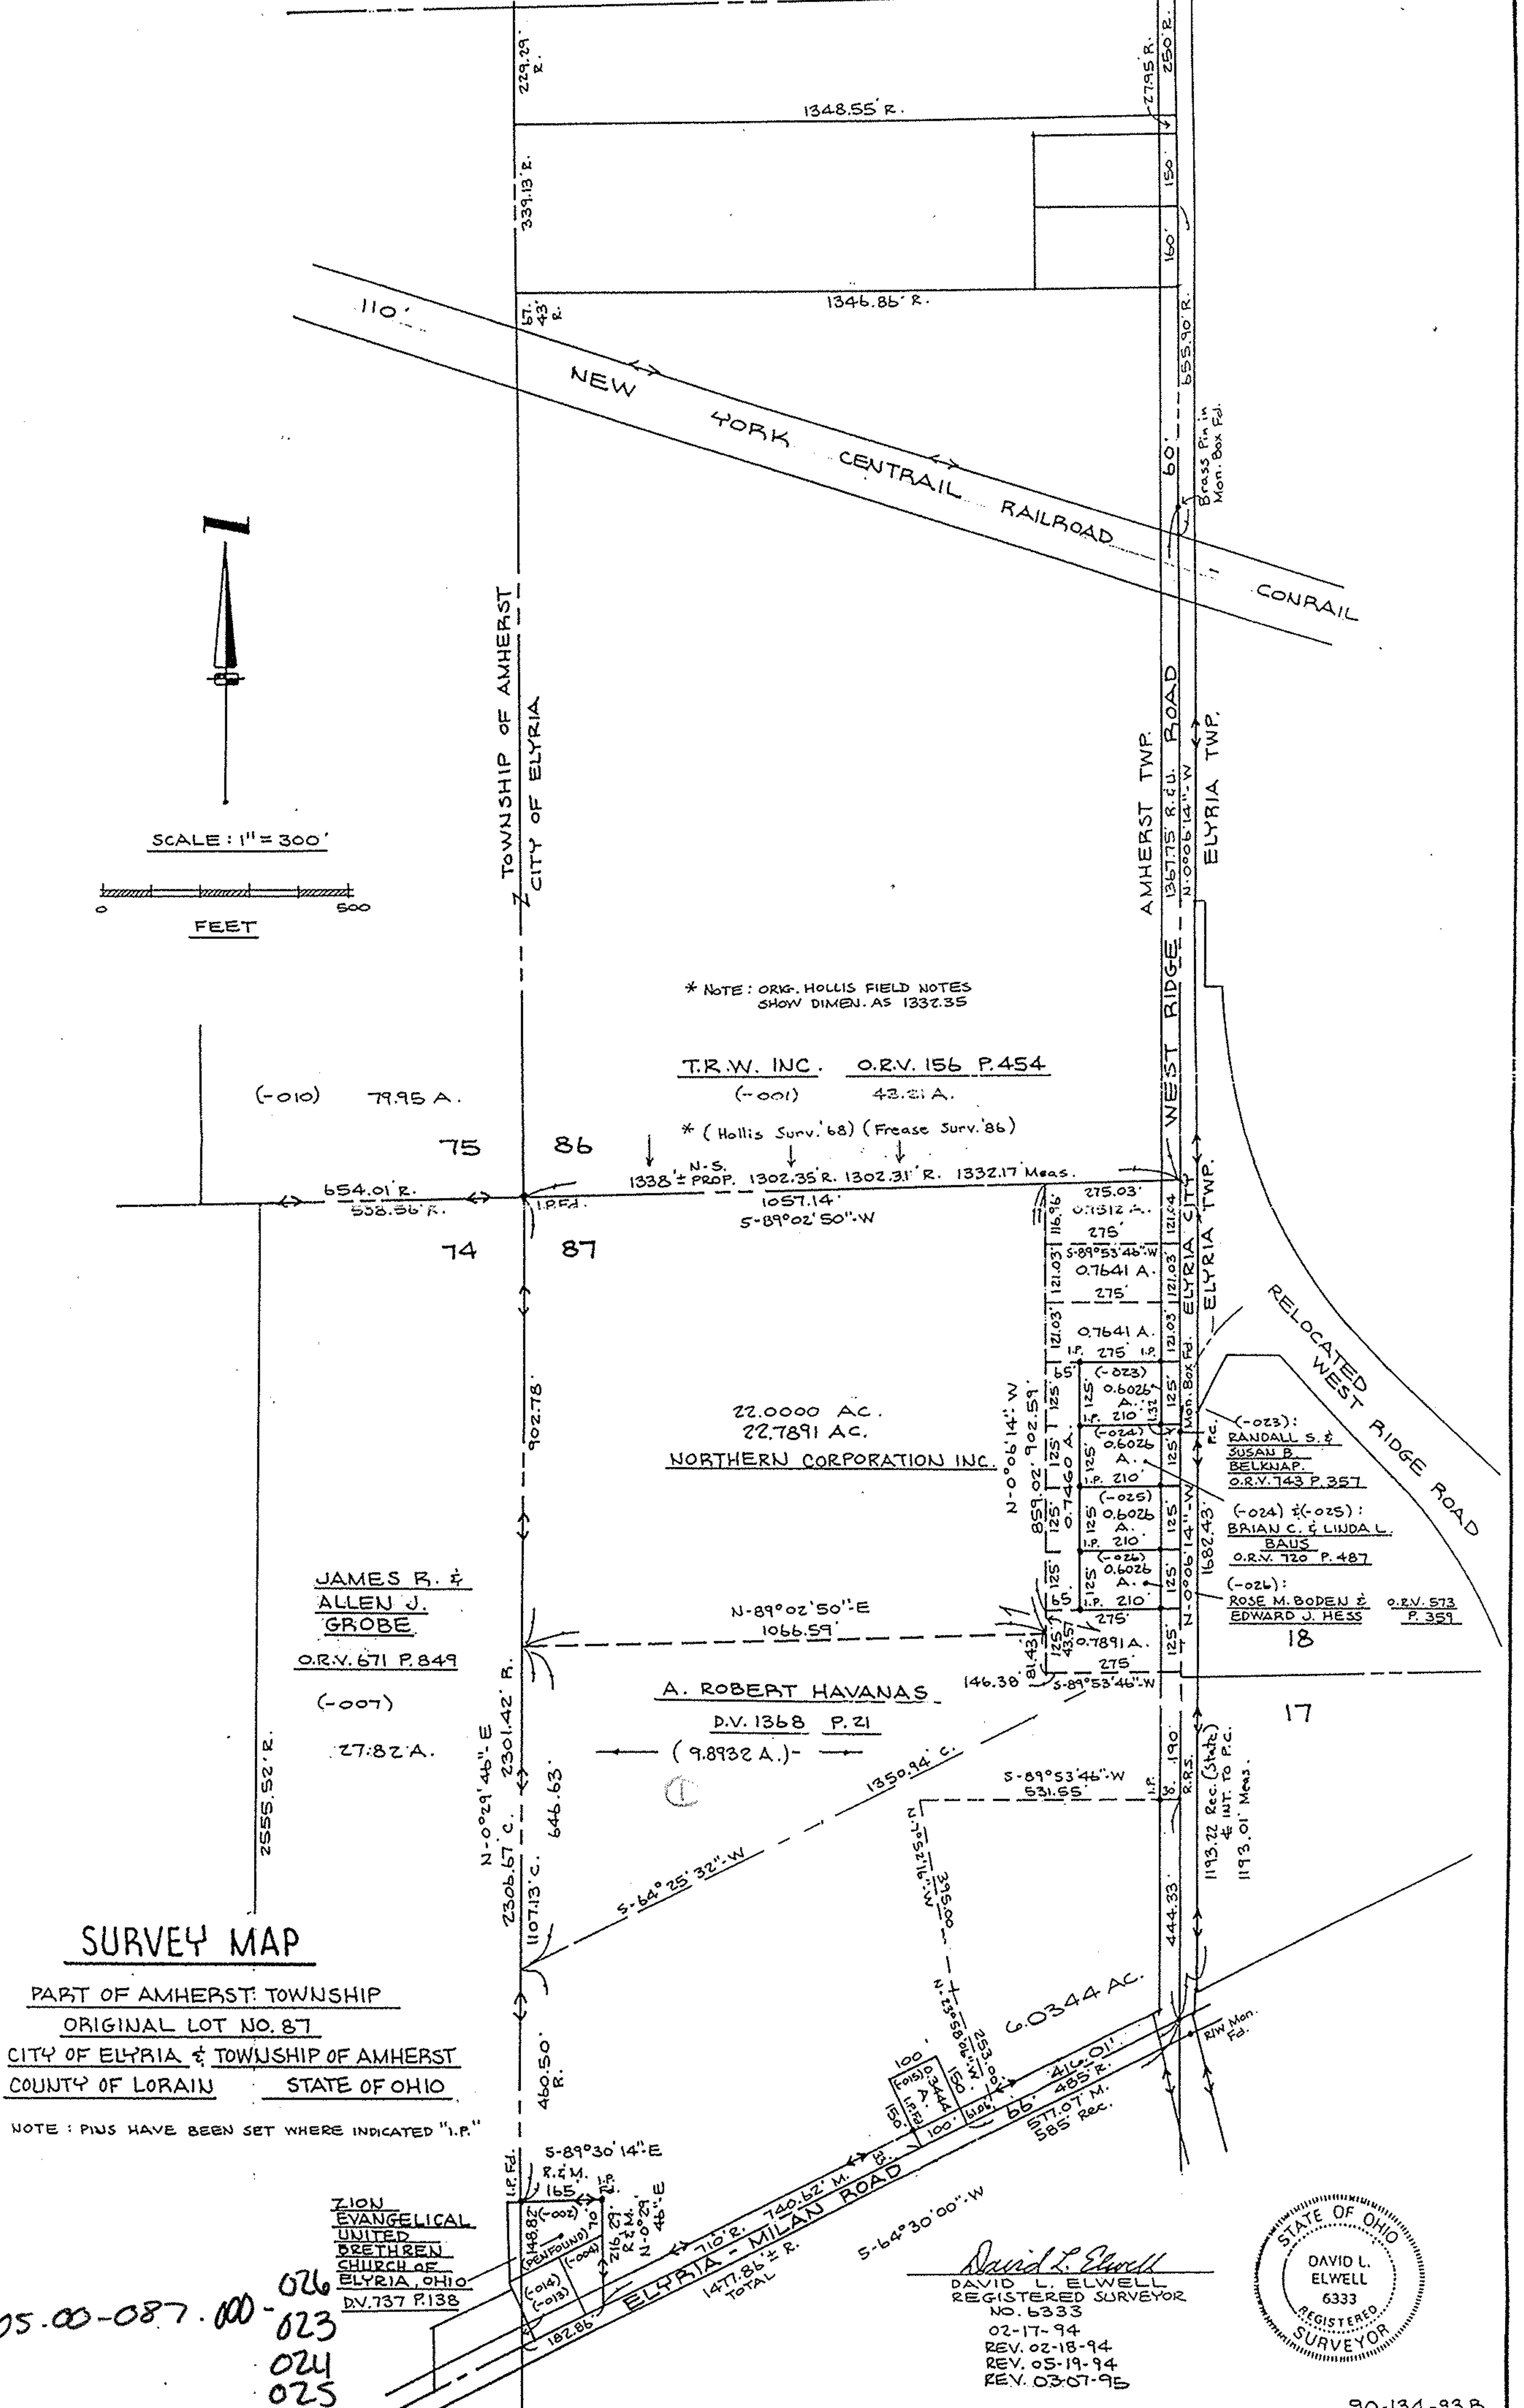


SCALE: 1" = 300'

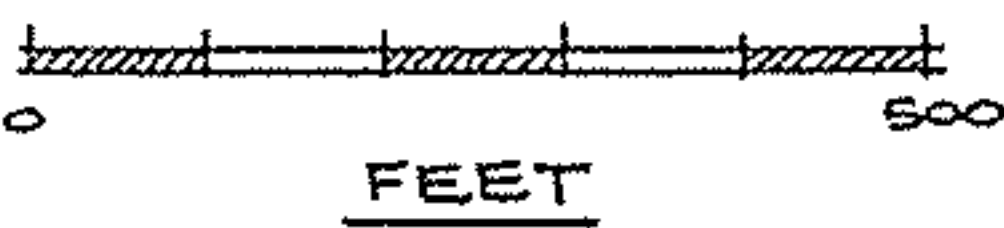

* NOTE: ORIG. HOLLIS FIELD NOTES SHOW DIMEN. AS 1332.35

T.R.W. INC. O.R.V. 156 P.454 (-001) 43.21 A.

* (Hollis Surv. 68) (Frease Surv. 86)

N.S. 1338 ± PROP. 1302.35 R. 1302.31' R. 1332.17 Meas. 1057.14' 5-89°02'50" W

22.0000 AC. 22.7891 AC. NORTHERN CORPORATION INC.

JAMES R. & ALLEN J. GROBE O.R.V. 671 P.849 (-007) 27.82 A.

A. ROBERT HAVANAS D.V. 1368 P.21 (9.8932 A.)

(-023): RANDALL S. & SUSAN B. BELKNAP O.R.V. 743 P.357

(-024) & (-025): BRIAN C. & LINDA L. BAUS O.R.V. 720 P.487

(-026): ROSE M. BODEN & EDWARD J. HESS O.R.V. 573 P.359

SURVEY MAP

PART OF AMHERST TOWNSHIP ORIGINAL LOT NO. 87 CITY OF ELYRIA & TOWNSHIP OF AMHERST COUNTY OF LORAIN STATE OF OHIO

NOTE: PINS HAVE BEEN SET WHERE INDICATED "I.P."

ZION EVANGELICAL UNITED BRETHREN CHURCH OF ELYRIA, OHIO D.V. 737 P.138

05.00-087.000-026
023
024
025

David L. Elwell
DAVID L. ELWELL
REGISTERED SURVEYOR
NO. 6333
02-17-94
REV. 02-18-94
REV. 05-19-94
REV. 03-07-95

