10-28C
5-00-085

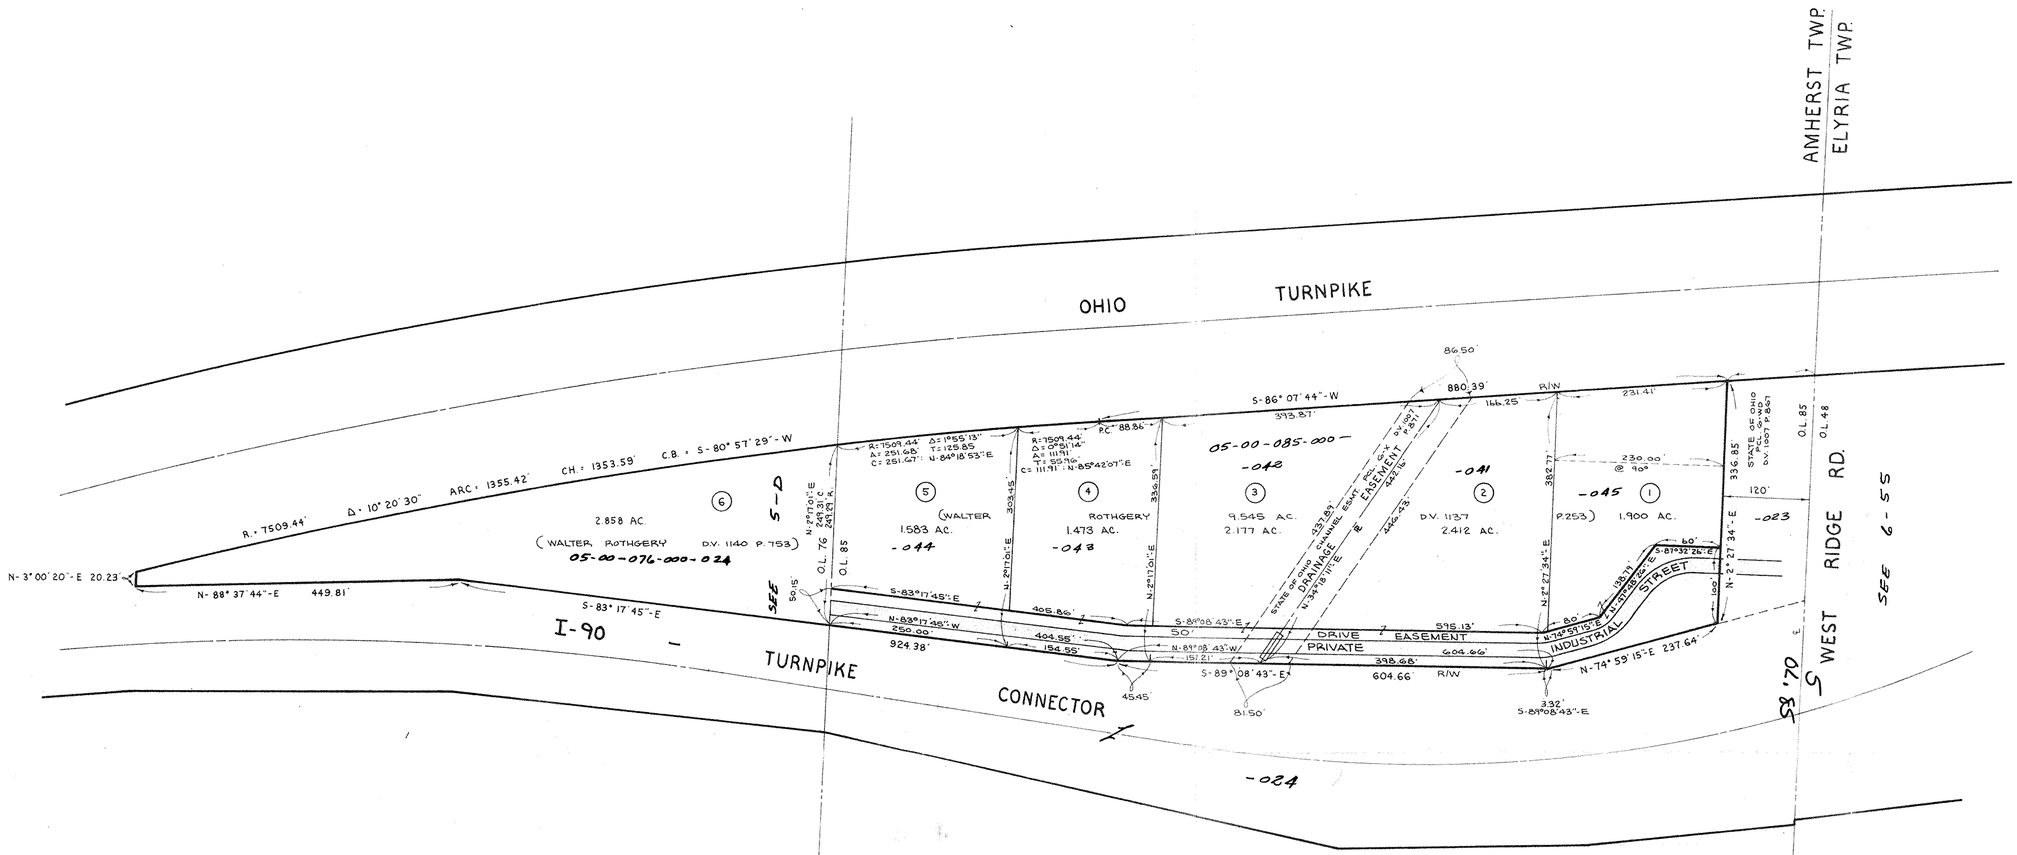

TURNPIKE INDUSTRIAL PARK

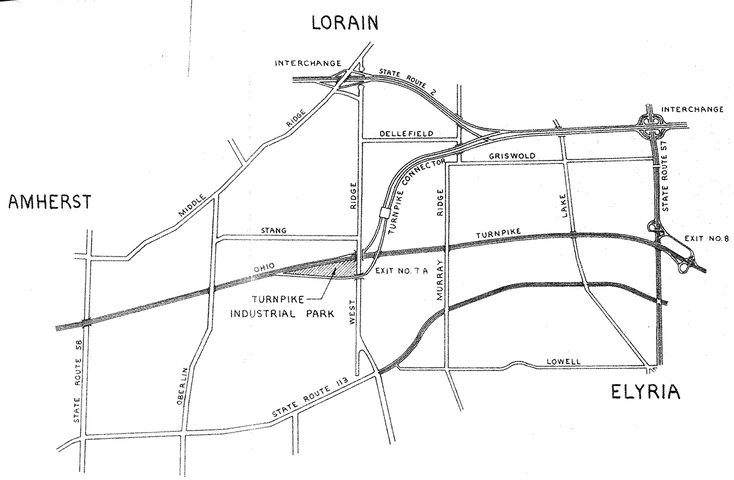

P.P. 1	085-000-042, 041, 045 05-00-076-000-024, 044, 043,
SPLIT #	DATE OF SURVEY
MAP PAGE	
SURVEYOR	

No.	Date	Description	By
1.	1-18-77	PARCEL SPLIT DATA	DR

REVISIONS

PROJECT

PARCEL MAP

OF PART OF

ORIGINAL AMHERST TOWNSHIP LOT NO. 76 & 85

TOWNSHIP OF AMHERST COUNTY OF LORAIN STATE OF OHIO

PREPARED FOR:

WALT ROTHGERY

Drawn by: DLH
Checked by:
App. by:
Scale: 1" = 100'
Date: 12-5-75

KLEINOEDER · SCHMIDT and ASSOCIATES

ENGINEERS — SURVEYORS — CONSULTANTS in LAND PLANNING

ELYRIA - NORWALK - MEDINA OHIO

REFERENCES

SHEET NO. 1 of 1

JOB NO. 76-03