Split # 21168
Page S-H

SHIRLEY SHUBERT SURVEY
PERMANENT PARCEL 05-00-086-000-007
DEED VOLUME 800 PAGE 1166/1167
TOWNSHIP OF AMHERST
COUNTY OF LORAIN
STATE OF OHIO

BEARINGS ARE ASSUMED AND ARE FOR DESCRIBING ANGLES ONLY.

IRON PINS SET WERE 5/8"Ø x 30" LONG REBAR.

PLACE OF BEGINNING IS A PK NAIL.

PRINCIPAL PLACE OF BEGINNING IS A PK NAIL.

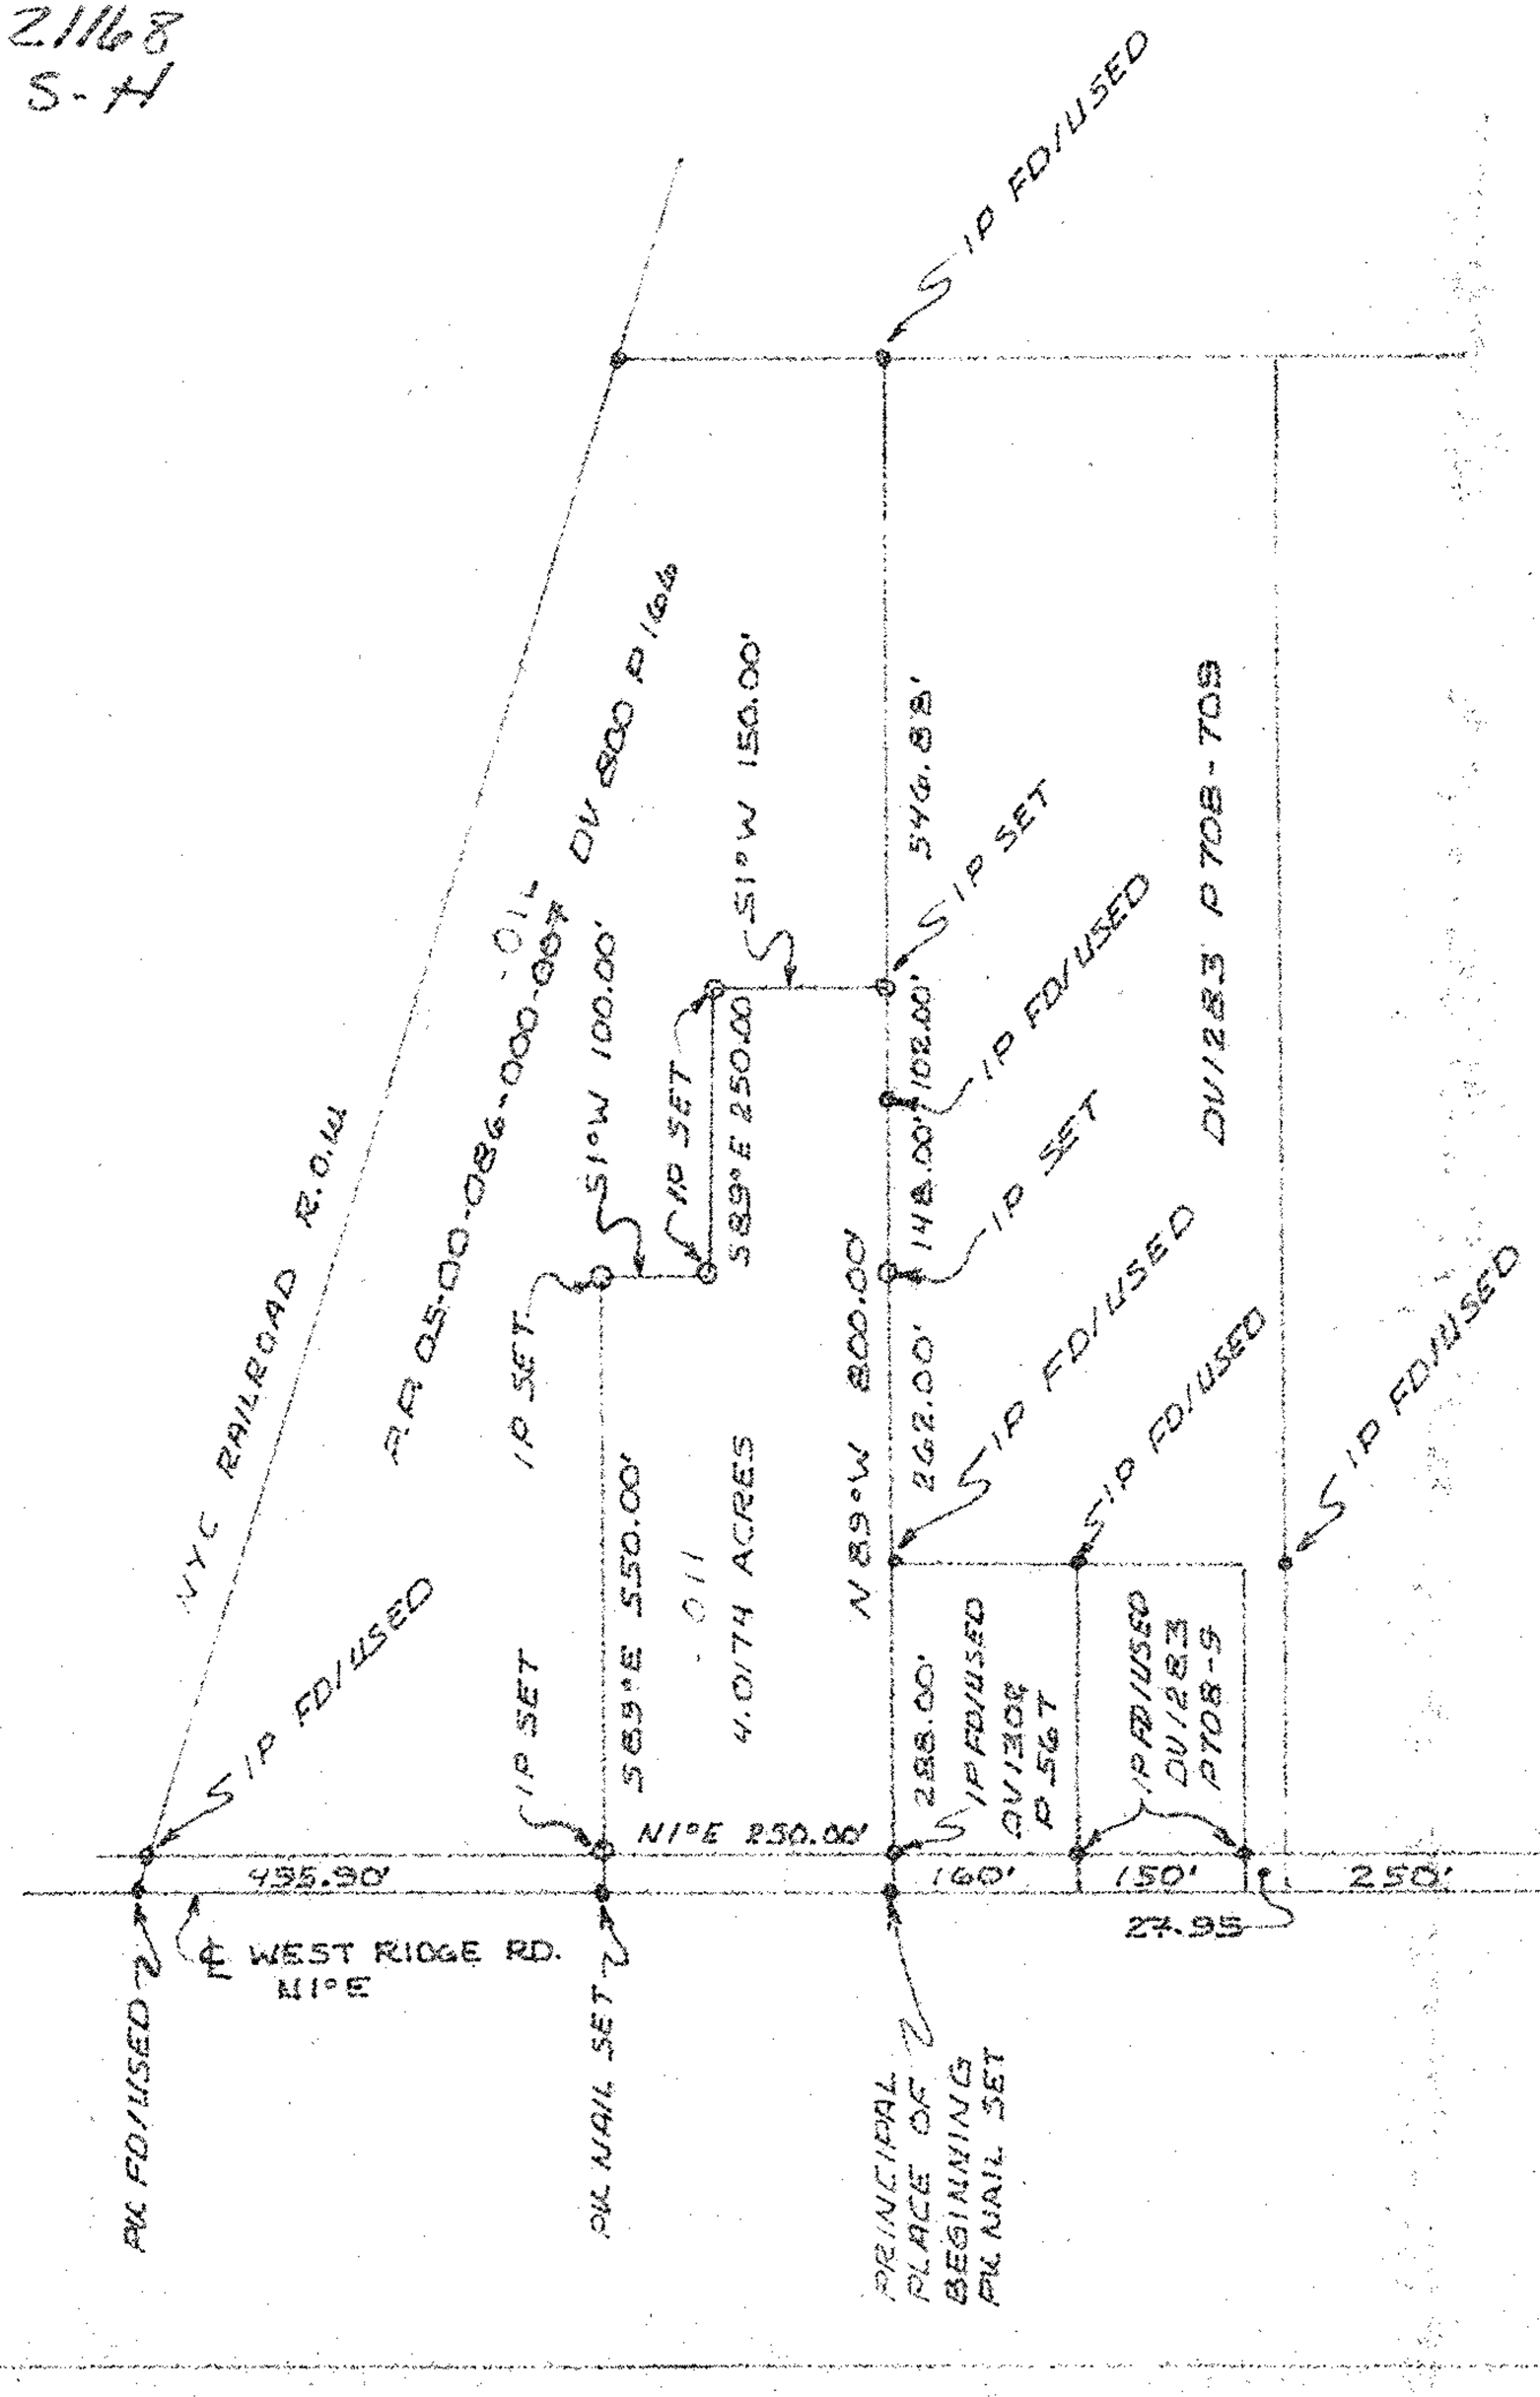

STATE OF OHIO
CARL R. ANDERSON
6582
REGISTERED SURVEYOR

Carl R. Anderson

TAX MAP PG. 5-H

4.0174 ACRE SURVEY - SPLIT OF P.P. 05-00-086-000-007		
DATE: NOV. 2, 1994	REVISED:	DRAWN: CRA
SHIRLEY SHUBERT		172-94