05-00-084-000-004 thru 013
22720 page 5-D

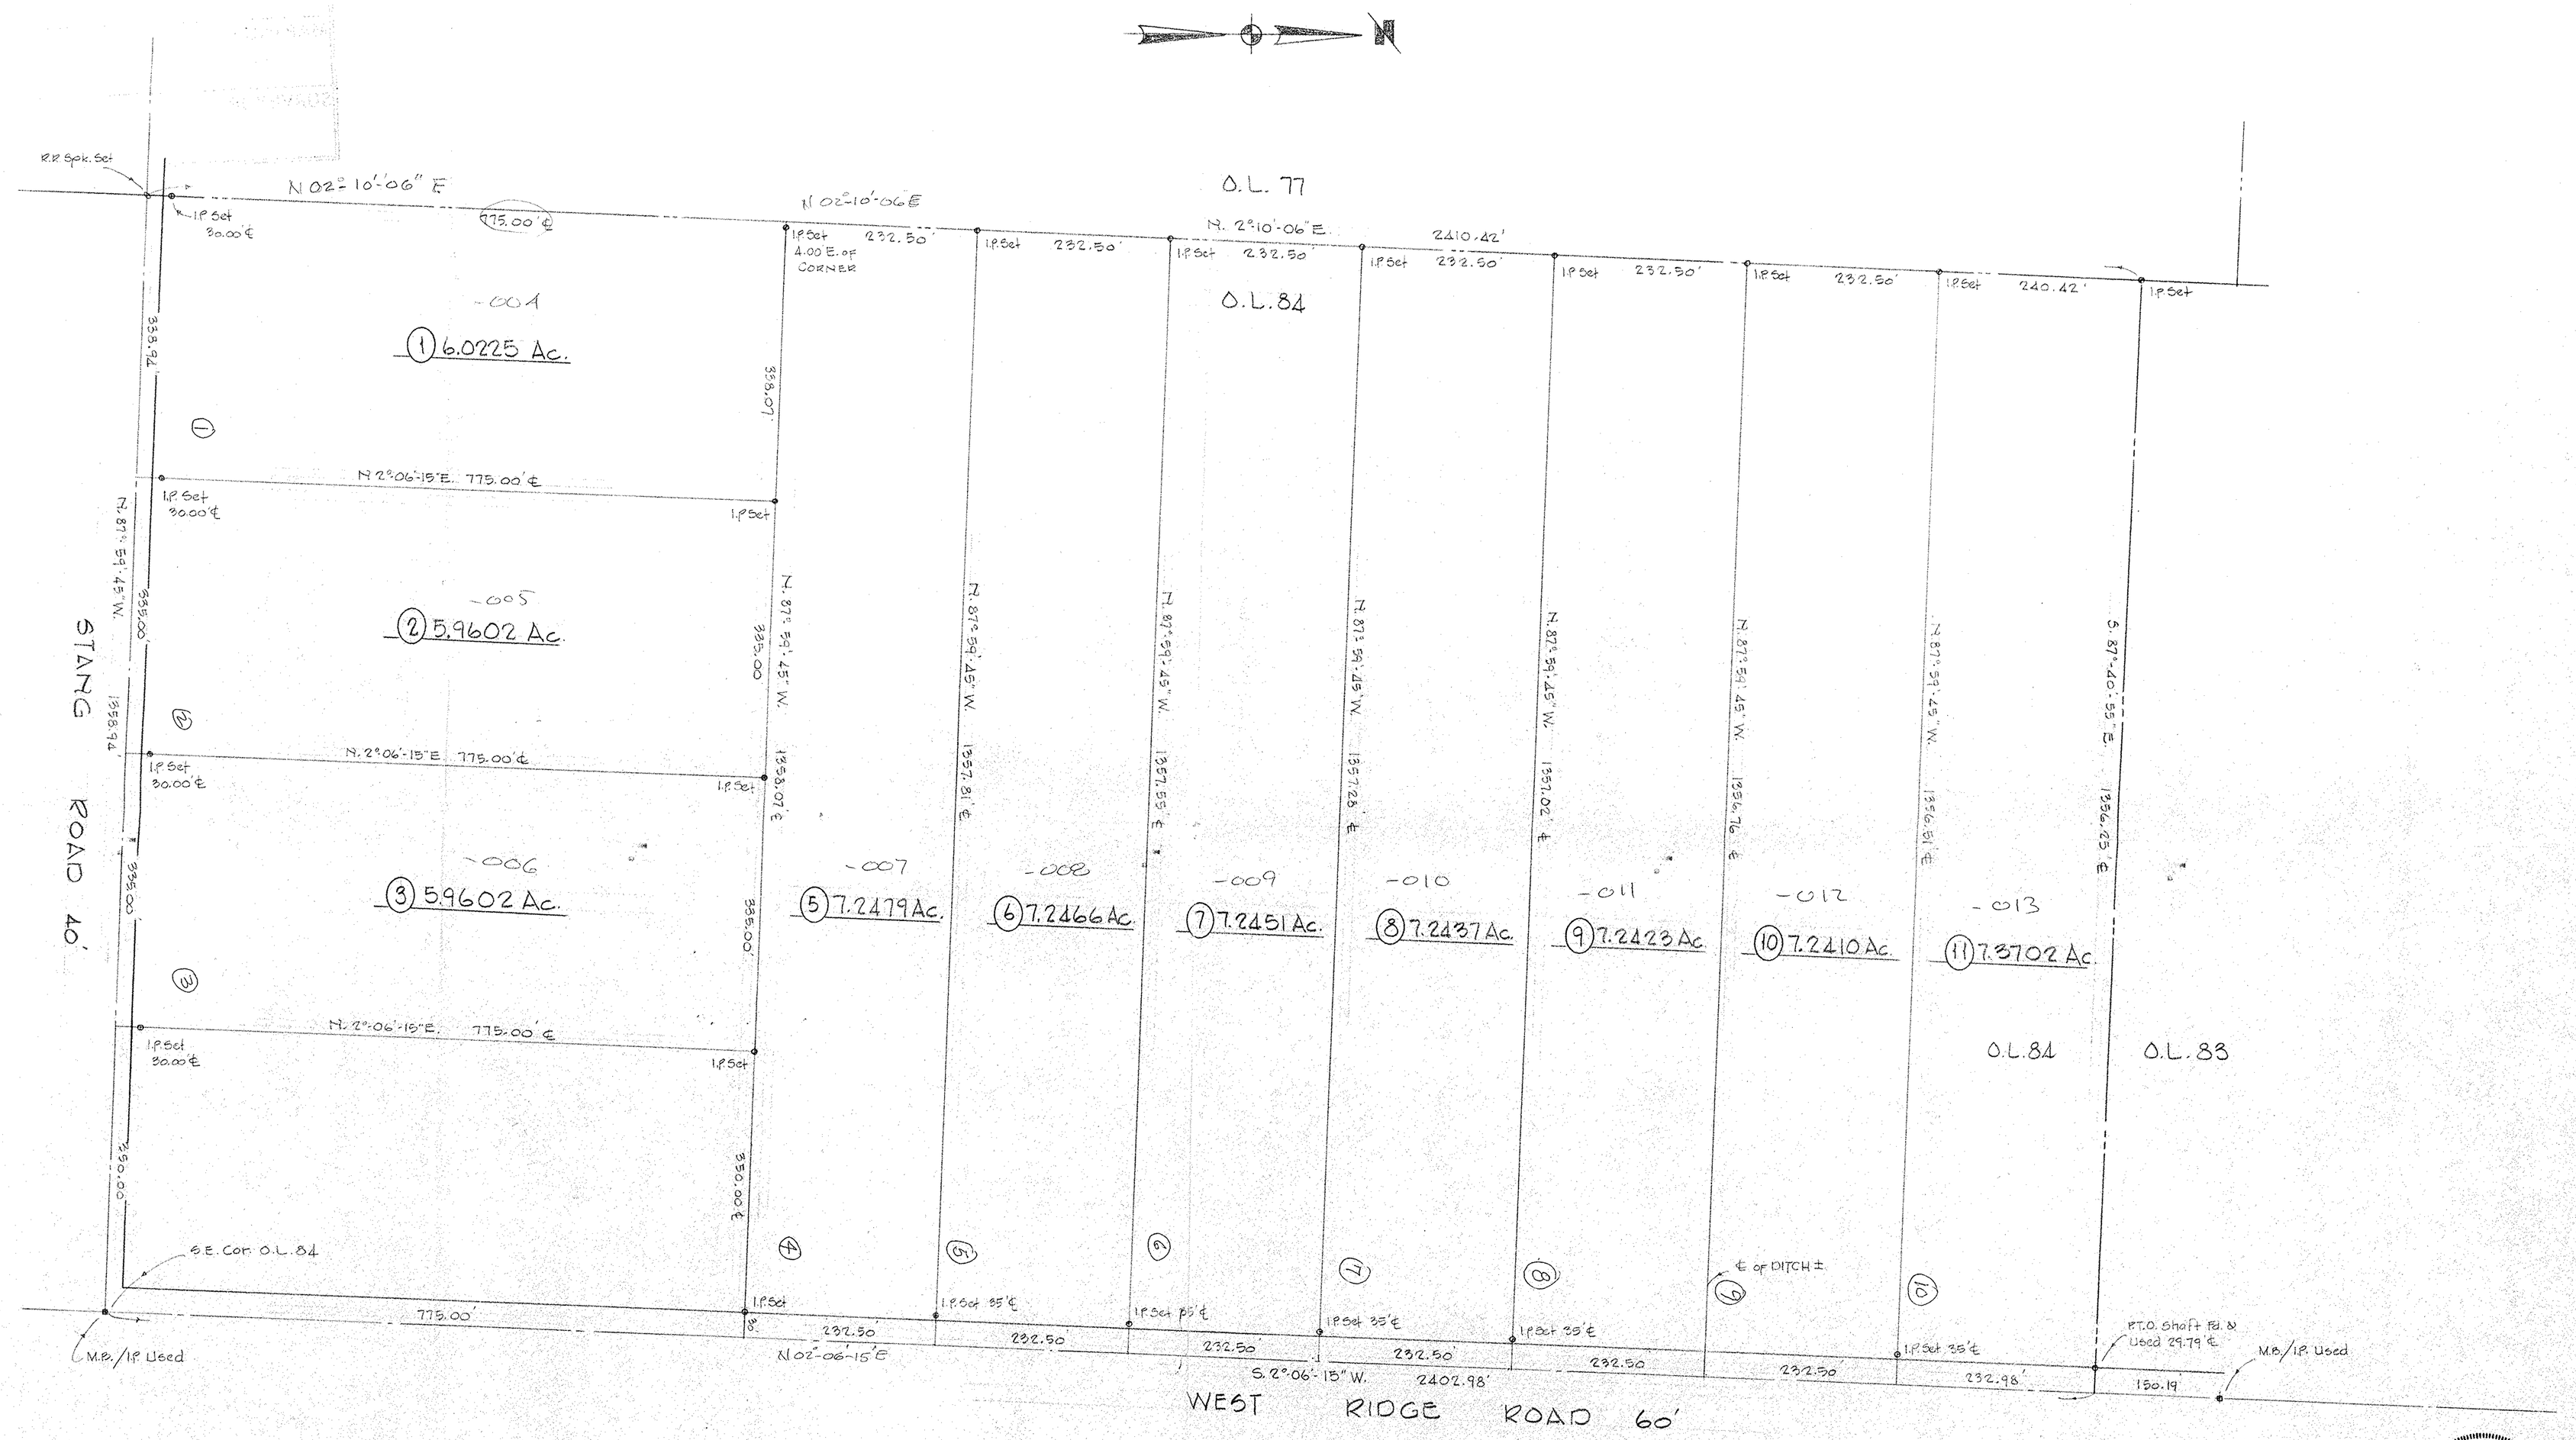

#22720
APPROVED
LORAIN CO.
MAP DEPT.
DATE 12-16-98
PAGE 5-D
BY T. Dall
PCL NUMBER 22720

REVISED 9-9-98 DELETED PCL. Nº 4 & INCREASED ACREAGES OF PCL'S 1, 2 & 3 R.G.S.

STATE OF OHIO
RODGER G. SIMON
6101
REGISTERED SURVEYOR

PARCEL SPLIT FOR

BARBARA B. MUSOLF

PART of O.L. 84 — TOWNSHIP of AMHERST
COUNTY of LORAIN — STATE of OHIO
SCALE 1"=100' — JULY, 1998
LAUNDON • SIMON • CAHL & ASSOC.
PROFESSIONAL LAND SURVEYORS
98-3037 — F.B. 244 P.4