PLAT OF PROPOSED ANNEXATION
TO THE VILLAGE OF SOUTH AMHERST

PART OF ORIGINAL AMHERST TOWNSHIP LOT NO. 91
TOWNSHIP OF AMHERST & PART OF VILLAGE OF S. AMHERST
COUNTY OF LORAIN * STATE OF OHIO

JULY 1994 SCALE: 1"=100'

GRAPHIC SCALE

100 0 50 100 200 400

(IN FEET)
1 inch = 100 ft.

LEGEND
- ◉ IRON PIN FOUND
- ○ IRON PIN SET

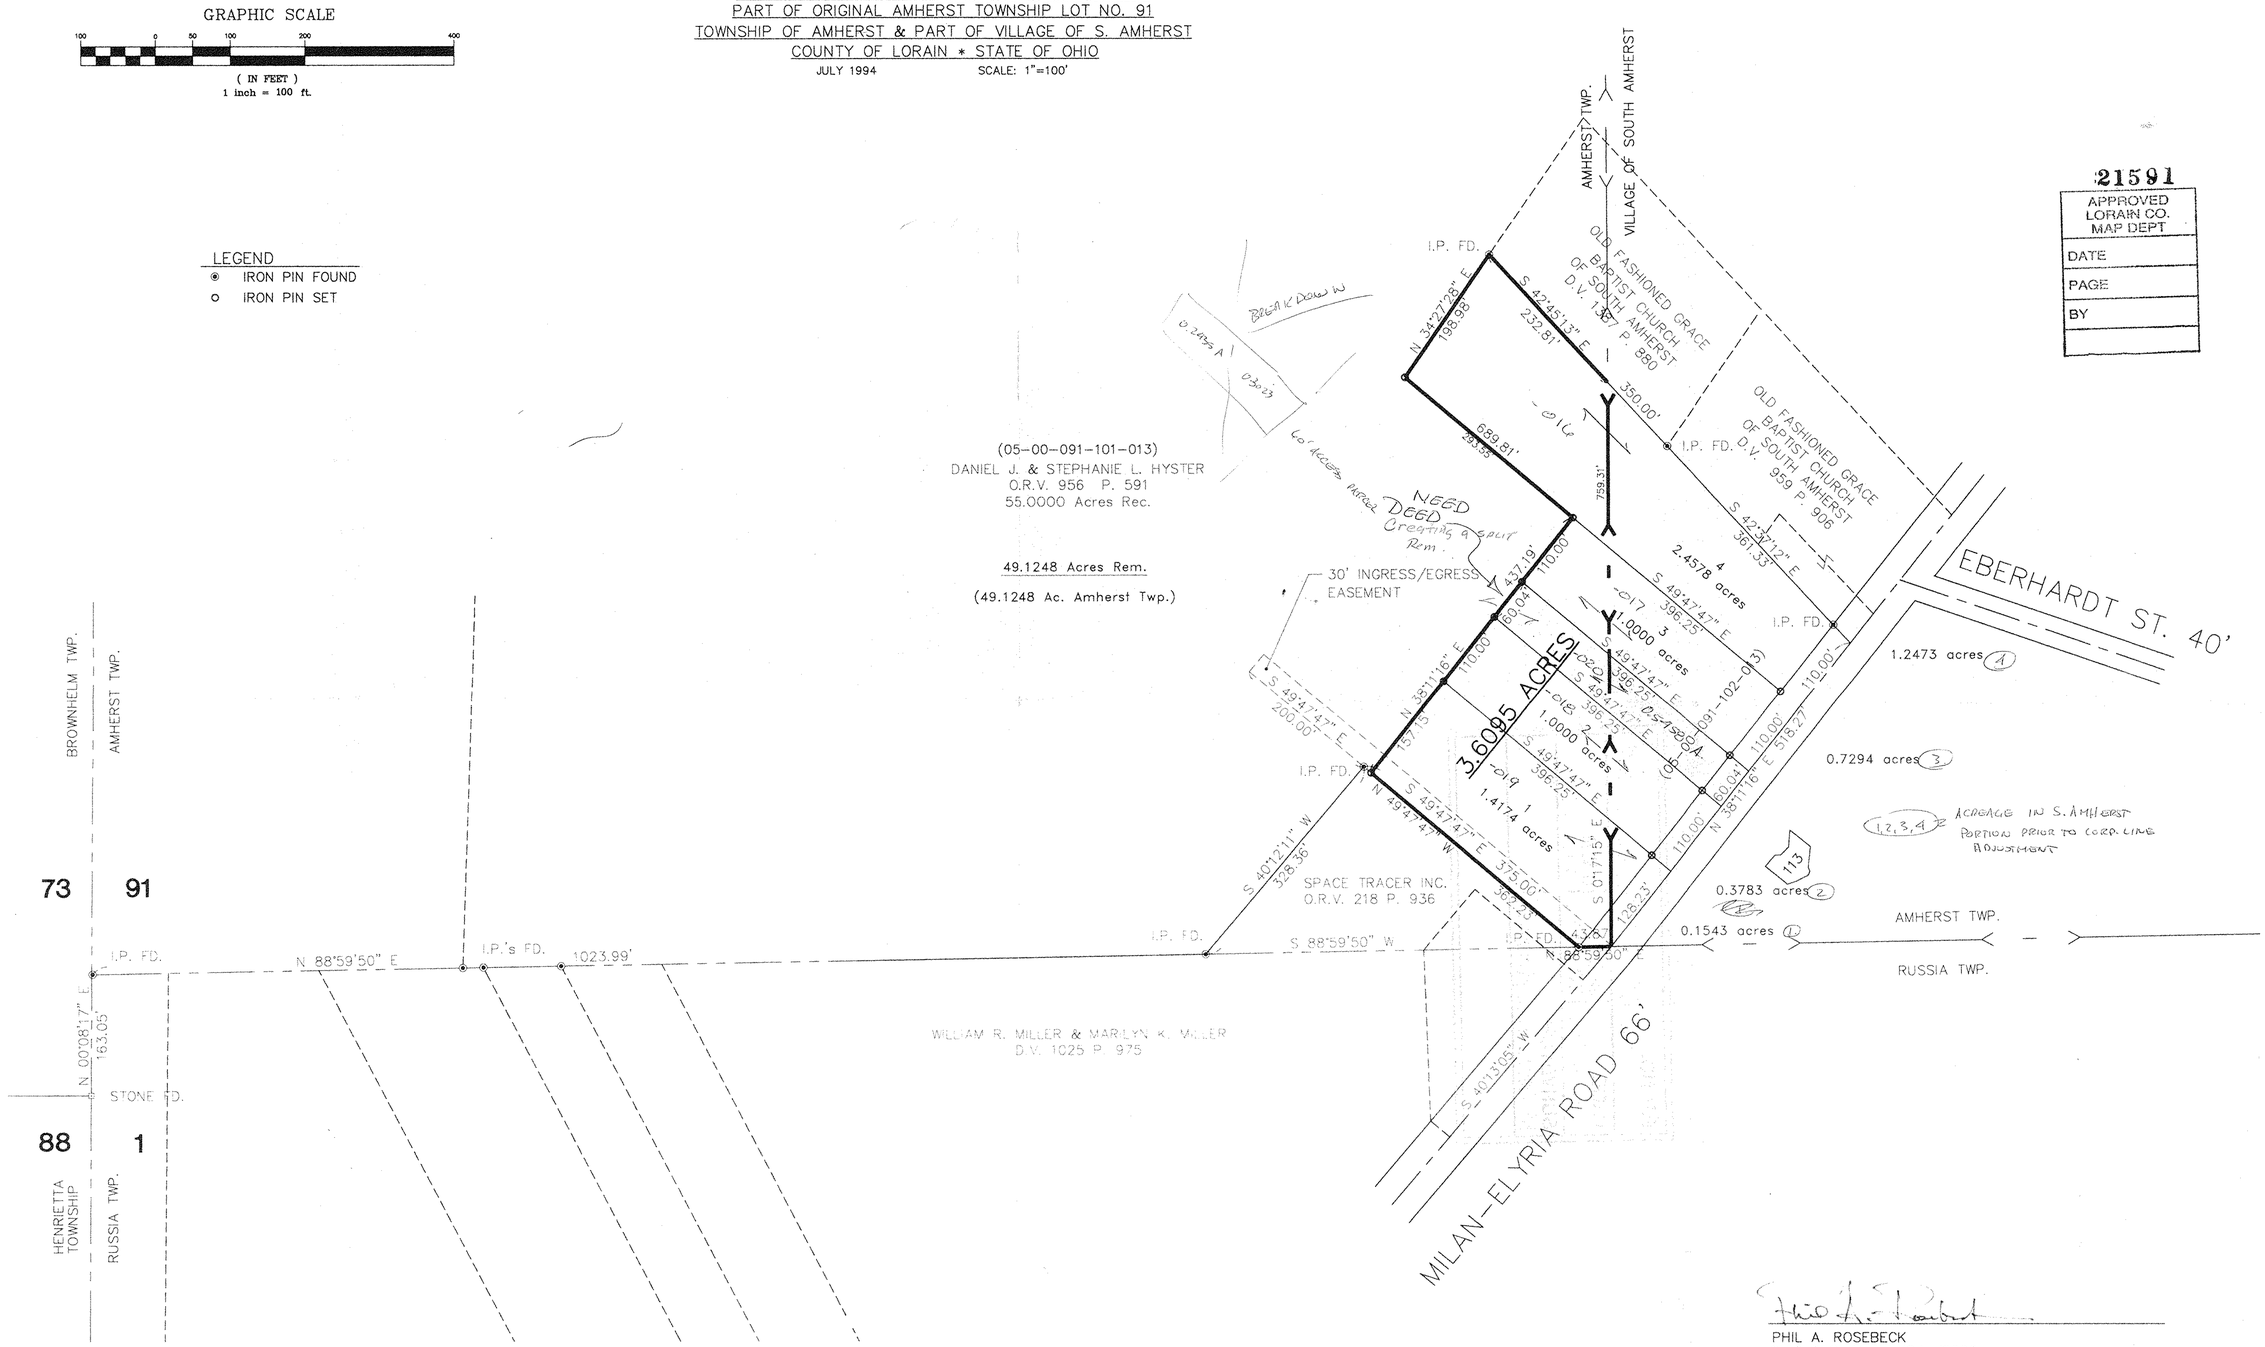

21591

APPROVED LORAIN CO. MAP DEPT
DATE
PAGE
BY

PHIL A. ROSEBECK
OHIO REG. SURVEYOR #6696

REVISION 12-13-94
REVISION 10-05-94
REVISION 11-22-94

DATE	10-05-94
DRAWN BY	PAR
CH'D BY	PAR
F.B.	XXX
DWG. NAME	91543\DWGS

KS ASSOCIATES, INC.
ENGINEERS/SURVEYORS
424 Middle Avenue
P.O. Box 89
Elyria, Ohio 44036
ELYRIA (216) 322-6317 * LORAIN (216) 244-5757

ENGINEERS/SURVEYORS KS ASSOCIATES INCORPORATED

SHEET 1 OF 1

JOB NO. 94468