

**ACREAGE CORRECTION**

-001  
THE SPORTSMAN GUN  
& REEL CLUB INC.  
V.1329 P.169


-006  
JOHN J. & IRENE ENGEL TRS.  
O.R.V. 845 P.163

EUGENE & ELIZABETH GARGASZ  
V.1222 P.125

-013  
DUANE L. & JACQUELINE K. THOMPSON  
O.R.V. 1009 P.76

-004  
OLGA ENGEL  
D.V. 1348 P.8

EDGAR C. KADARBAUGH  
V.1254 P.269

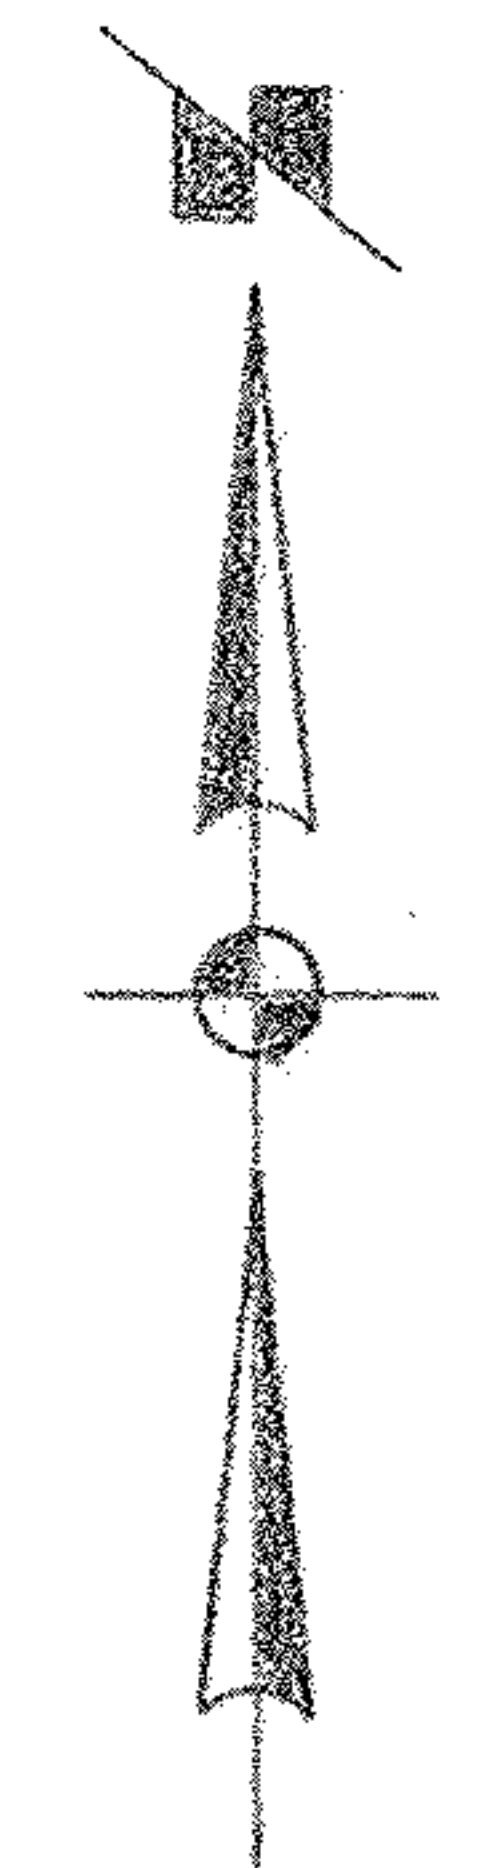

REVISED FOR ROBERT DEITRICH  
FEB. 1995 94-2681 18.6658 AC.

05-00-077-000-

**21725-A**  
APPROVED  
LORAIN CO.  
MAP DEPT  
DATE 4-3-96  
PAGE 5-D  
BY CAROLYN  
FRANKS  
#21725-A

SURVEY FOR  
**DUANE & JACQUELINE THOMPSON**

PART OF O.L.77 TOWNSHIP OF AMHERST  
COUNTY OF LORAIN STATE OF OHIO  
SCALE 1"=200' OCT. 1994

LAUNOON • SIMON • CAHL & ASSOC.  
ENGINEERS SURVEYORS

94-2633 F.B. 233 P.50

REV. 1-08-96 Add 18.6383 Pct.

301

