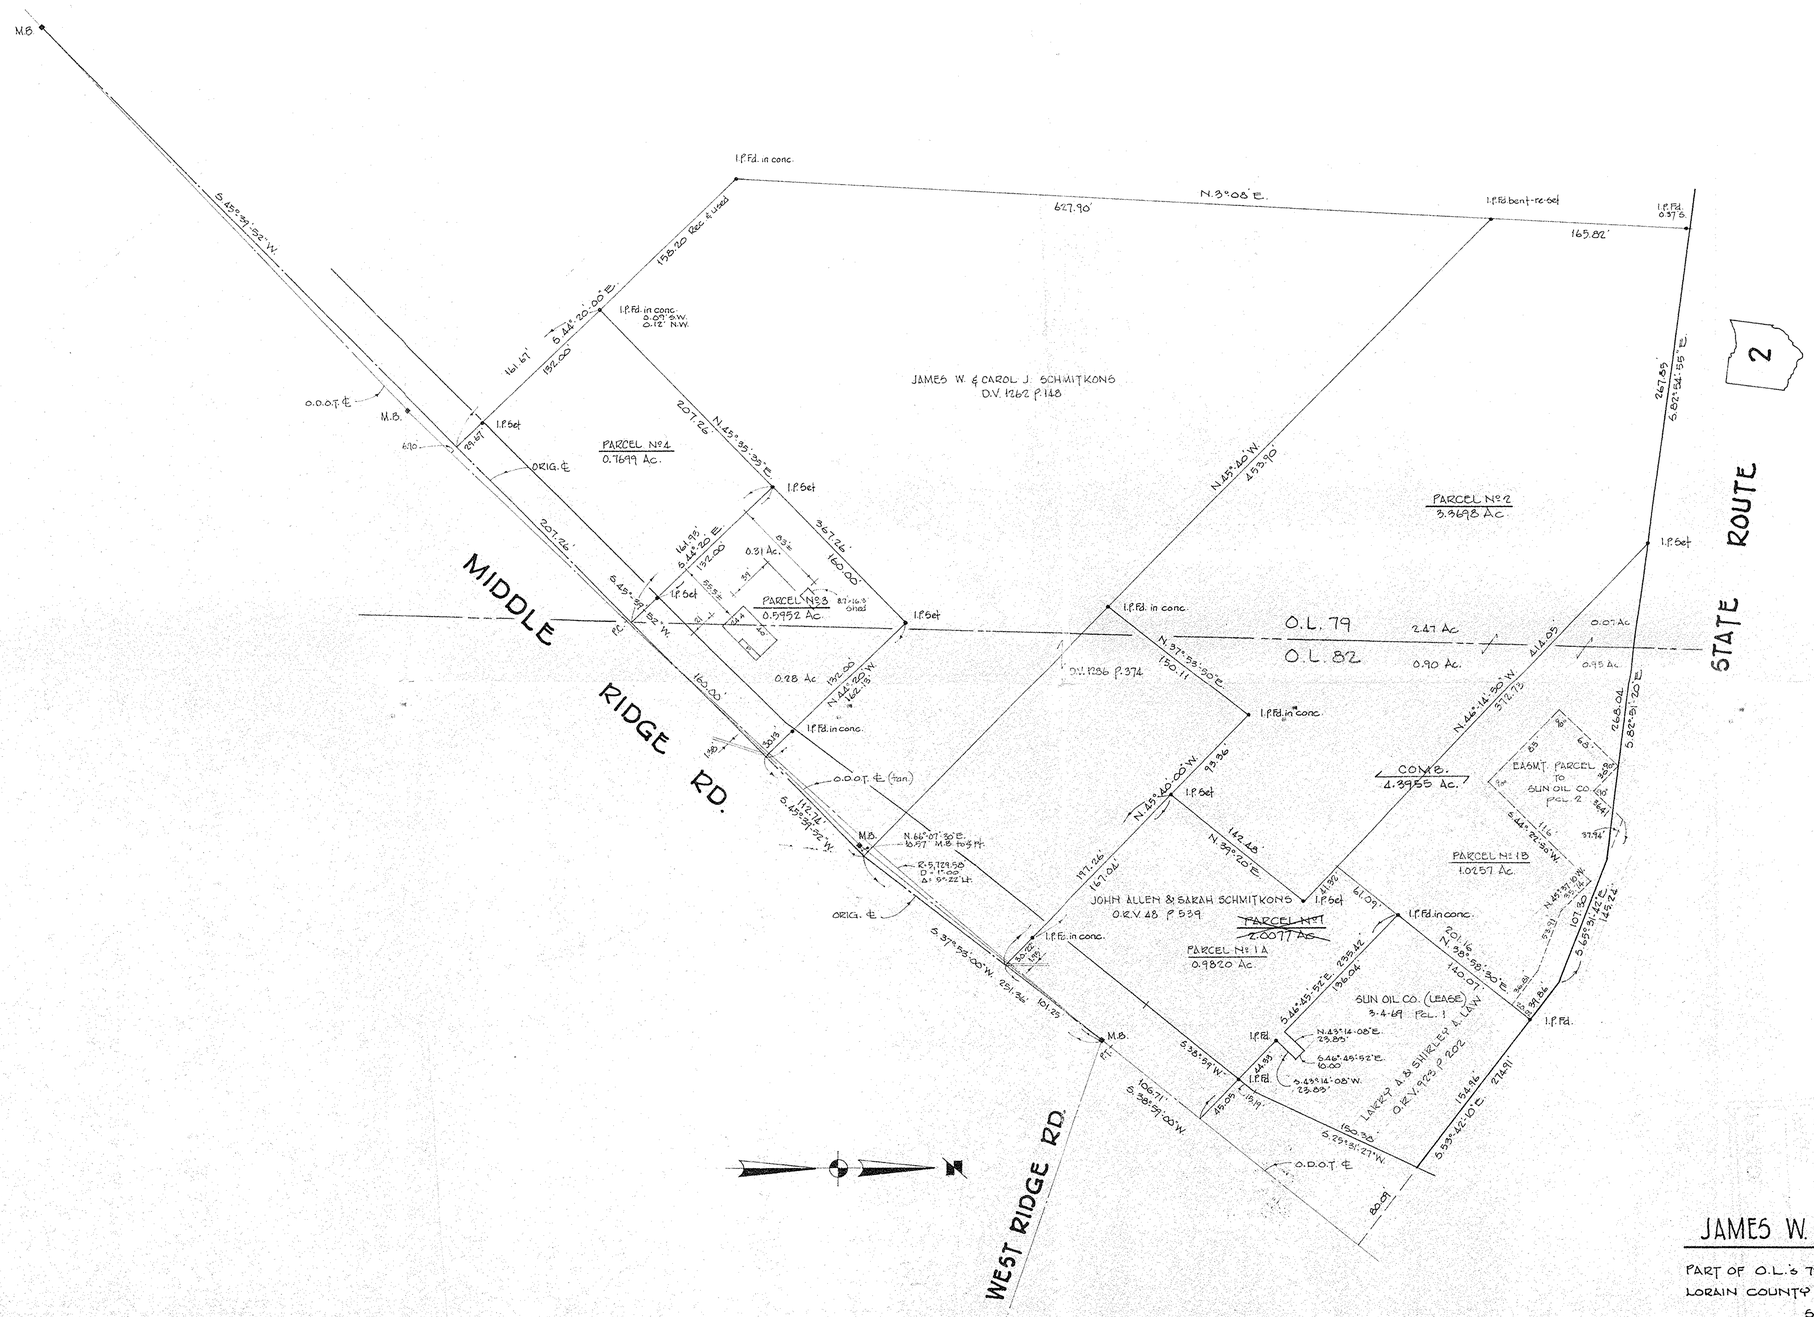

REV. 6-27-96 Split Pcl. No 1 R.G.S.
COMBINE PCL's 1B & 2

#21991

APPROVED
LORAIN CO.
MAP DEPT.
DATE 3-10-97
PAGE 5-082
BY R. BELL
WORD AFTER # 21991

SURVEY FOR

JAMES W. & PAUL W. SCHMITKONS

PART OF O.L.'s 79 & 82 — AMHERST TOWNSHIP
LORAIN COUNTY — OHIO

SCALE 1" = 60 — OCT. 31, 1985

LAUNDON - SIMON - CAHL & ASSOC.
ENGINEERS — SURVEYORS

Job No. 85-1429

STATE OF OHIO
RODGER G. SIMON
5101
REGISTERED SURVEYOR

193