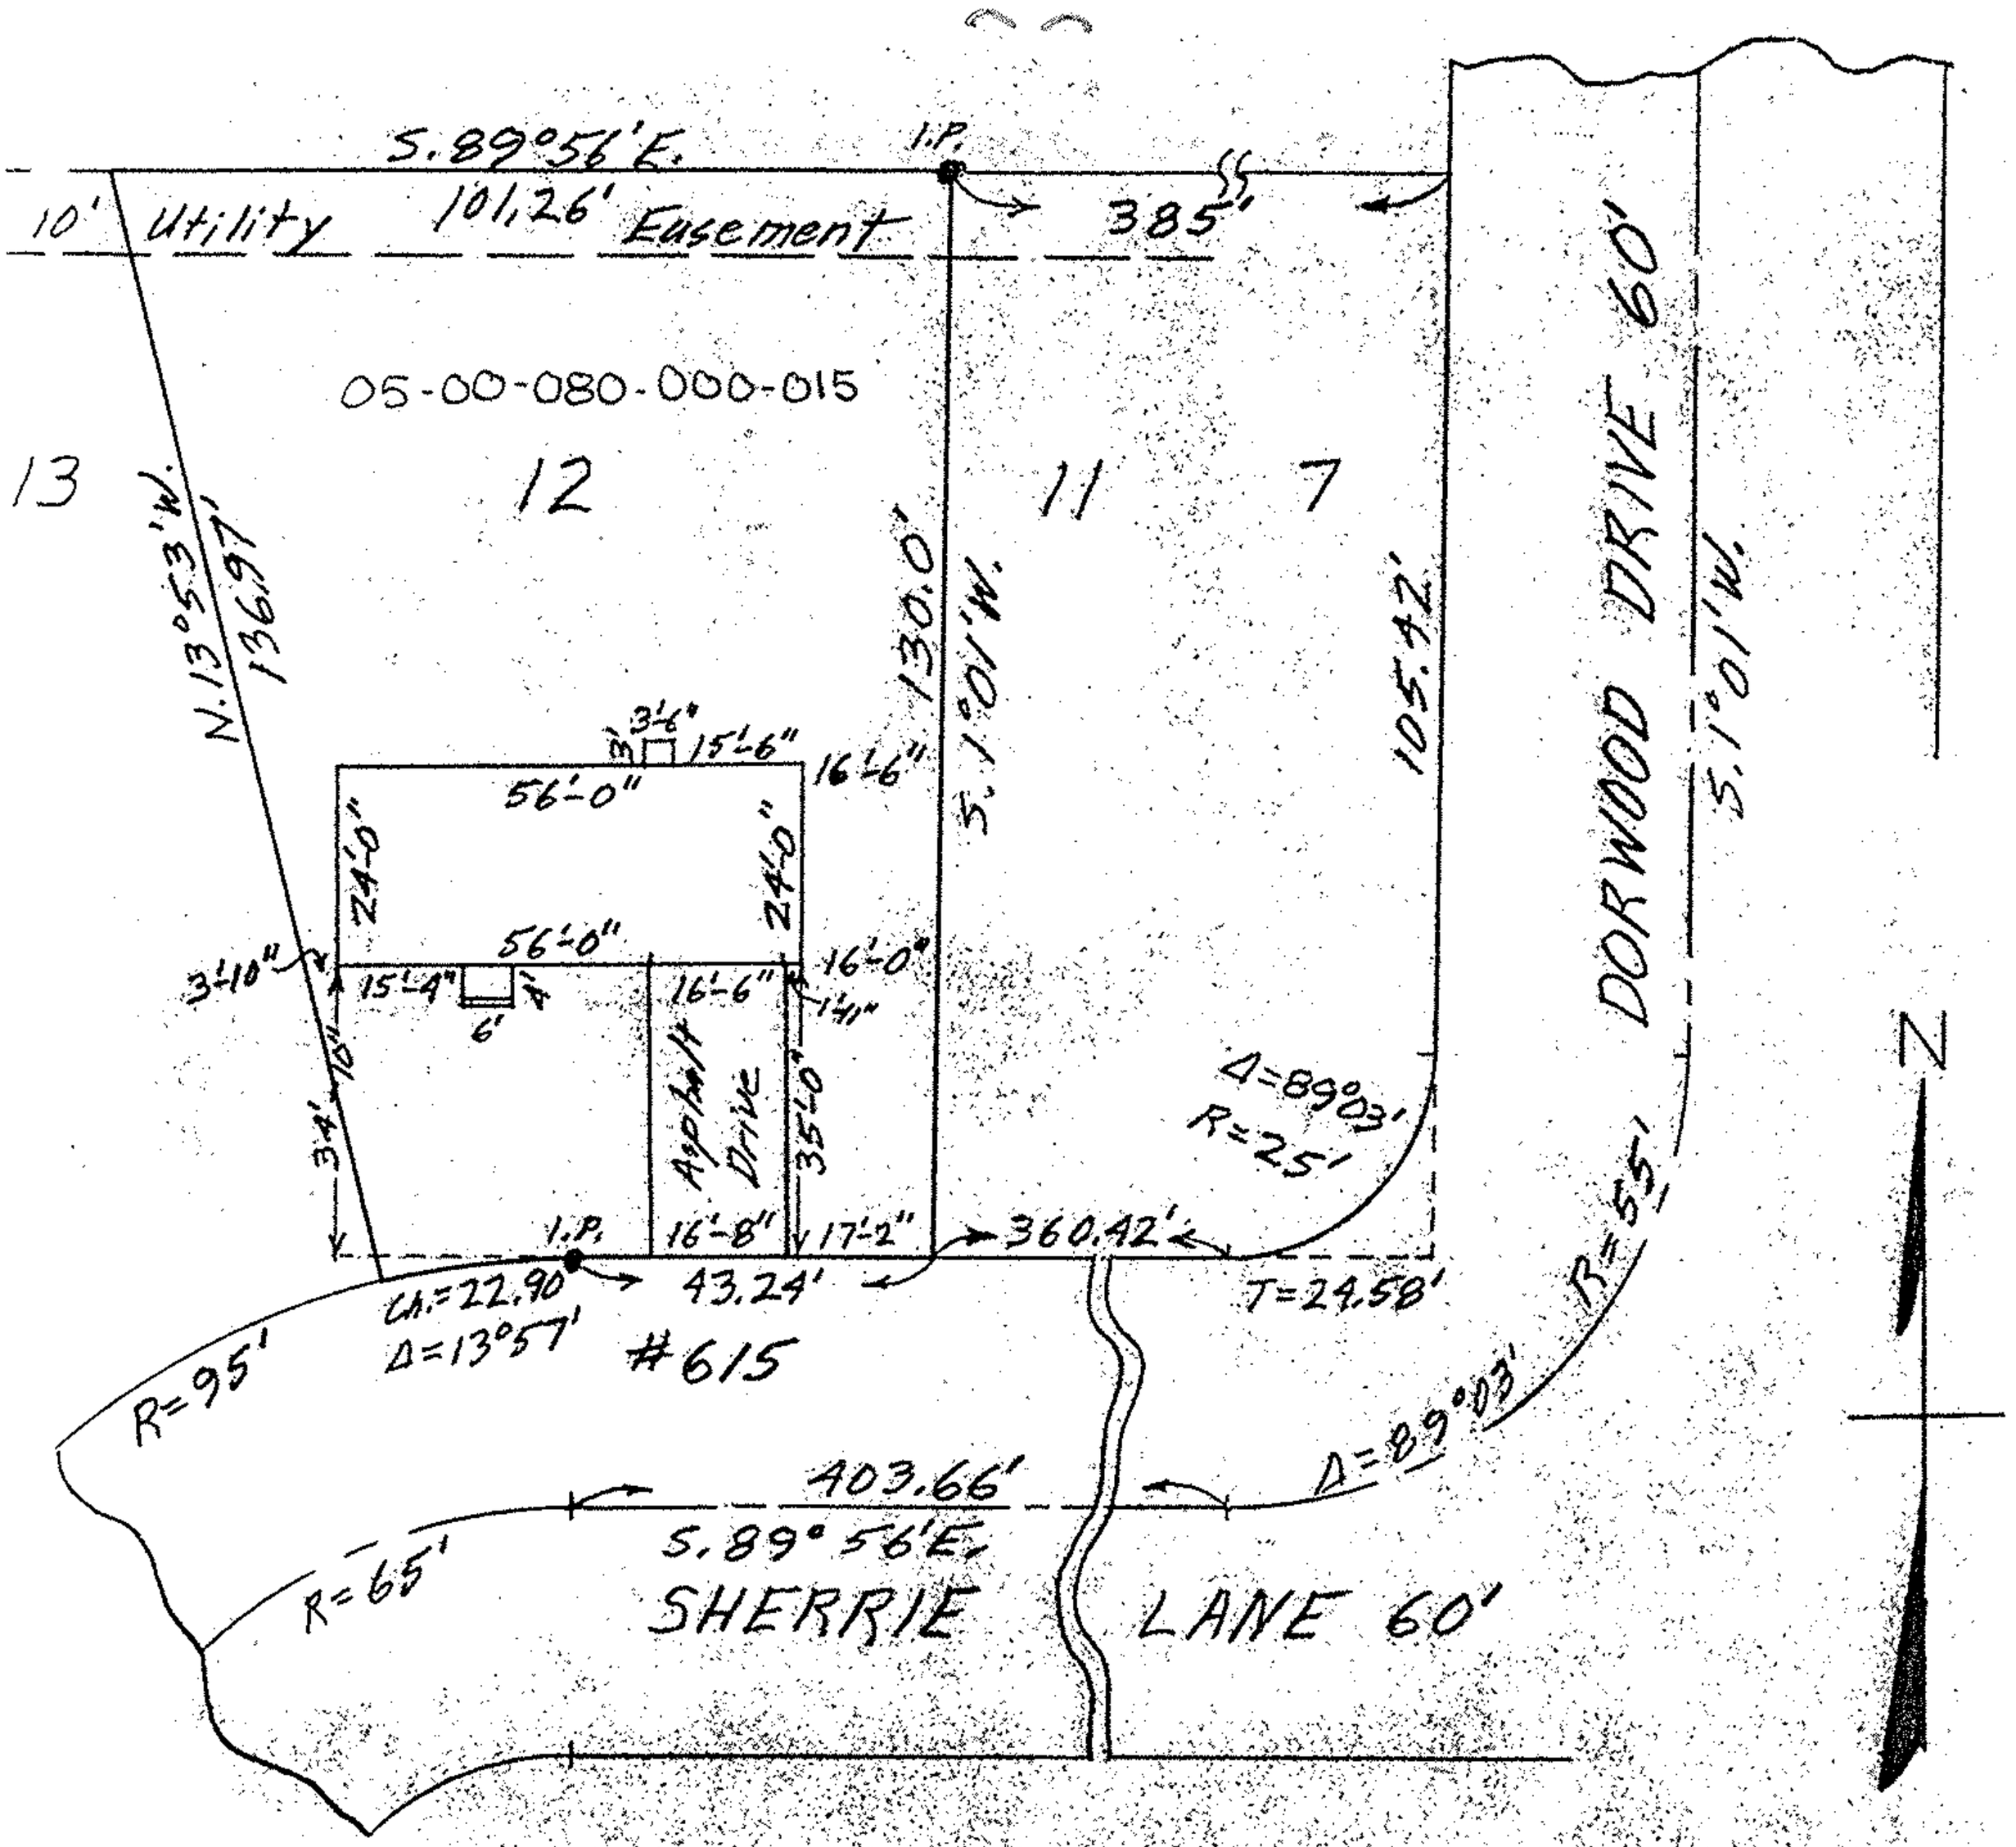

MAP OF SUB-LOT NO. 12
DORWOOD HILL ALL'T. VOL. 20 PG. 24
ORIG. LOT NO. 60 AMHERST TWP.
LORAIN COUNTY OHIO
SCALE: 1"=30' MAY 25-1965 4:00 P.M.
Gary E. Penfound REG. SURVEYOR

05-00-080-000-015

John C. & Mildred Sheridan

'C