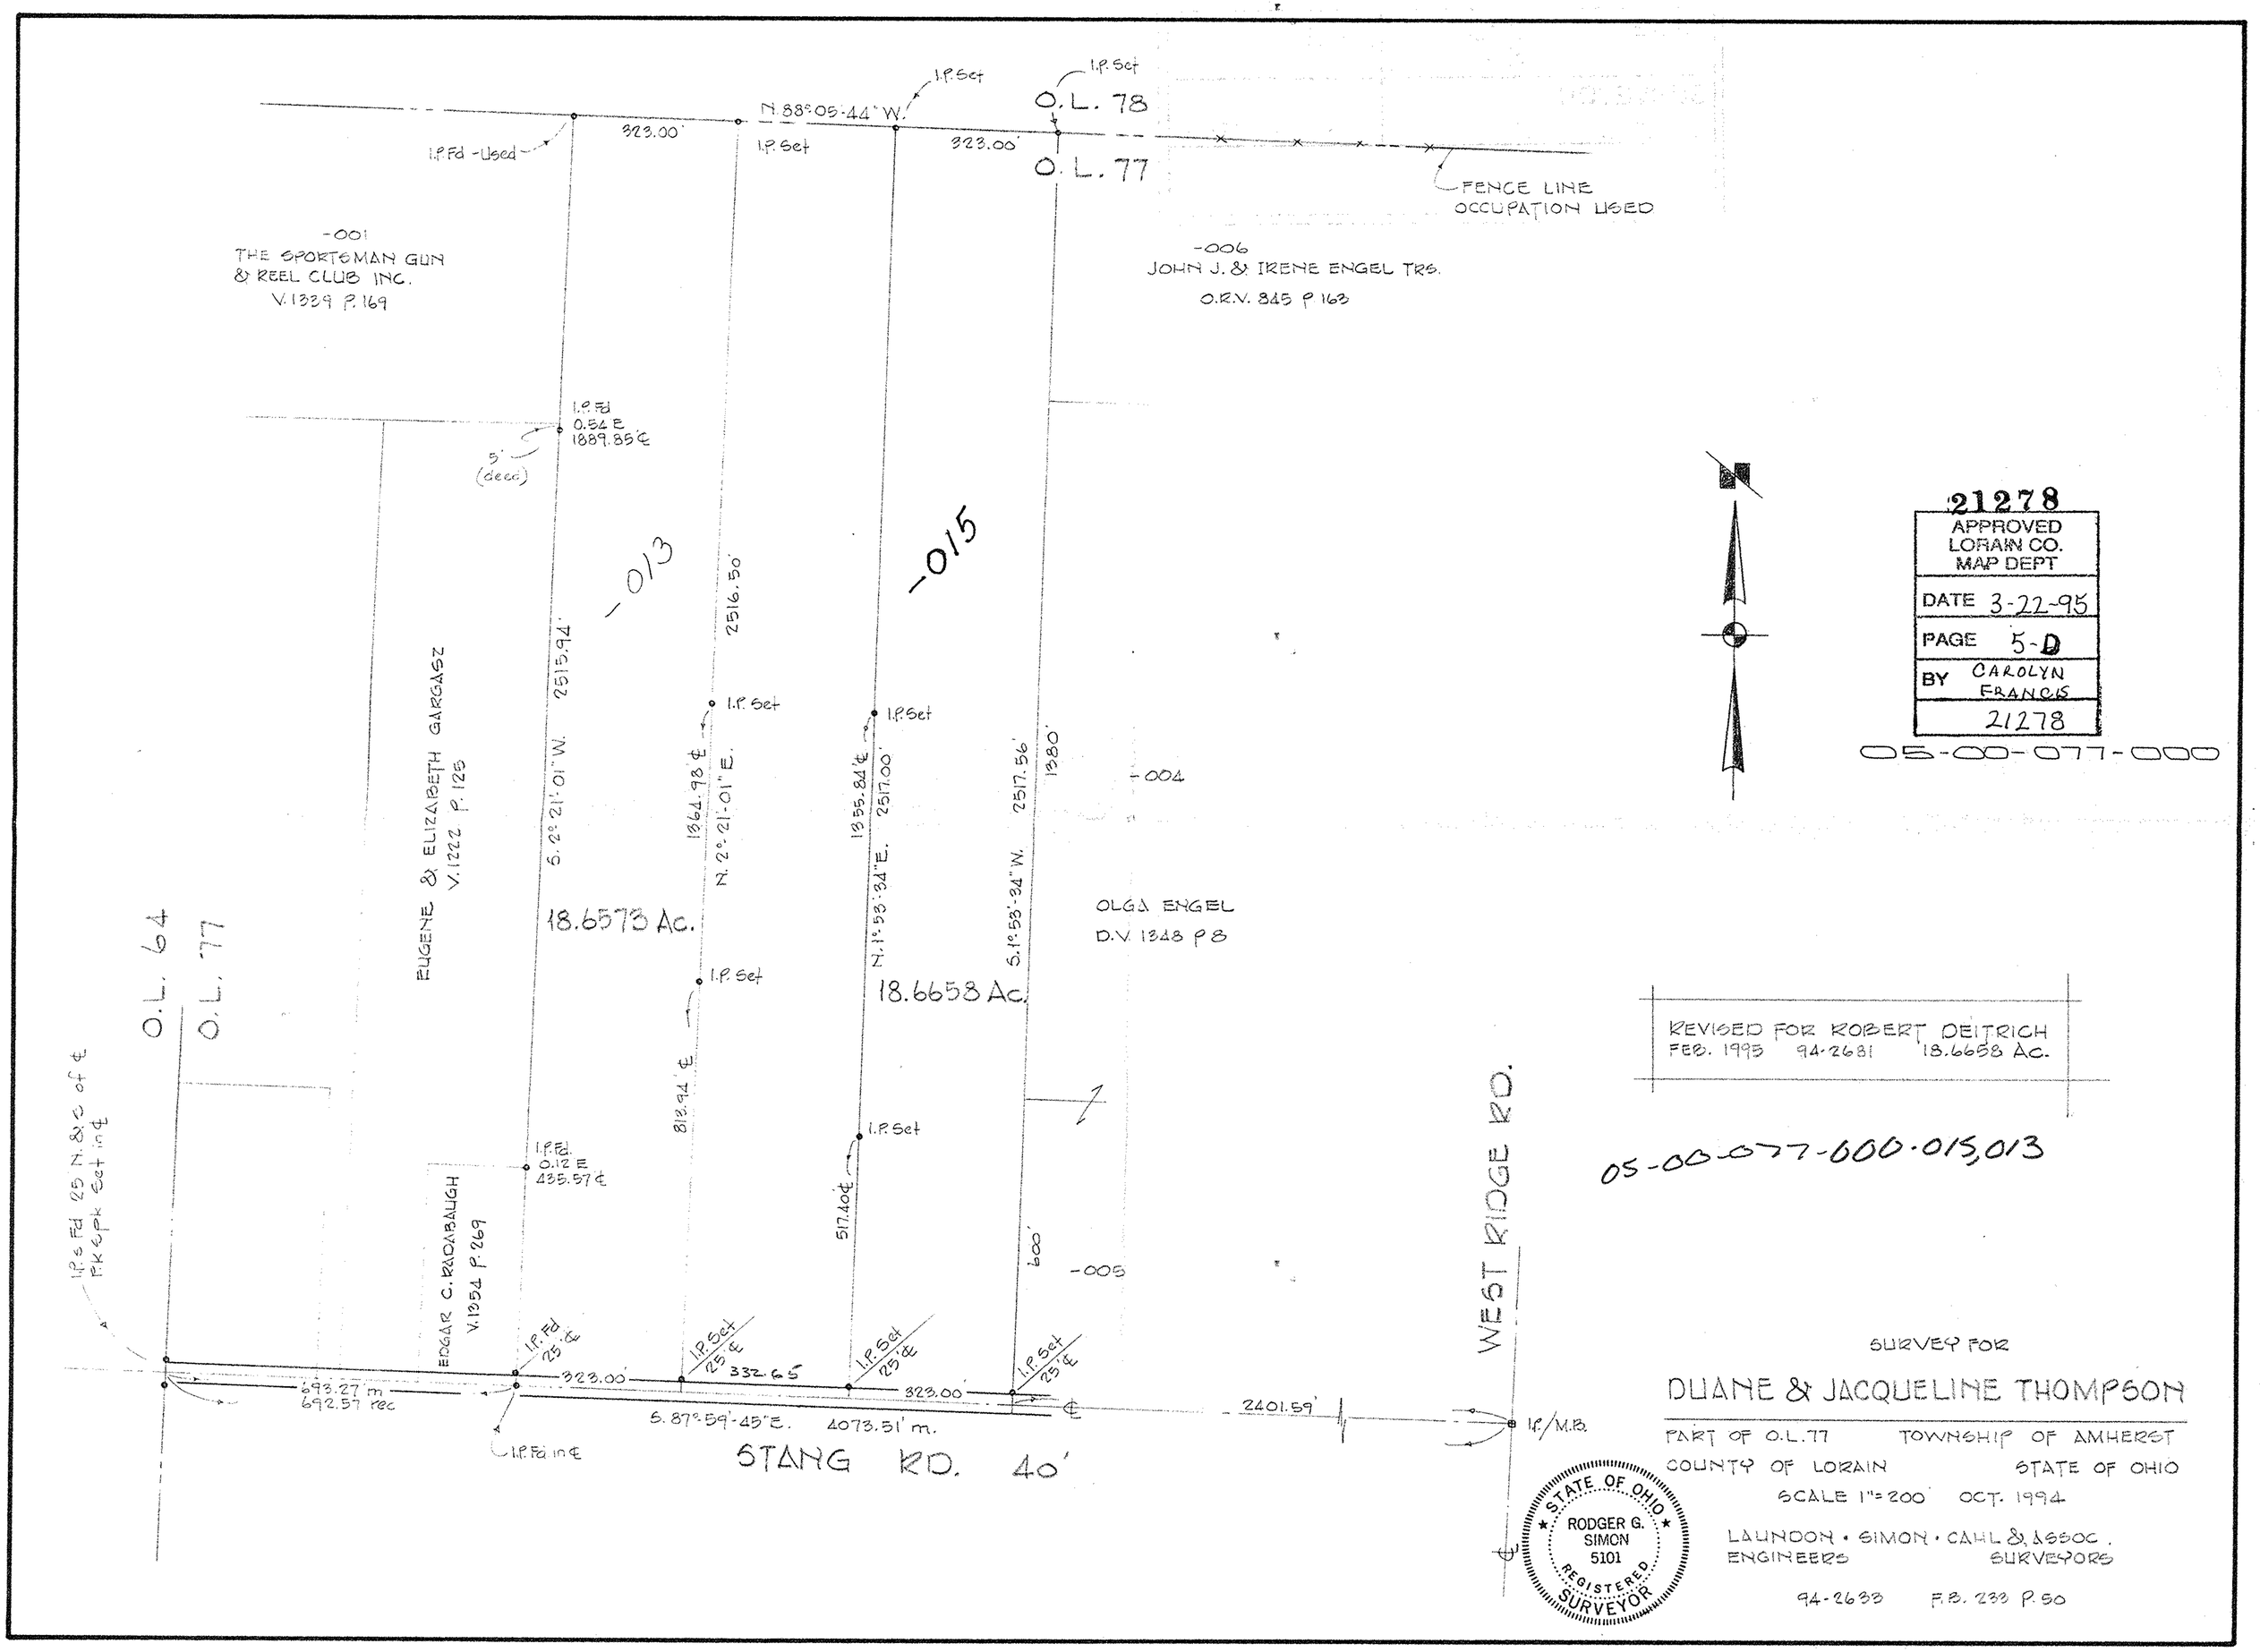

N. 88°05'44" W.
I.P. Set
O.L. 78
O.L. 77
323.00'
I.P. Fd - Used
FENCE LINE OCCUPATION USED
-001
THE SPORTSMAN GUN & REEL CLUB INC.
V.1339 P.169
-006
JOHN J. & IRENE ENGEL TRS.
O.R.V. 845 P.163
I.P. Fd 0.54 E 1889.85 ℄
5' (deed)
-013
-015
2516.50'
2515.94'
S. 2° 21' 01" W.
1364.98 ℄
N. 2° 21' 01" E.
1355.84 ℄
2517.00'
N. 1° 53' 34" E.
2517.56'
1380'
S. 1° 53' 34" W.
-004
EUGENE & ELIZABETH GARGASZ
V.1222 P.125
18.6573 Ac.
18.6658 Ac.
OLGA ENGEL
D.V. 1348 P.8
O.L. 64
O.L. 77
813.94' ℄
517.40 ℄
600'
-005
I.P. Fd 0.12 E 435.57 ℄
EDGAR C. RADABAUGH
V.1354 P.269
I.P. Fd 25' ℄
I.P. Set 25' ℄
332.65
693.27' m
692.57 rec
323.00'
S. 87° 59' 45" E.
4073.51' m.
2401.59'
I.P./M.B.
STANG RD. 40'
WEST RIDGE RD.
I.P. Fd in ℄
I.P. Fd 25 N. & S of ℄ P.K. Spk Set in ℄
21278
APPROVED LORAIN CO. MAP DEPT
DATE 3-22-95
PAGE 5-D
BY CAROLYN FRANCIS
21278
05-00-077-000
REVISED FOR ROBERT DEITRICH
FEB. 1995 94-2681 18.6658 Ac.
05-00-077-000-015,013
SURVEY FOR
DUANE & JACQUELINE THOMPSON
PART OF O.L. 77 TOWNSHIP OF AMHERST
COUNTY OF LORAIN STATE OF OHIO
SCALE 1"=200' OCT. 1994
LAUNDON · SIMON · CAHL & ASSOC.
ENGINEERS SURVEYORS
94-2633 F.B. 233 P.50
STATE OF OHIO
RODGER G. SIMON
5101
REGISTERED SURVEYOR