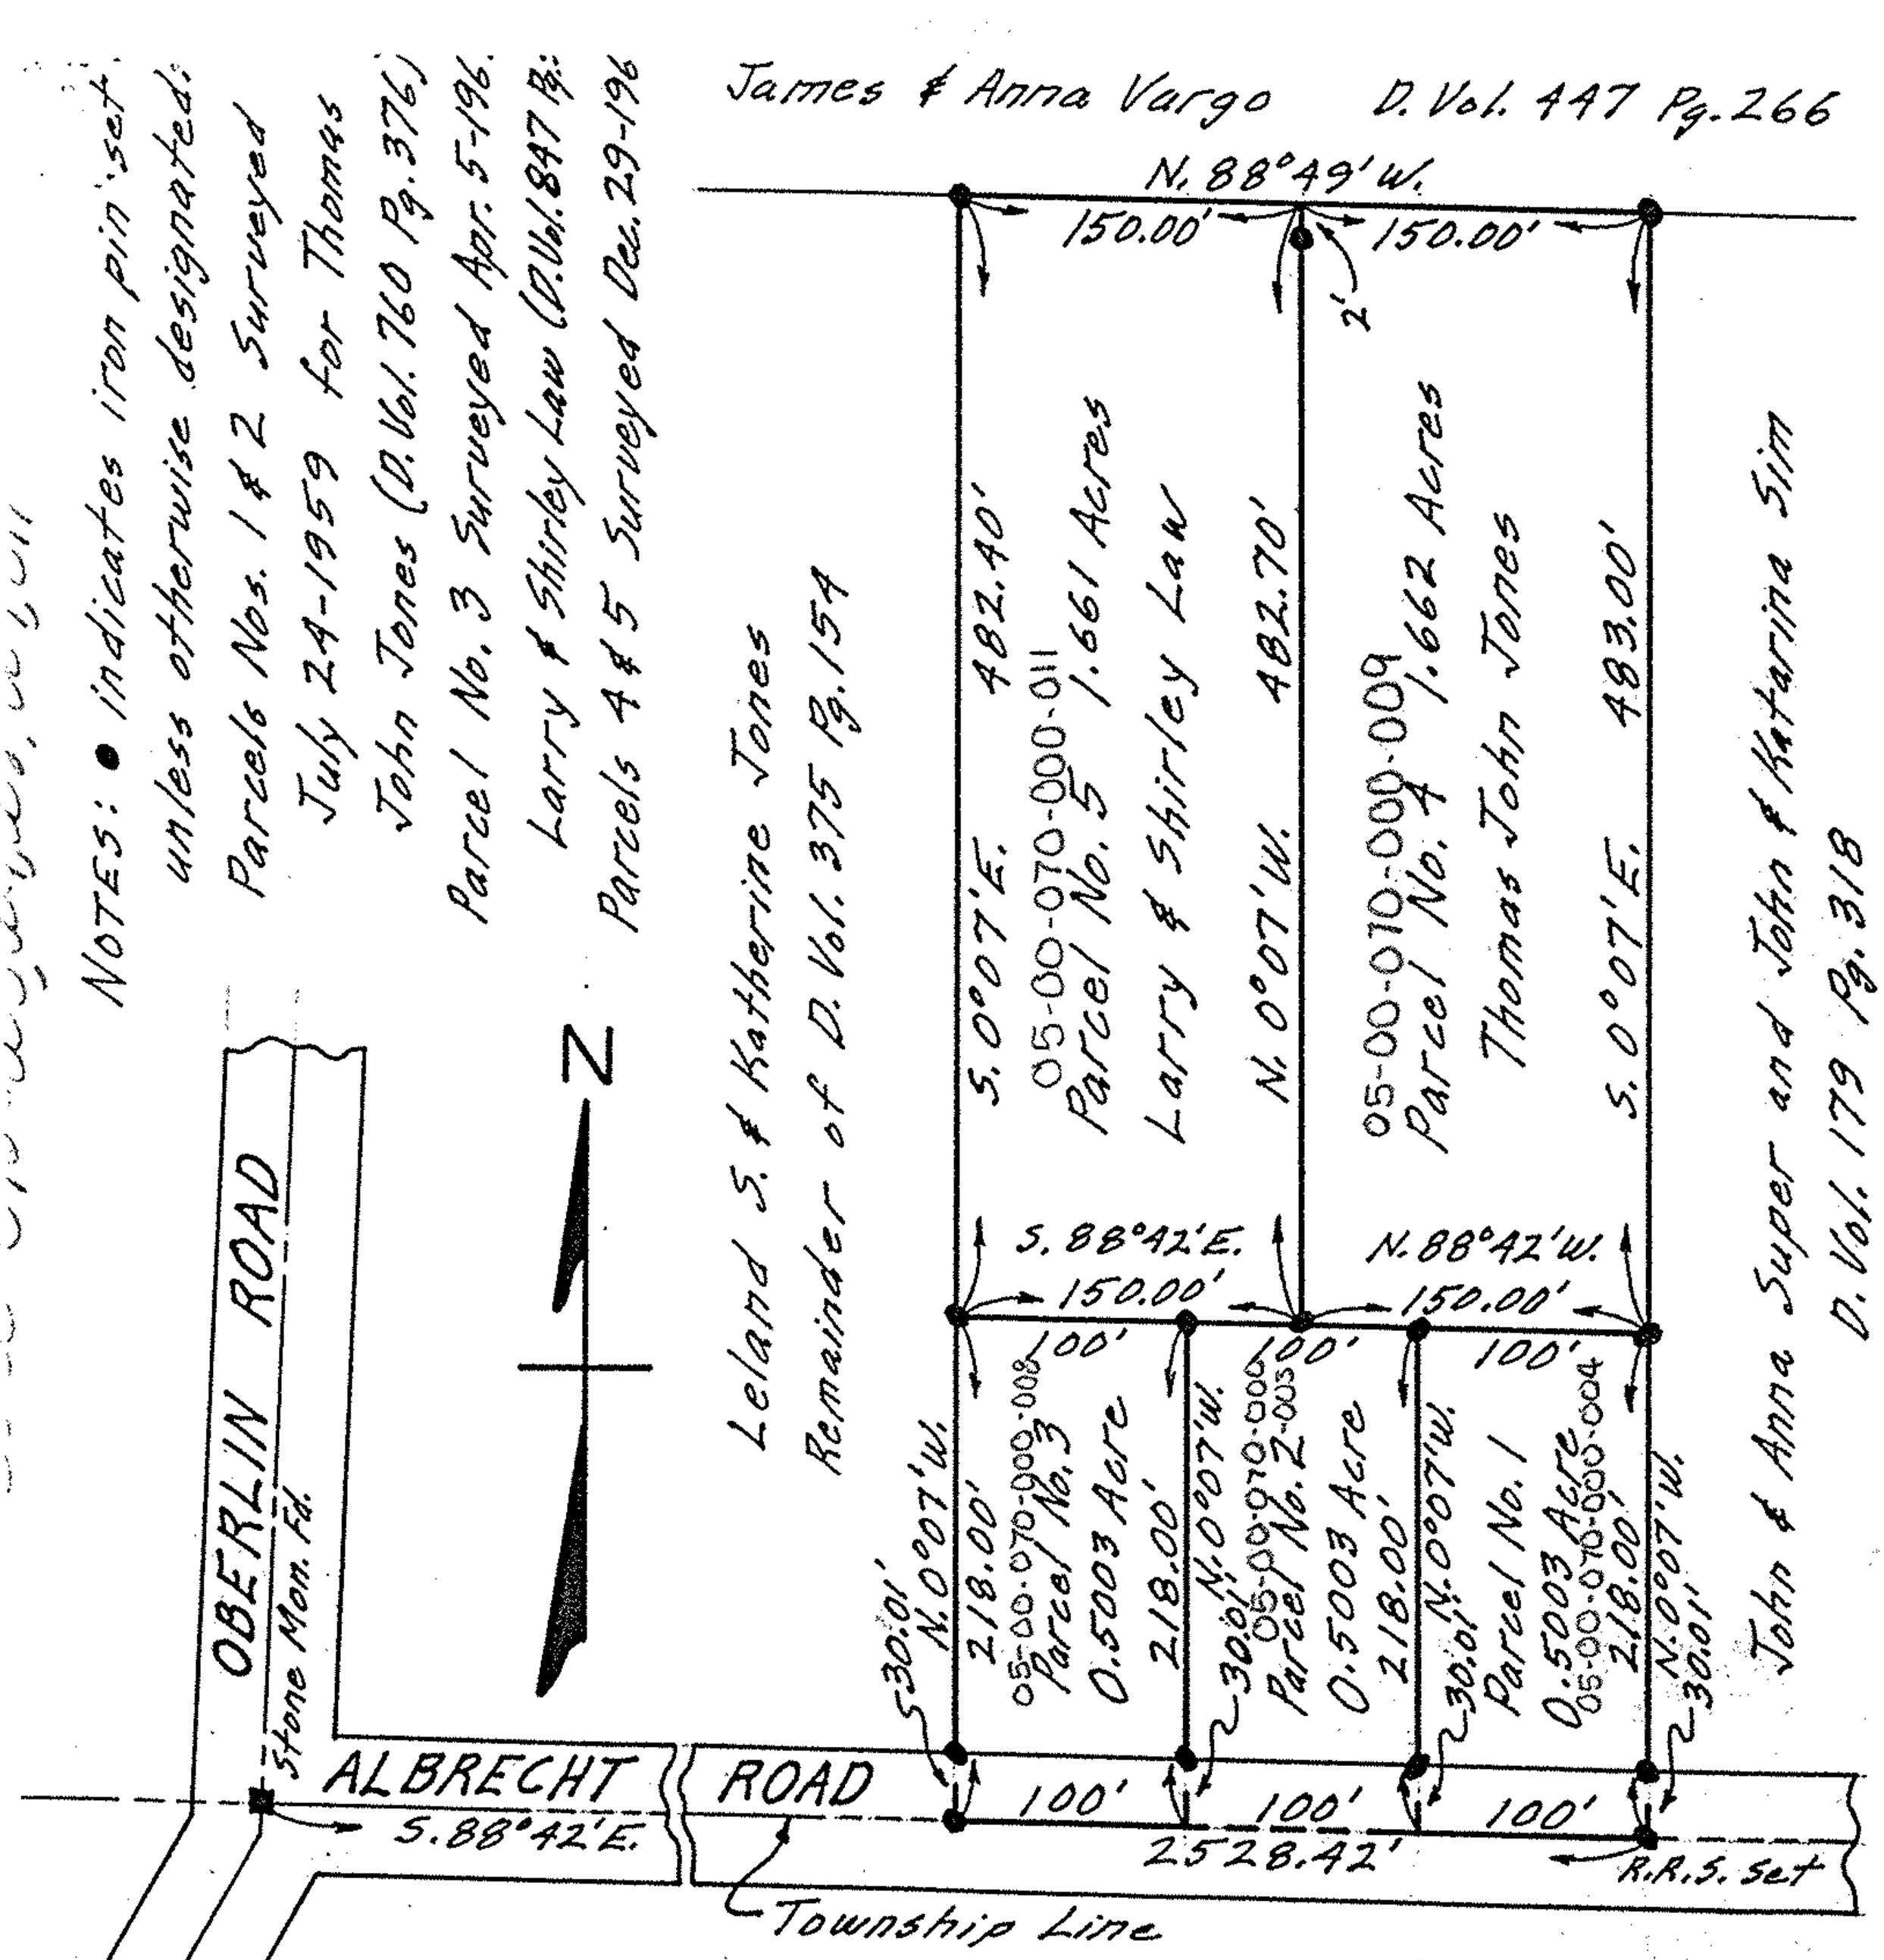

NOTES: ● indicates iron pin set unless otherwise designated.

Parcels Nos. 1 & 2 Surveyed July 24-1959 for Thomas John Jones (D. Vol. 760 Pg. 376)

Parcel No. 3 Surveyed Apr. 5-196. Larry & Shirley Law (D. Vol. 847 Pg.

Parcels 4 & 5 Surveyed Dec. 29-196

PLAT OF SURVEYS FOR THOMAS JONES AND LARRY LAW

ORIGINAL LOT 70 AMHERST TWP.

LORAIN COUNTY OHIO

SCALE: 1" = 100'

Gary E. Penfound – Reg. Surveyor No. 4457