
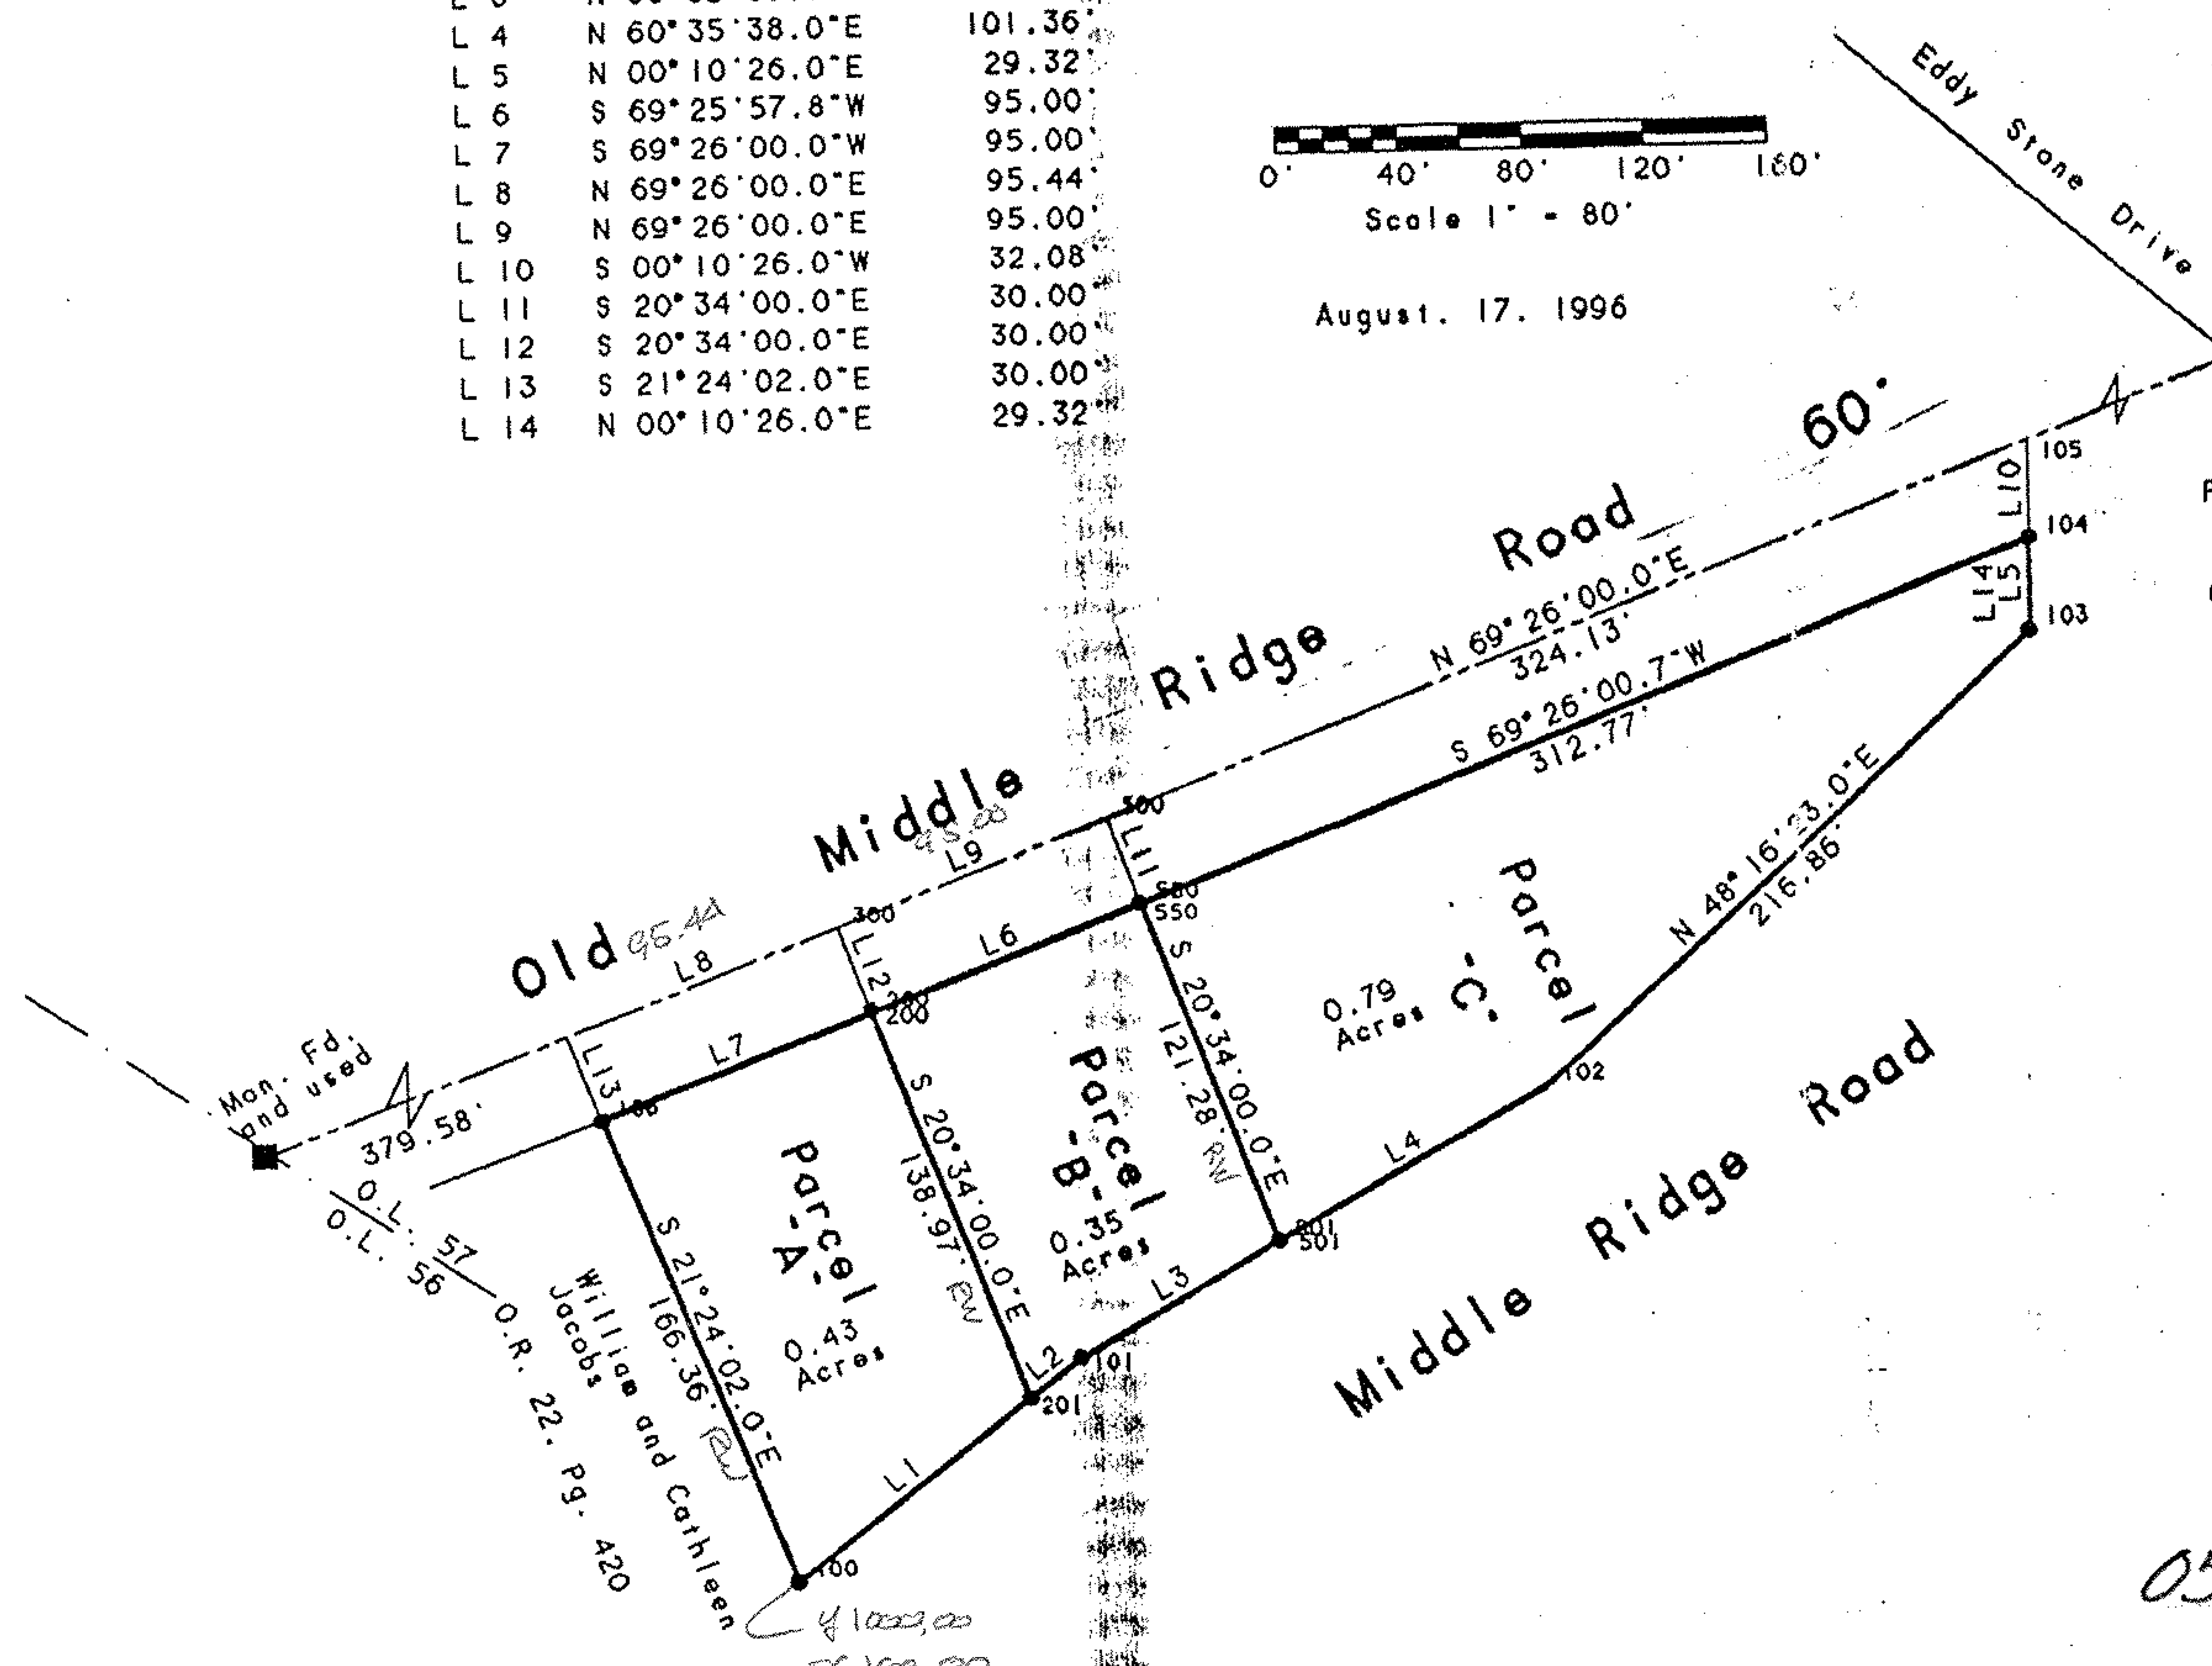


LINE	BEARING	DISTANCE
L 1	N 52° 57' 34.0"E	96.54
L 2	N 52° 57' 34.0"E	21.70
L 3	N 60° 35' 38.0"E	75.08
L 4	N 60° 35' 38.0"E	101.36
L 5	N 00° 10' 26.0"E	29.32
L 6	S 69° 25' 57.8"W	95.00
L 7	S 69° 26' 00.0"W	95.00
L 8	N 69° 26' 00.0"E	95.44
L 9	N 69° 26' 00.0"E	95.00
L 10	S 00° 10' 26.0"W	32.08
L 11	S 20° 34' 00.0"E	30.00
L 12	S 20° 34' 00.0"E	30.00
L 13	S 21° 24' 02.0"E	30.00
L 14	N 00° 10' 26.0"E	29.32

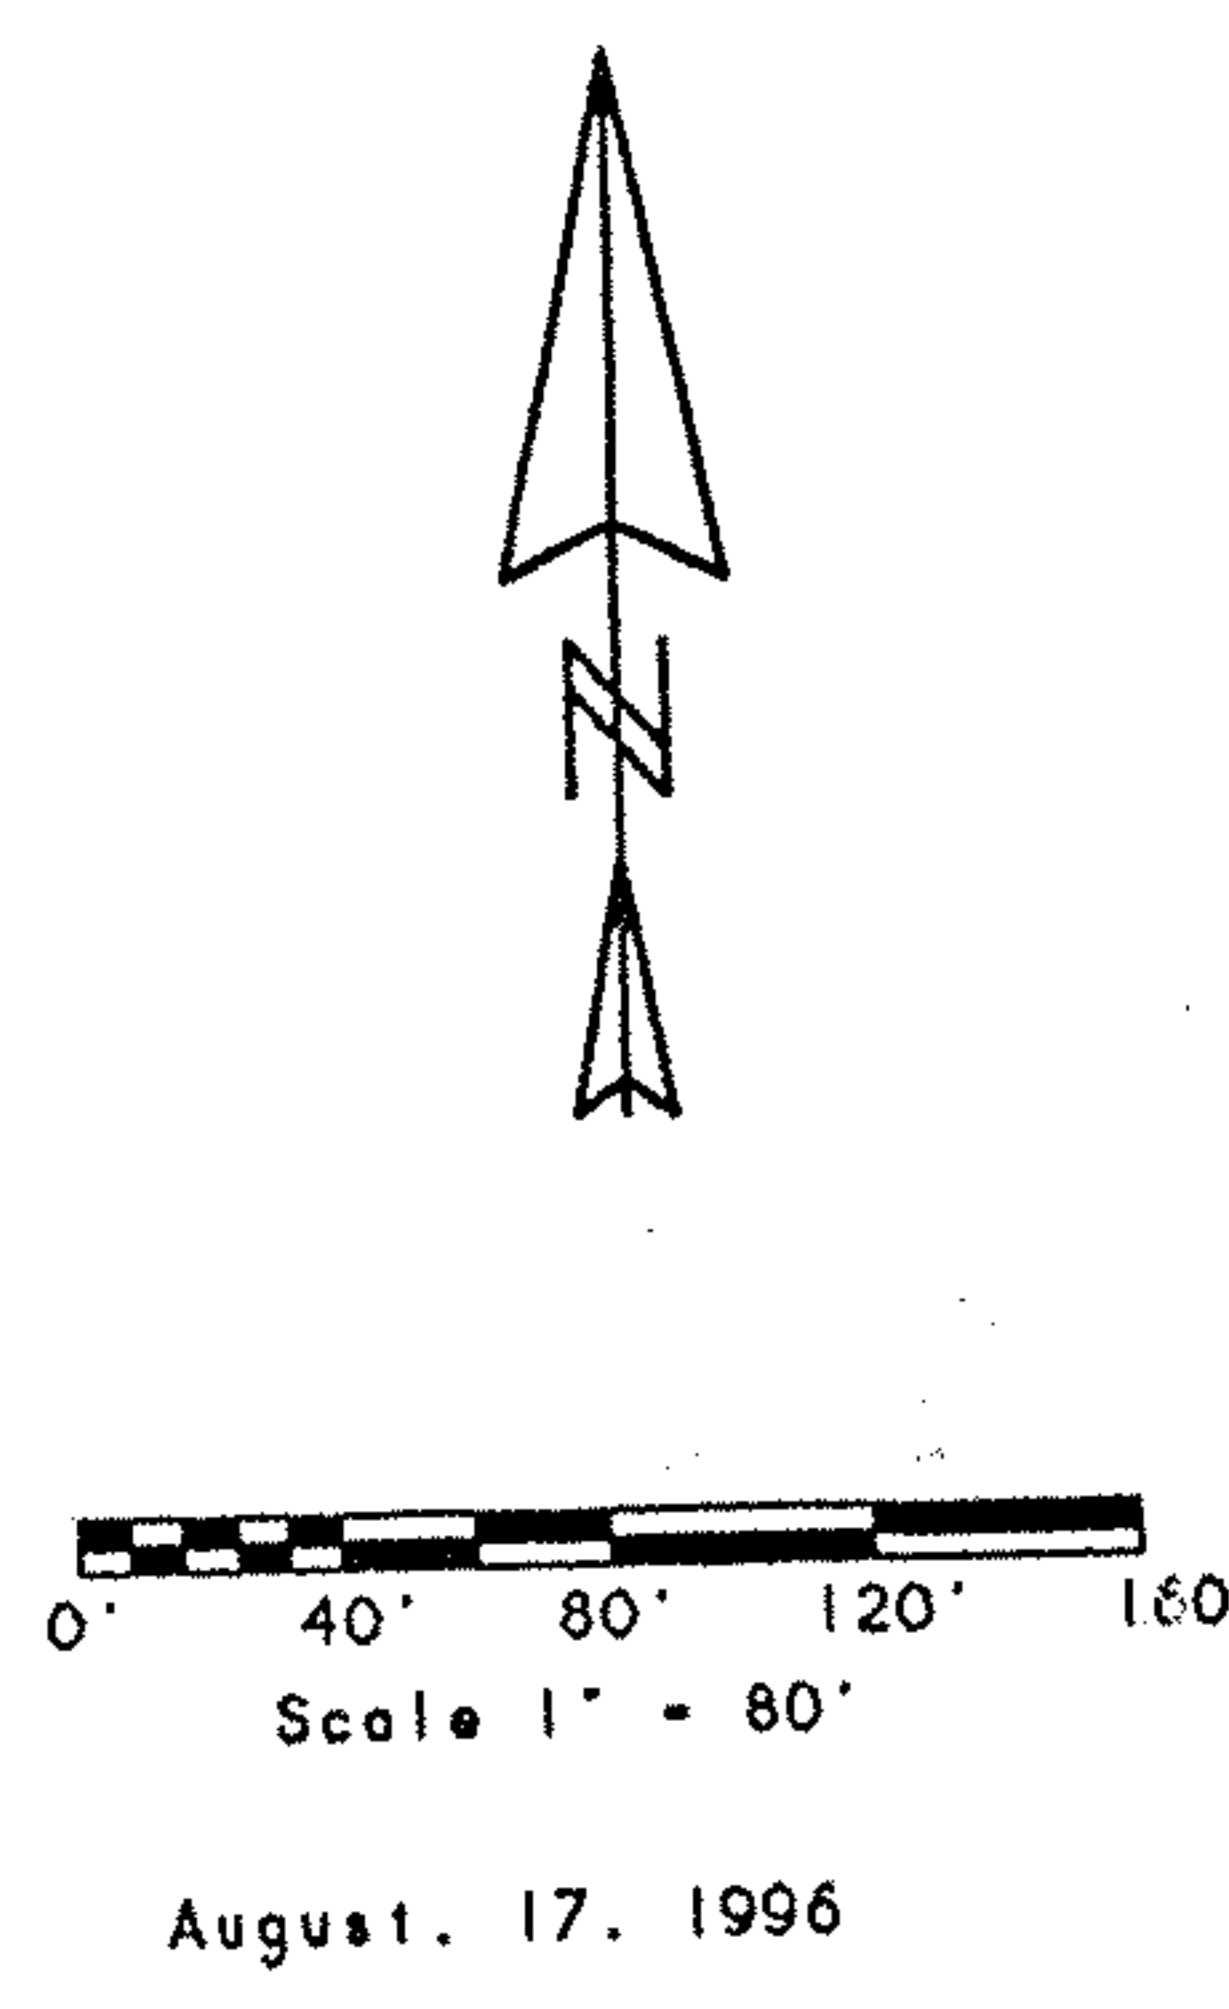

POINT	NORTHING	EASTING	DESCRIPTION
100	1000.00000	100.00000	I.P. Found
01	1071.22543	104.38027	I.P. Set
102	1157.85688	1248.08800	I.P. Set
103	1302.19487	1409.93609	I.P. Set
104	1331.51473	1410.02508	I.P. Set
105	1363.59458	1410.12244	
106	1154.89206	939.29673	I.P. Found
107	1182.82753	928.34863	
108	1049.48221	52.96151	Monument Found
200	1188.26528	109.24182	I.P. Set
201	1058.15497	107.06070	I.P. Set
00	1216.35415	107.70255	
500	1249.72736	1106.64764	
501	1108.09166	1159.79098	
550	1221.63944	1117.18655	I.P. Set
752	1195.14874	105.68028	300
1000	1049.48221	52.96151	Monument found

Note: Only copies th Red Ink shall be consid.  
*Patrick A. McGannon*  
 Patrick A. McGannon 54

Prepared for Edward J. Gargasz  
 of 7100 Hidden Valley Drive  
 Amherst, Ohio 44001

Being known as Part of Original Lot 57  
 of Amherst Township in  
 County of Lorain,  
 in the State of Ohio.

Note: Bearings to an  
 assumed meridian used to  
 describe angle

## Boundary Survey

# Patrick A. McGannon

### Registered Professional Surveyor

1731 Gettysburg Drive, Lorain, Ohio Phone (216)-282-2712