PARENT PARCEL: 04-00-013-000-097

CHILD PARCEL: 04-00-013-000-207, 208

STARTING POINT: CL. OF WOOSTER - AVON LAKE RD. & CL. OF MILLS RD.

NO. 22522

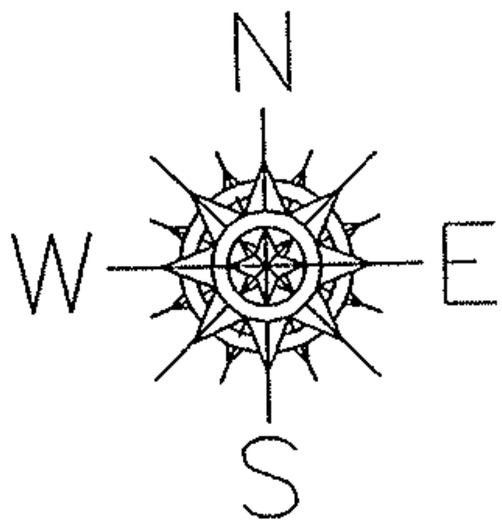

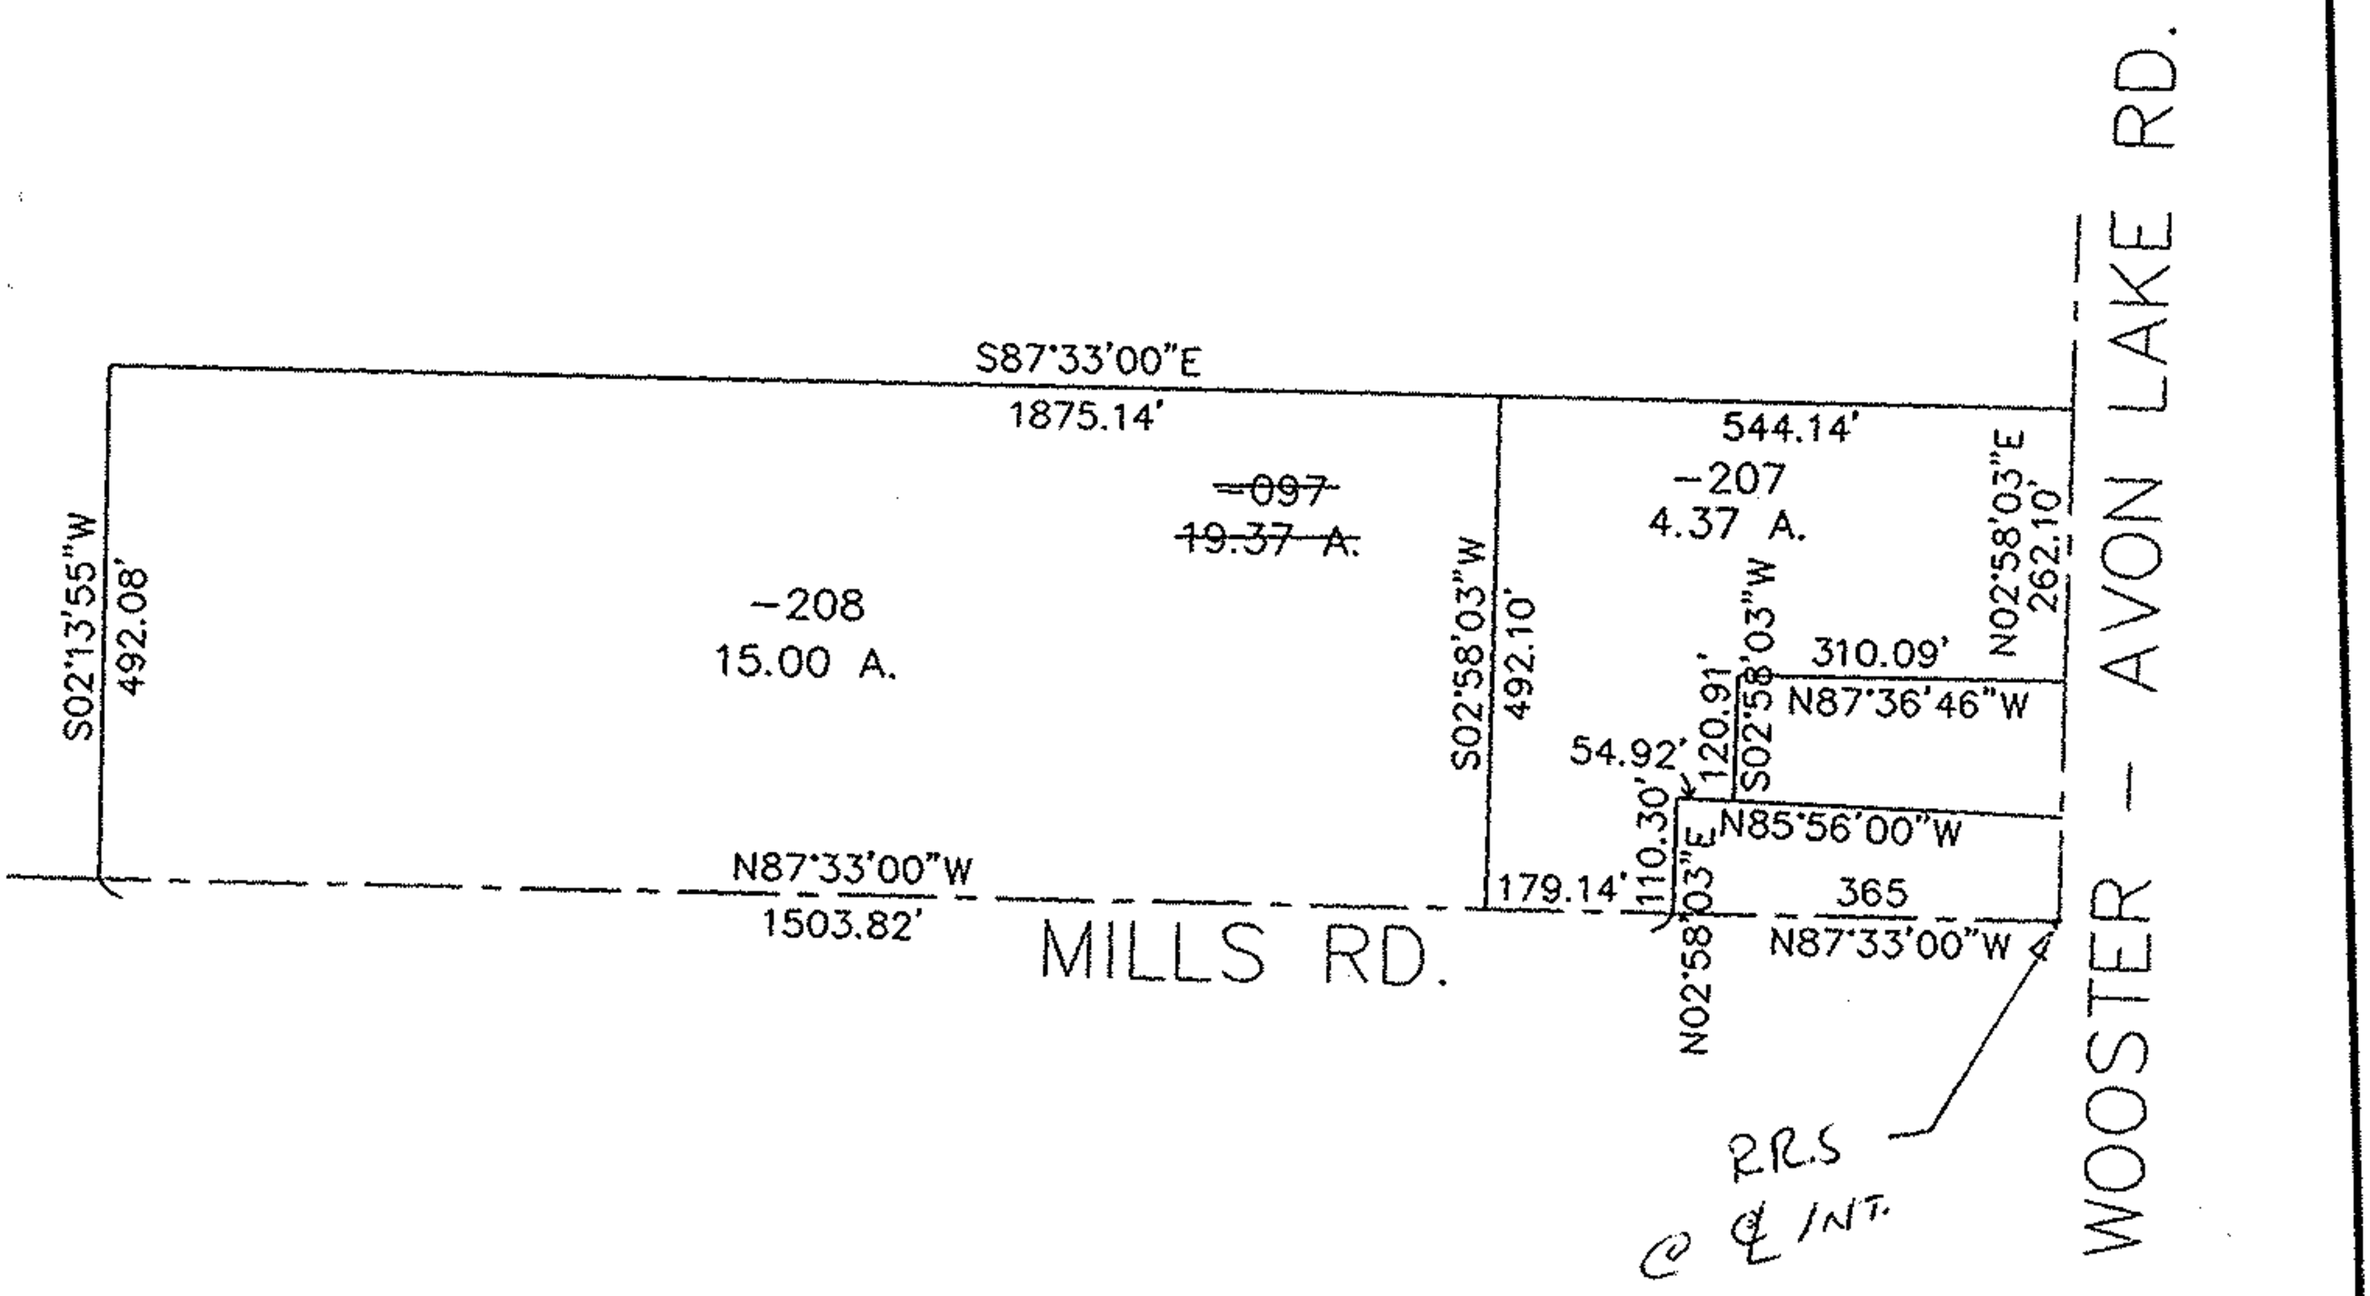

SPLITS/DEEDS PROCESSED

LORAIN COUNTY TAX MAP DEPARTMENT
226 MIDDLE AVE. ELYRIA, OHIO

SURVEYED BY: CHARLES A. KERG

CLOSURE: 0.01 : 10,000

MAP PAGE(S): 04-00-013 E & F

APPROVED BY: TJS DATE: 05/15/98

SCALE: 1"= 300 PRIOR INSTRUMENT: OR 0898/654