THE JOHN TOMCO SPLIT OF LAND
CITY OF AVON ÷ LORAIN COUNTY ÷ OHIO
PART OF ORIGINAL AVON TOWNSHIP SECTION No. 15

SCALE: 1" = 50'

JANUARY 1989

REVISED AUG 89
BUILDING LOCATION
&
REVISED SEPT. 89

MONUMENTS WERE FOUND OR SET AS SHOWN. DISTANCES ARE IN FEET AND DECIMALS. BEARINGS ARE FOR ANGLE CALCULATIONS ONLY. WE CERTIFY ALL TO BE CORRECT.

Vincent C. McGarvey

CONSULTING ENGINEERS & SURVEYORS No. 4289

N

04-00-015-109-026, 069, 071, 072

#18624

APPROVED
LORAIN CO.
MAP DEPT.
DATE 9-15-89
PAGE 4-00-015-F
BY CAROL FRANKIS
VOID AFTER # 18624

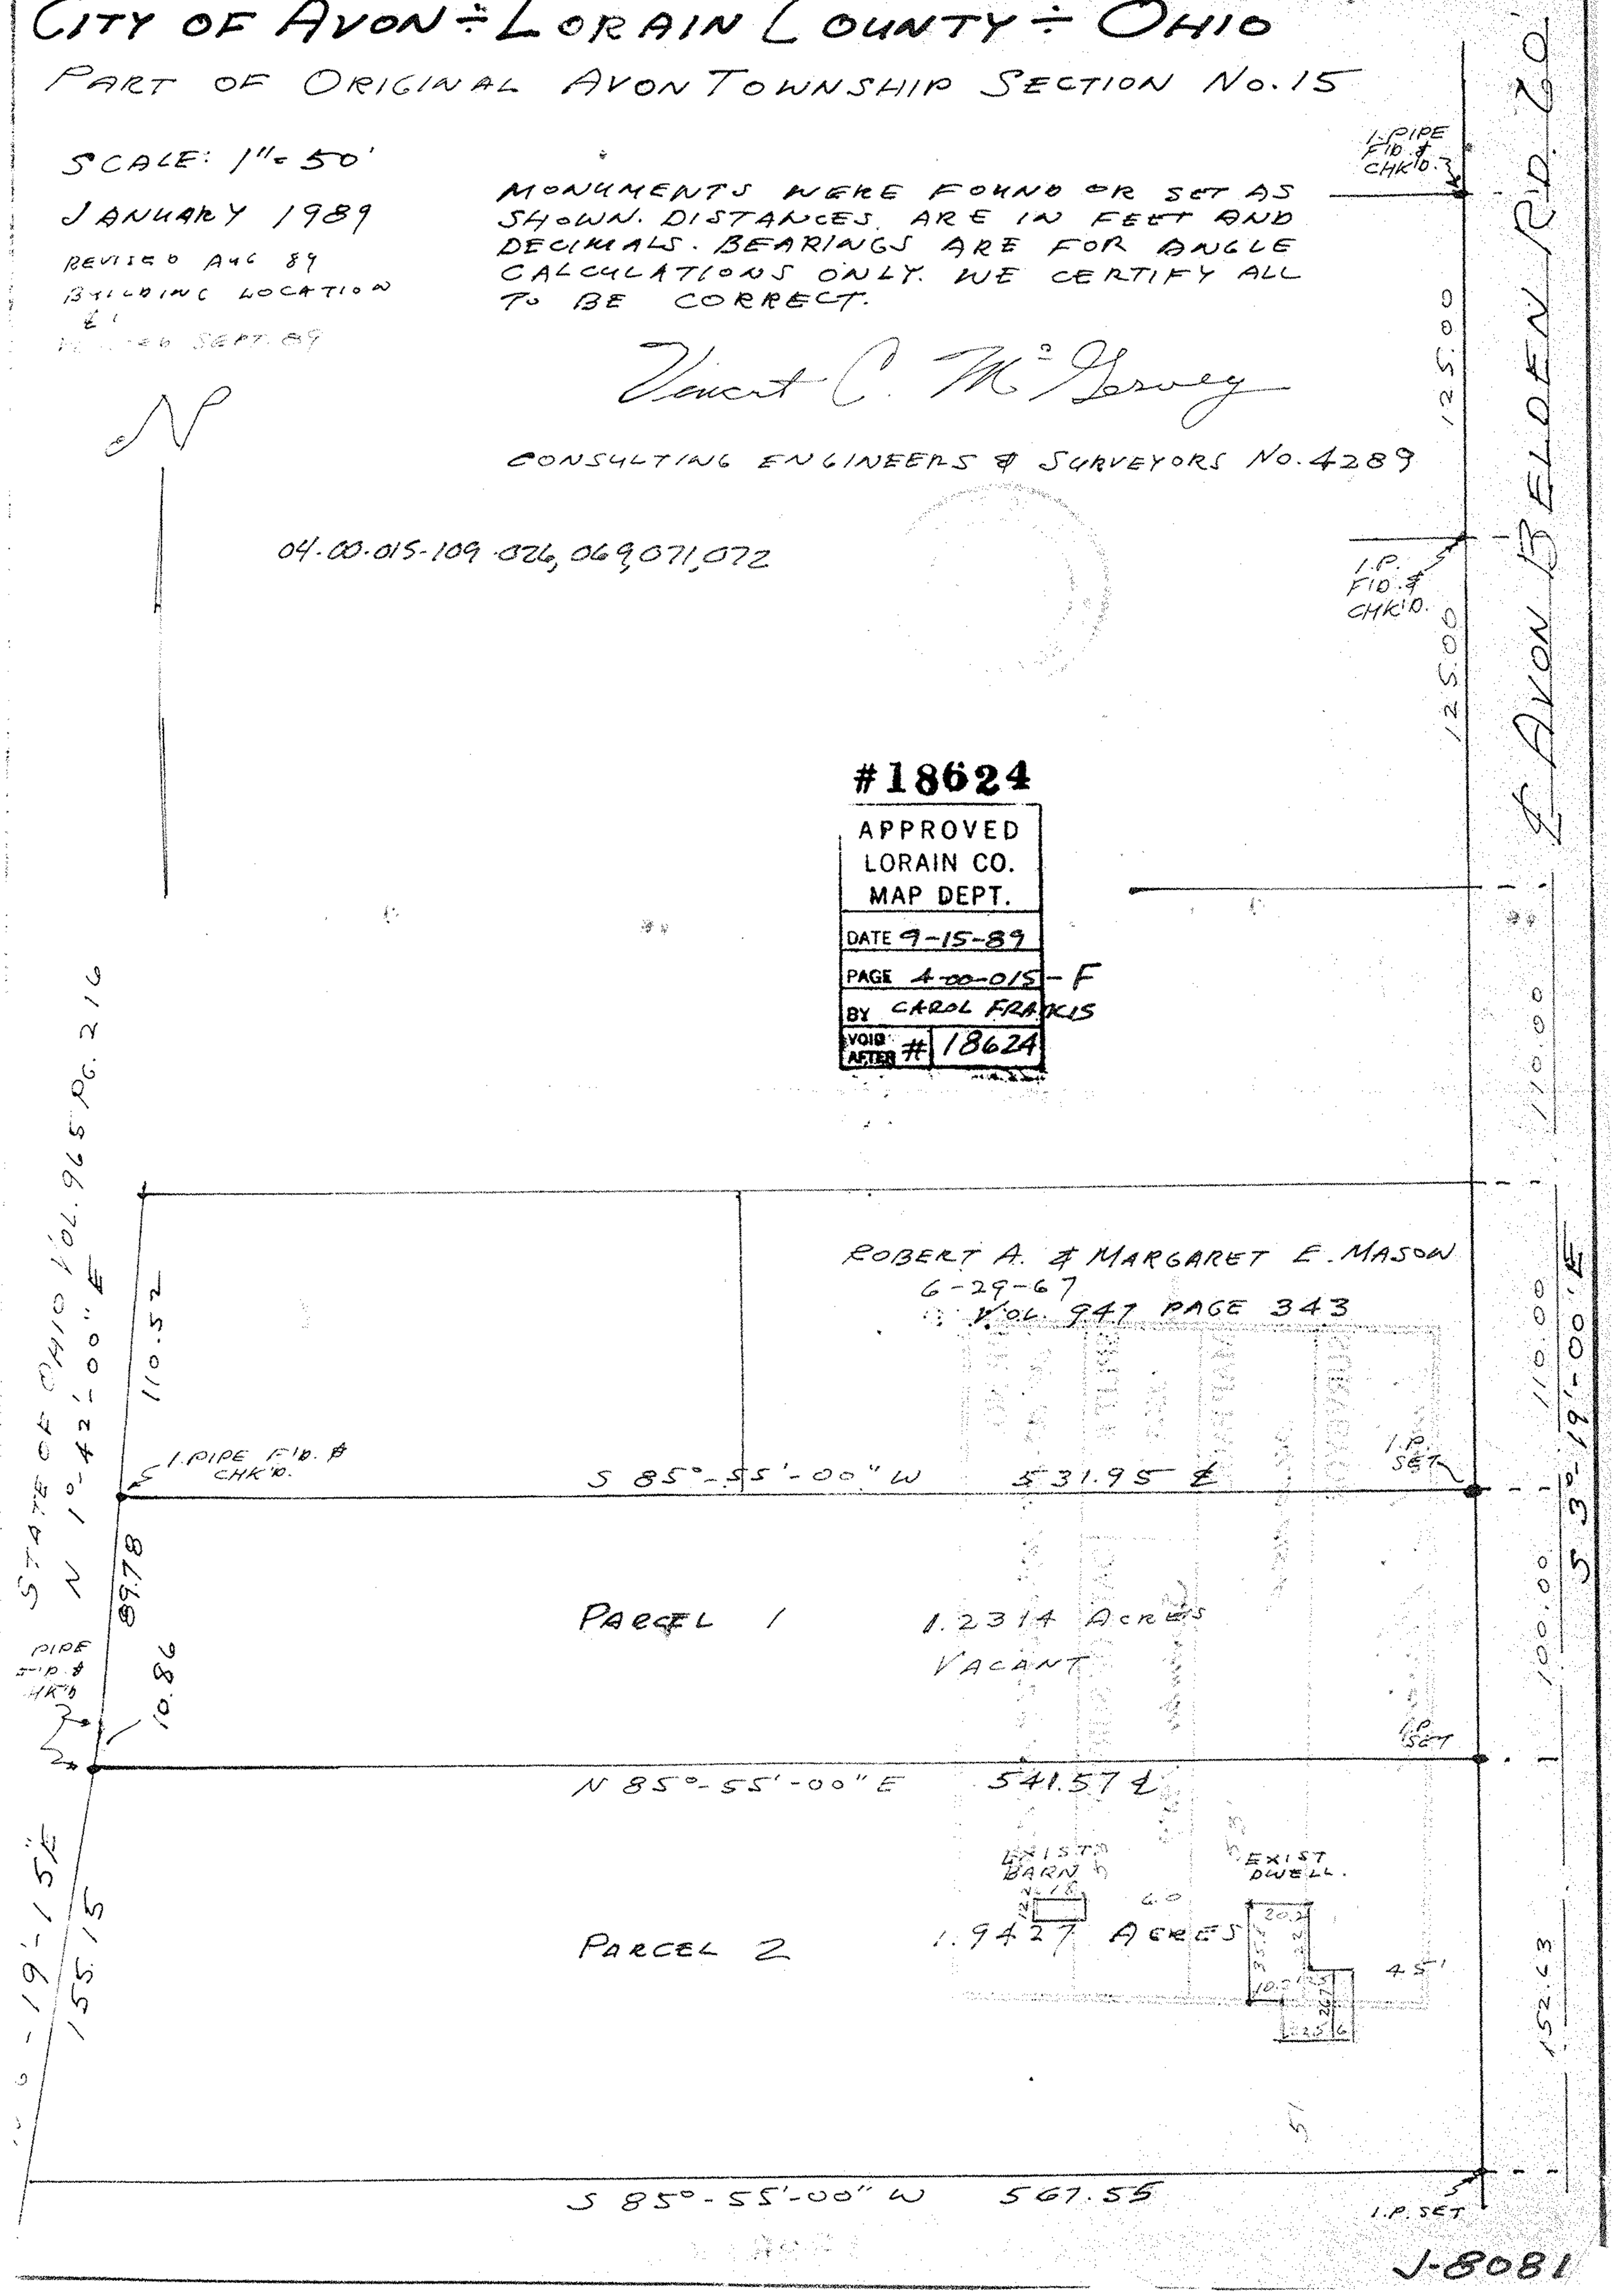

J-8081