


GRAPHIC SCALE


(IN FEET)
1 inch = 60 ft

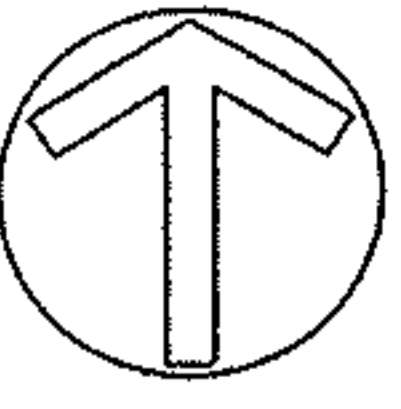

Schwartz Road (Width Varies)

Sandy Lane 60'

Sandy Creek Subdivision Volume 19 Page 10

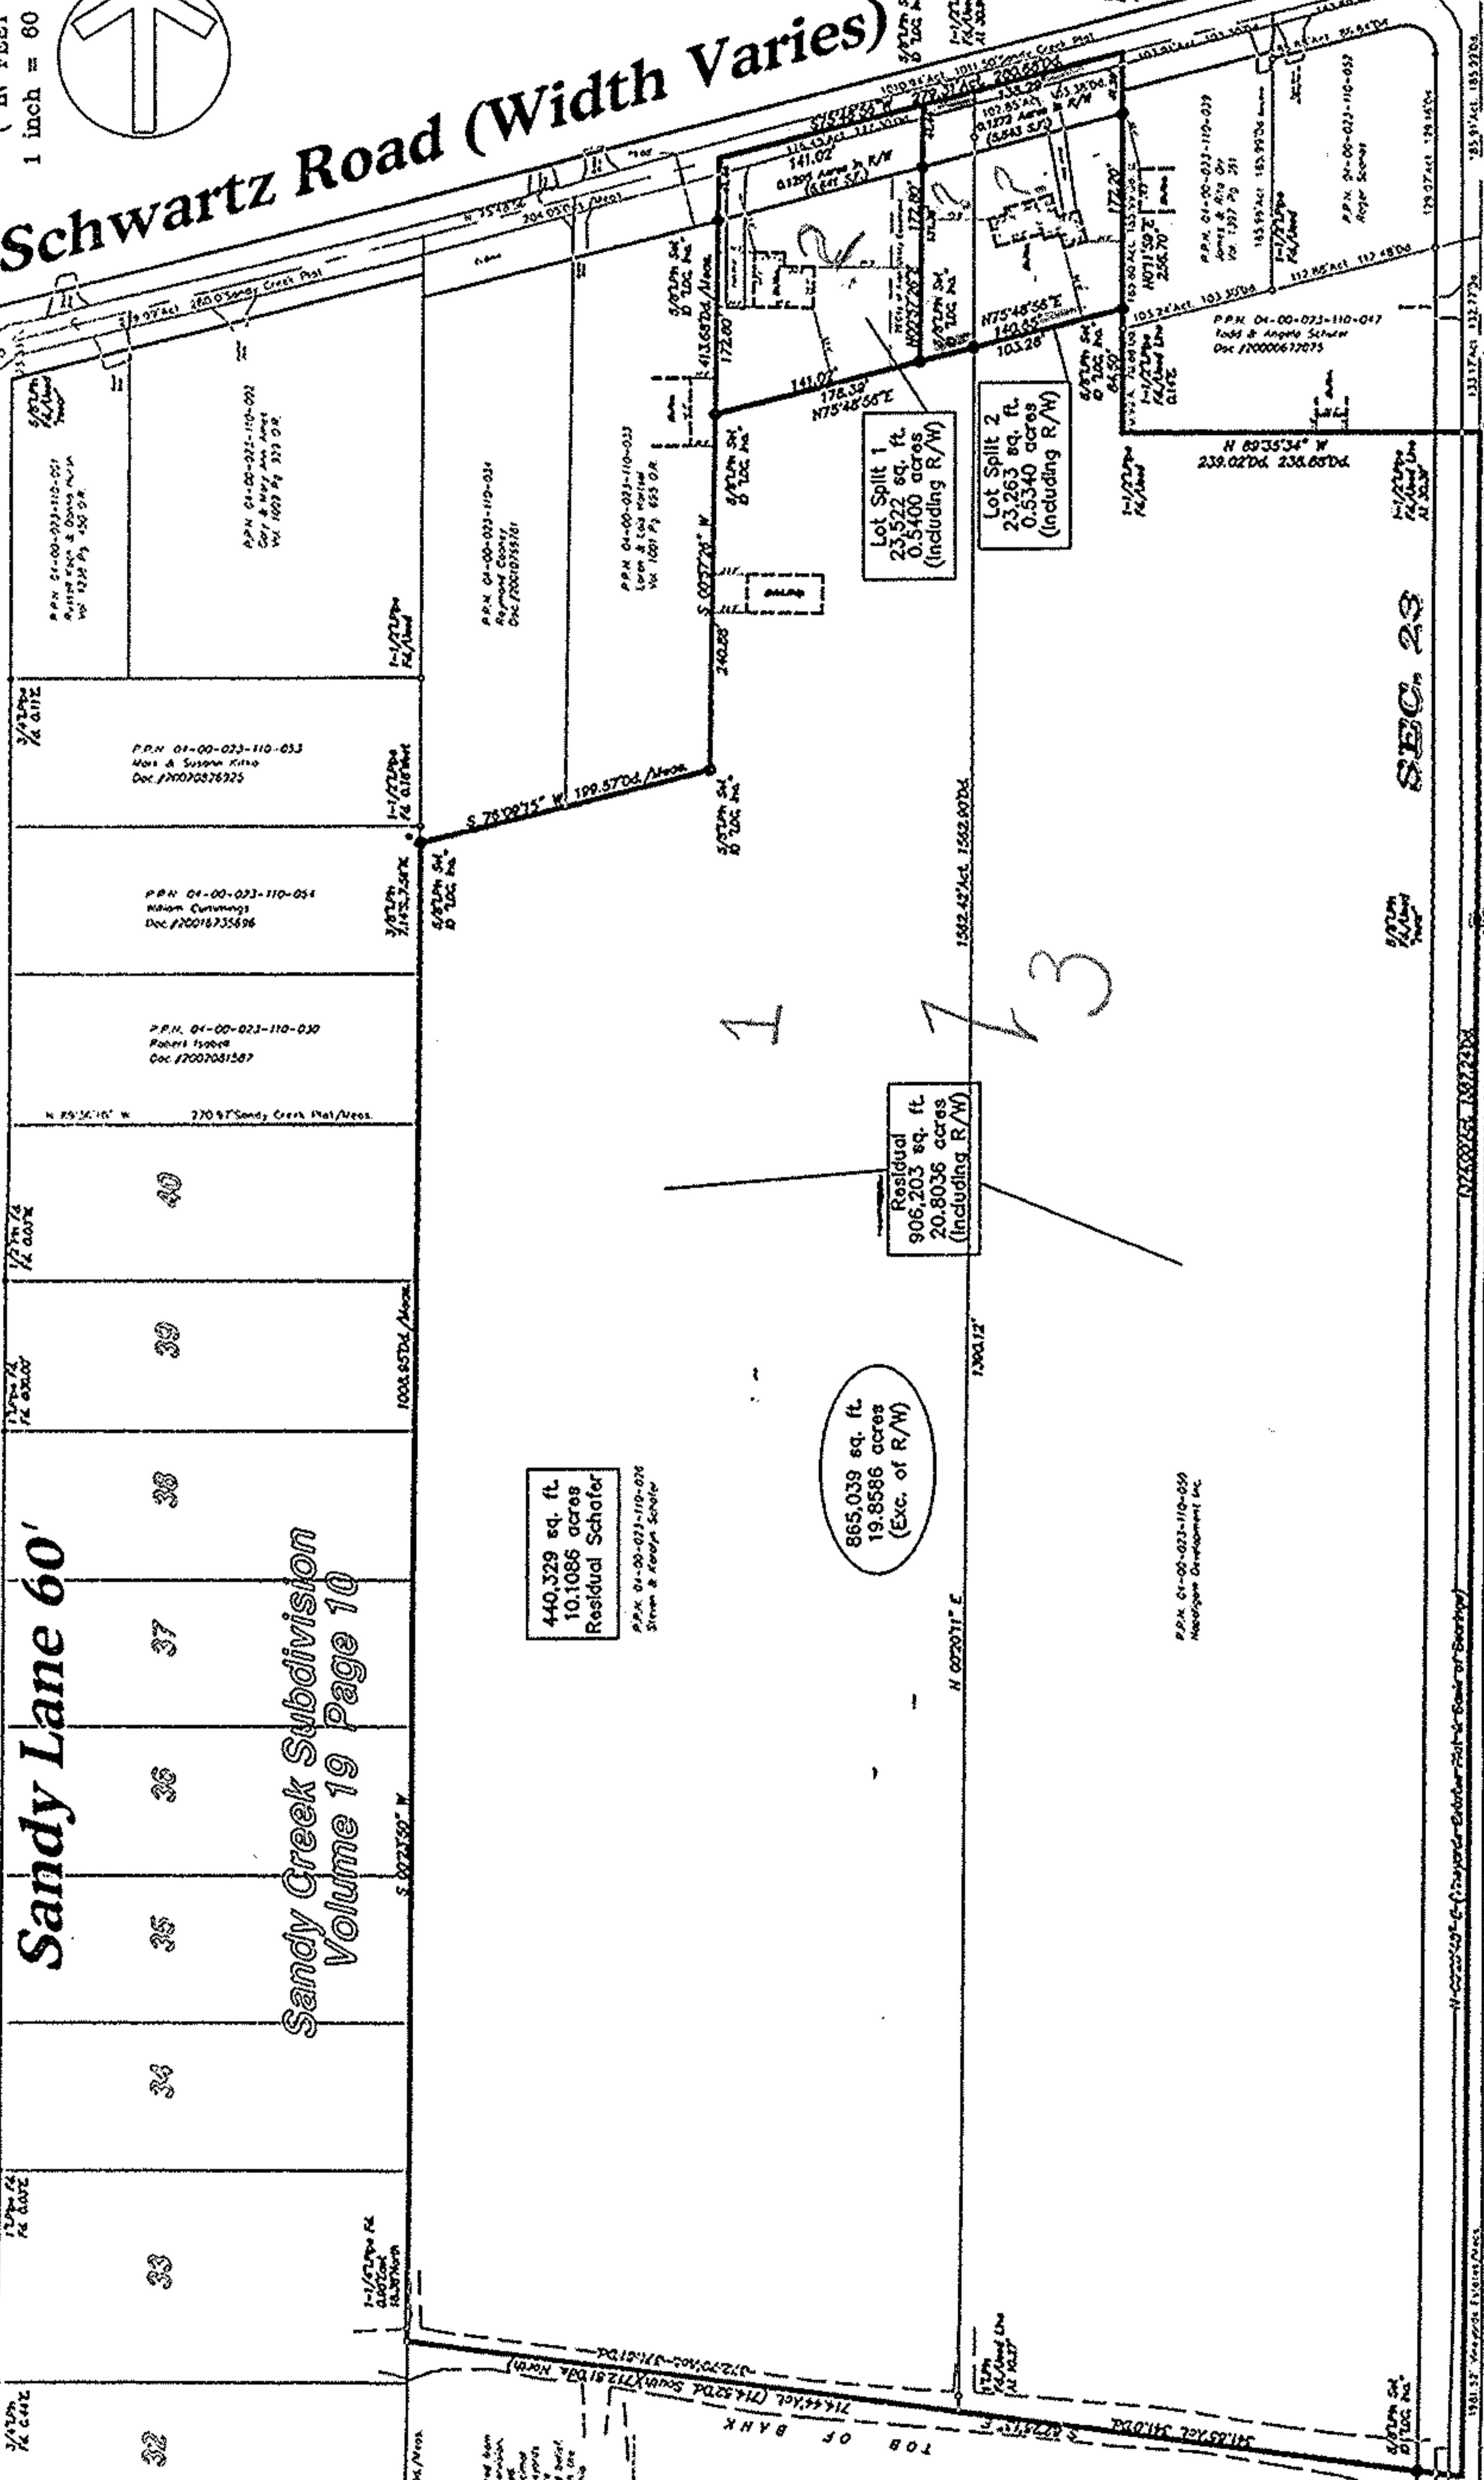

440,329 sq. ft.
10,1086 acres
Residual Schafer
P.P.M. 04-00-023-110-026

865,039 sq. ft.
19,8586 acres
(Exc. of R/W)

Residual
906,203 sq. ft.
20,8036 acres
(Including R/W)

Lot Split 1
23,522 sq. ft.
0.5400 acres
(Including R/W)

Lot Split 2
23,263 sq. ft.
0.5340 acres
(Including R/W)





P.P.M. 04-00-023-110-045
Alice Roper
WC 551 Pg. 855 08

Nagel Road 60' & Varies

Vineyard Park 60'

Plat of Lot Split & Consolidation City of Avon - Lorain County - Ohio



LAND DESIGN consultants
ENGINEERS - PLANNERS - SURVEYORS

DATE BY CODE

REV. No.

DATE ISSUED
SCALE: HOR. VERT.
PREPARED BY
COMPUTER PROGRAM
FIELD CREW

SEC. 26

SEC. 23

SHEET OF
1 / 1
CONTRACT No.
Cottg-0201

04-00-023-110-050, 016, 52, 037