KLEINOEDER · SCHMIDT
and ASSOCIATES

ENGINEERS — SURVEYORS — CONSULTANTS in LAND PLANNING

ELYRIA · NORWALK · MEDINA OHIO

SURVEY

Sublot(s) PT. SL 12

Subd'n HINZ ALLOTMENT
P.V. 18, P 5

Township AVON

Orig. Lot(s)

County of LORAIN

Corporation CITY OF AVON LAKE

Tract

Sec. 30

State of Ohio

#16324
APPROVED
LORAIN CO.
MAP DEPT.
DATE 8-21-85
PAGE 4.00.030.D
BY T. McMain
VOID AFTER

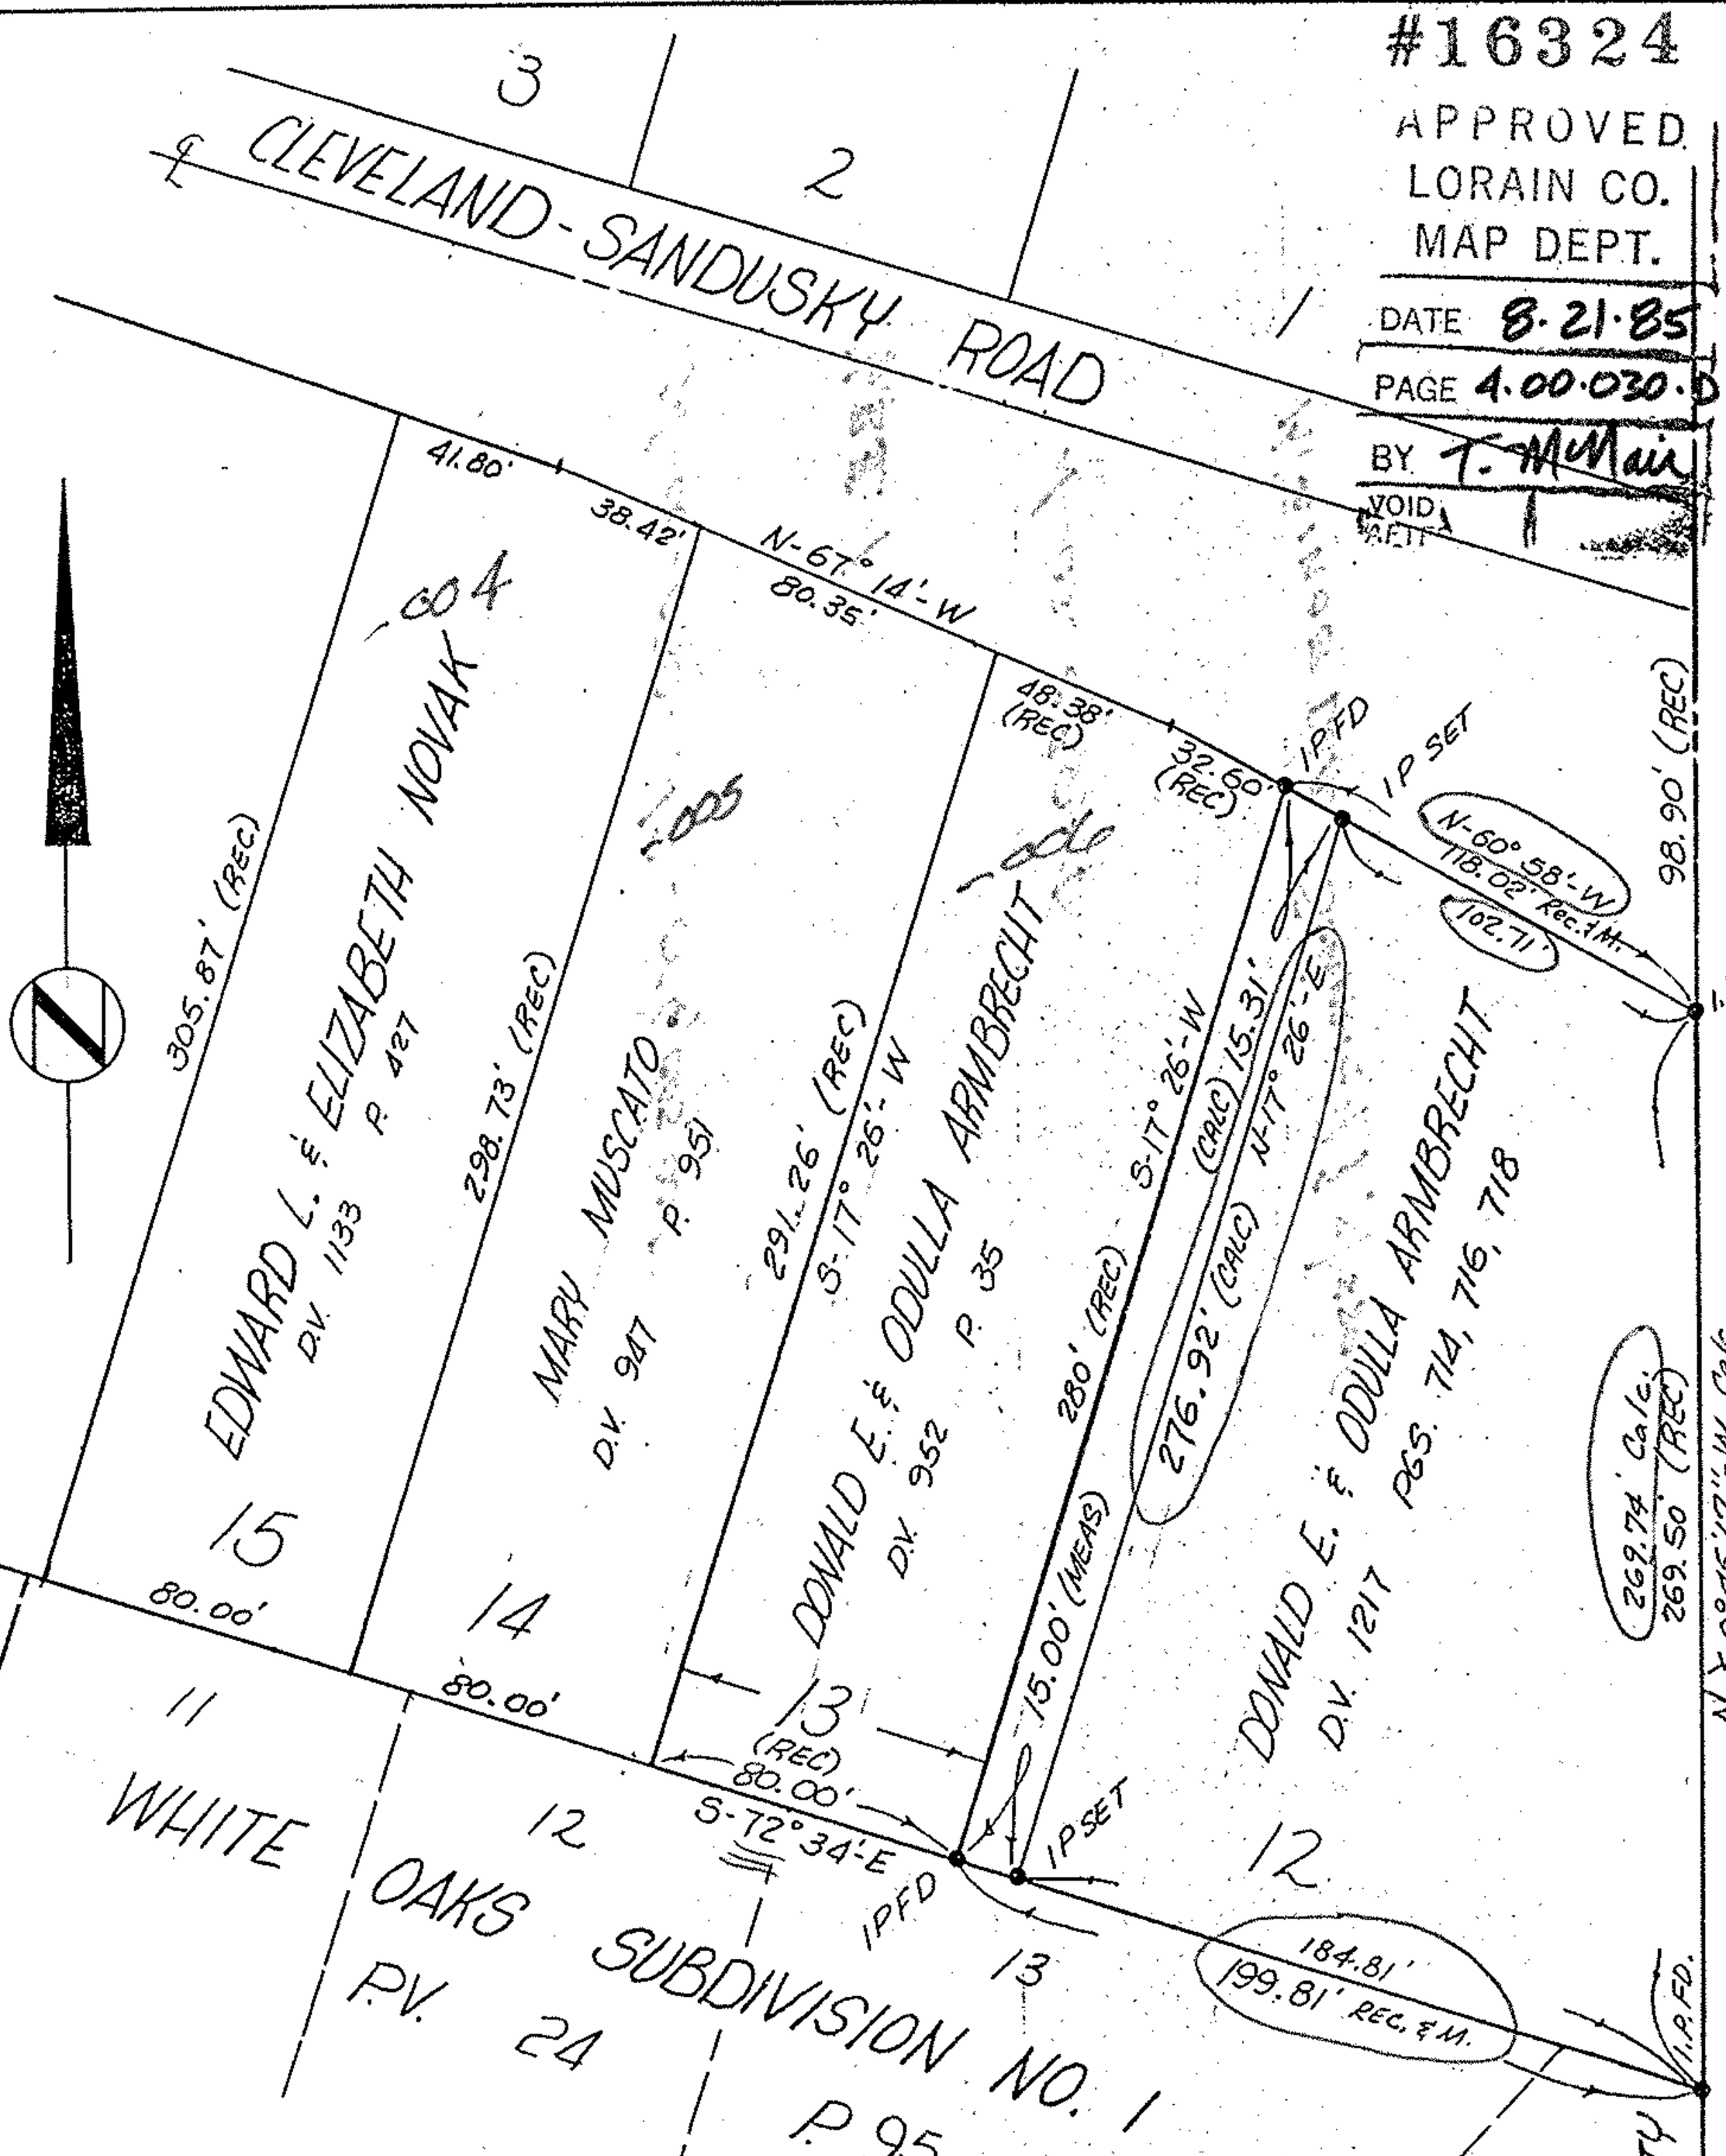

04-00-030-142-006,005 004

Prepared for: DONALD ARMBRECHT

Scale: 1"=60'	Date: 7-20-79	Dr. by: KK	Job № 79-94