

04-00-030-107-040,041



KLEINOEDER-SCHMIDT

and ASSOCIATES

ENGINEERS — SURVEYORS — CONSULTANTS IN LAND PLANNING

ELYRIA - NORWALK - MEDINA

OHIO

SURVEY

Sublot(s) 11

Subd'n HINZ ALLOTMENT



P.V. 18 P.E

Township _____ Tract _____

Orig. Lot(s) _____ Sec. 30

County of LORAIN State of Ohio

Corporation CITY OF AVON LAKE

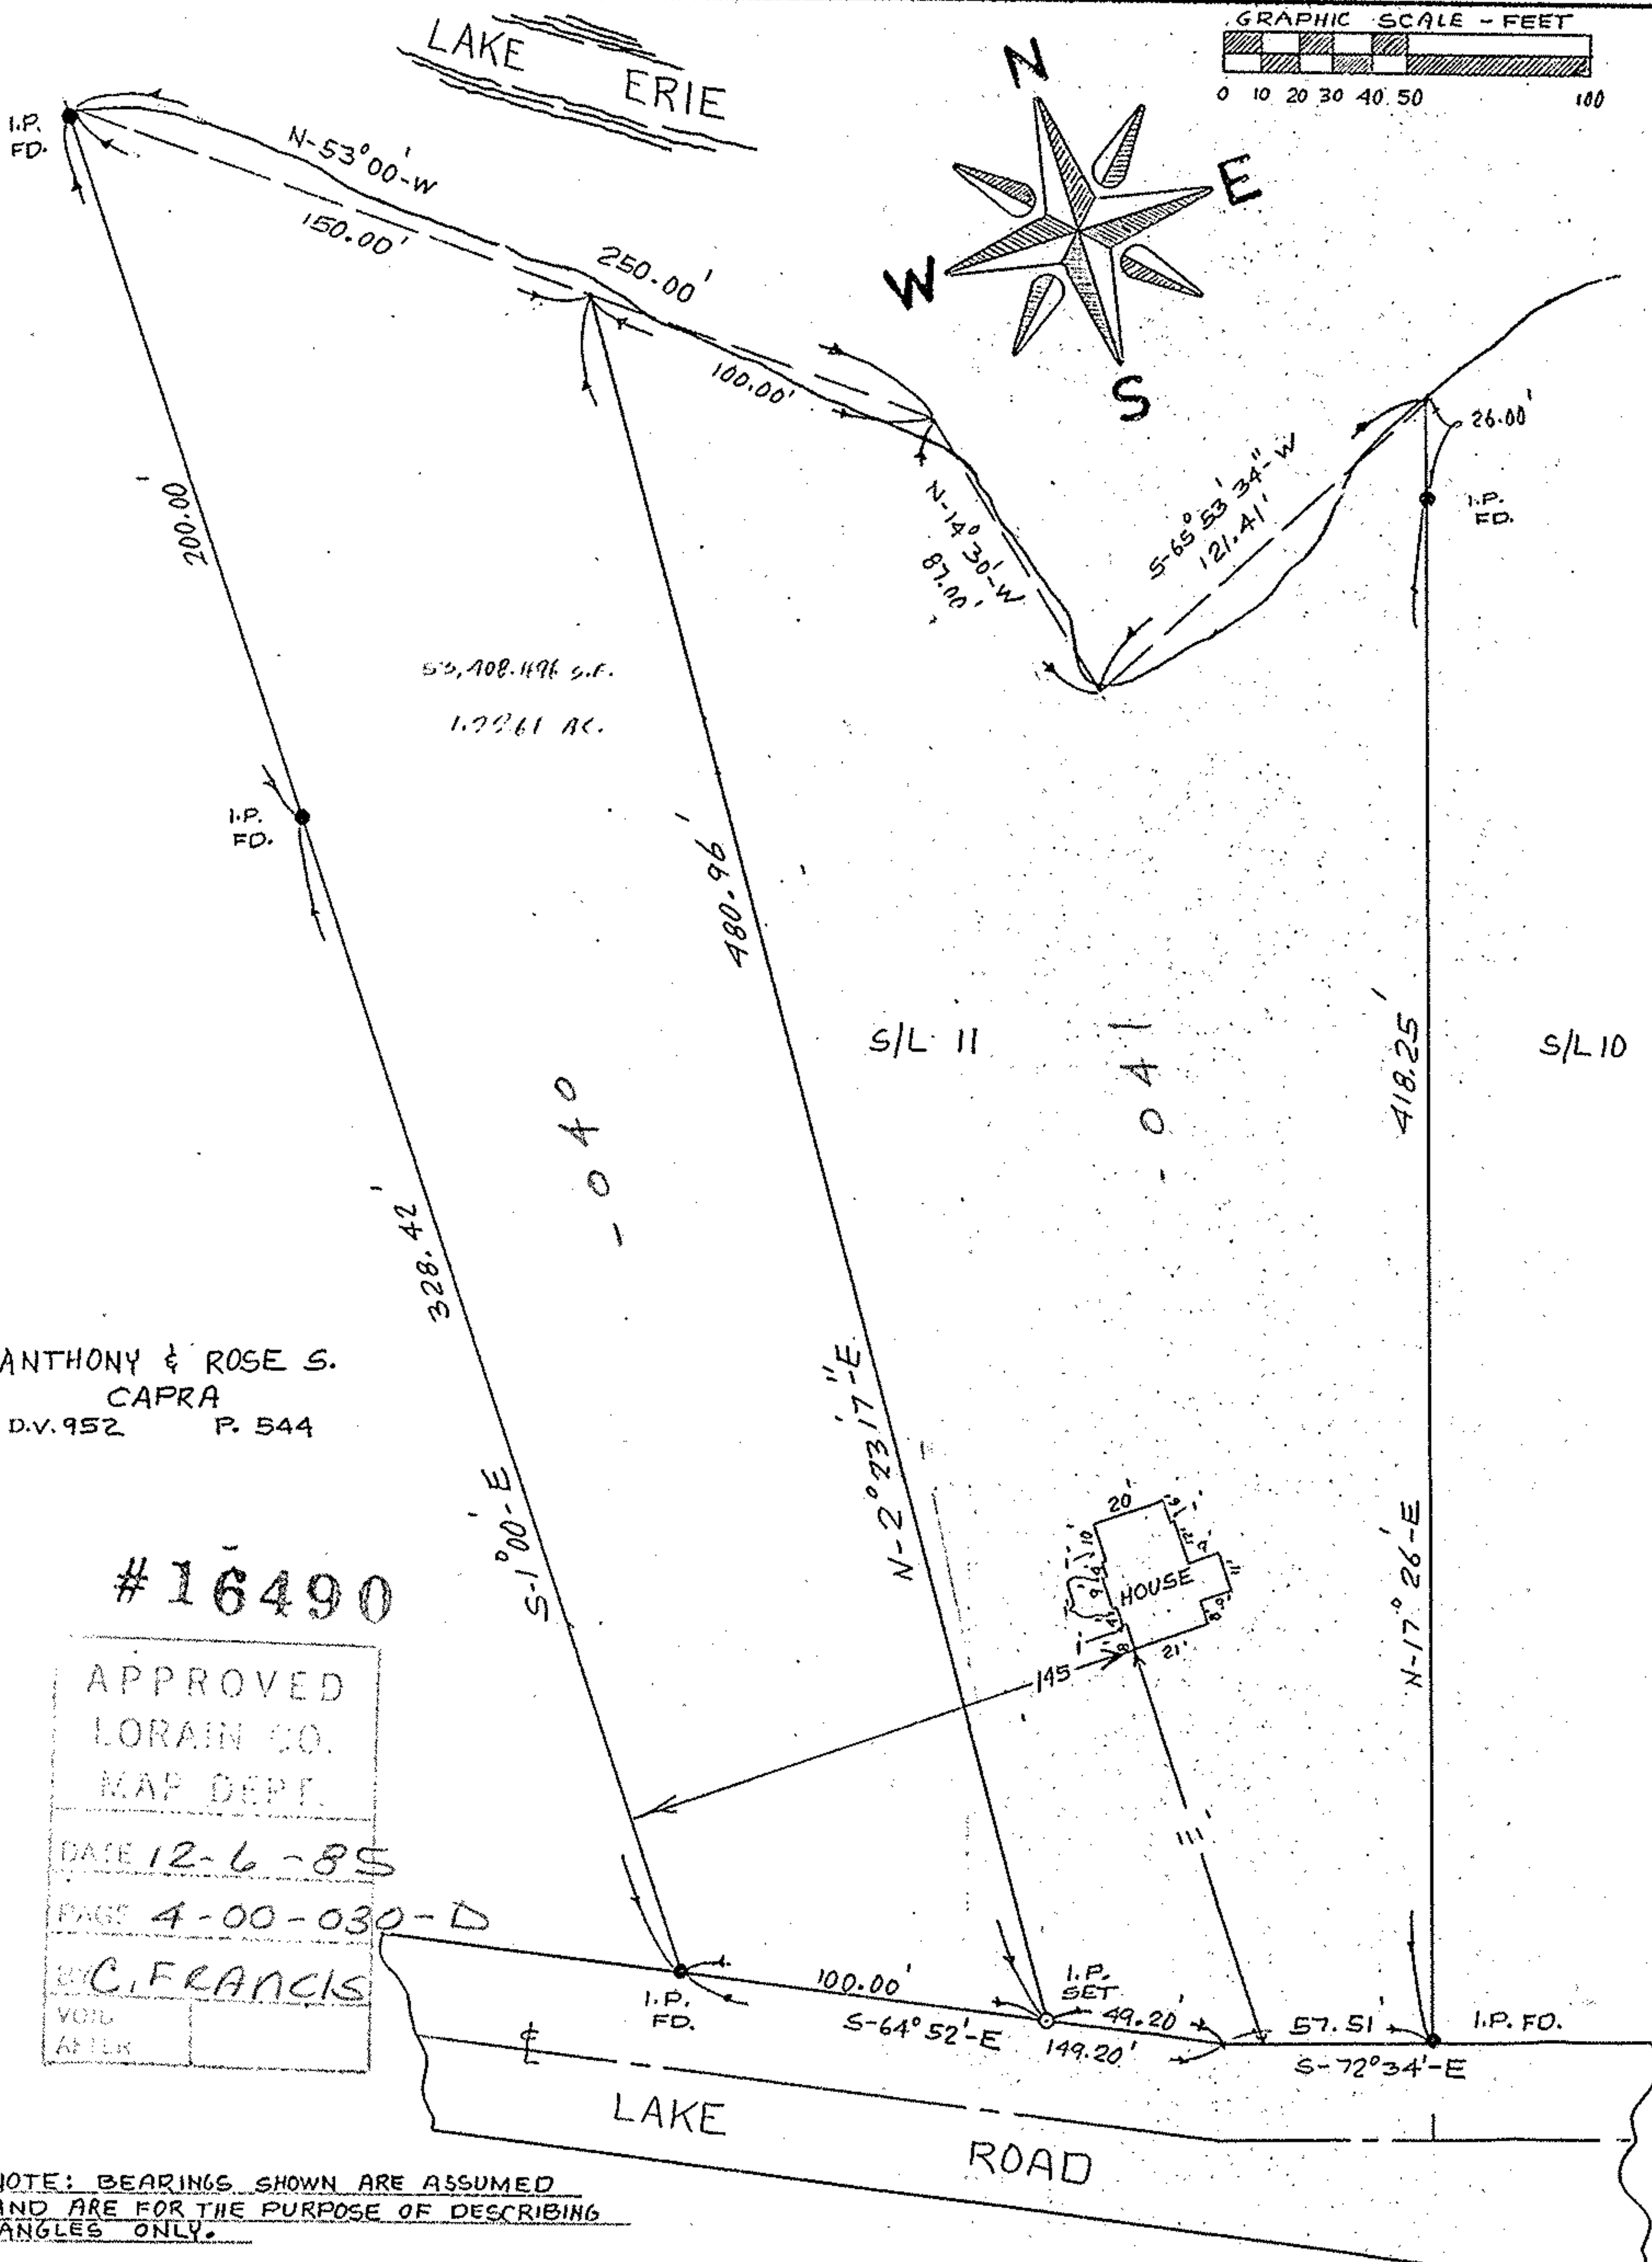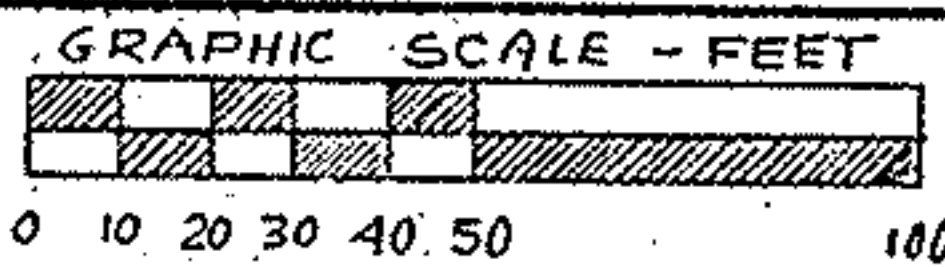

52,408.496 s.f.
1.2261 AC.

ANTHONY & ROSE S.
CAPRA
D.V. 952 P. 544

#16490

APPROVED
LORAIN CO.
MAP DEPT.

DATE 12-6-85

PAGE 4-00-030-D

BY C. FRANCIS

VOID AFTER

NOTE: BEARINGS SHOWN ARE ASSUMED AND ARE FOR THE PURPOSE OF DESCRIBING ANGLES ONLY.

Prepared for: ALDO d'ACUNZO

Scale: 1" = 60' Date: 8-21-85 Dr. by: K.V.S. Job No 85-181