


#16511
 APPROVED
 LORAIN CO.
 MAP DEPT.

1. Duane and Helen Mayo Vol. 1212 Page 375
2. Donald and Janet O' Neill Vol. 1219 Page 364
3. Bruce and Rosalyn Kinzel Vol. 1090 Page 597
4. Wayne and Gaylen Zenk Vol. 932 Page 342 Now Robert and Frances Sikora
5. Charles and P. Lacey Vol. 866 Page 128
7. Richard and Laura Gill Vol. 948 Page 817
6. Mary and Ralph Gale Vol. 1145 Page 256
8. Robert Sikora, Bruce Kinzel, and Charles Lacey Vol. 1353 Page 368 7.54 Acres

DATE 12-26-85
 PAGE 4-00-025-A
 BY J. McMain
 VOID
 METER

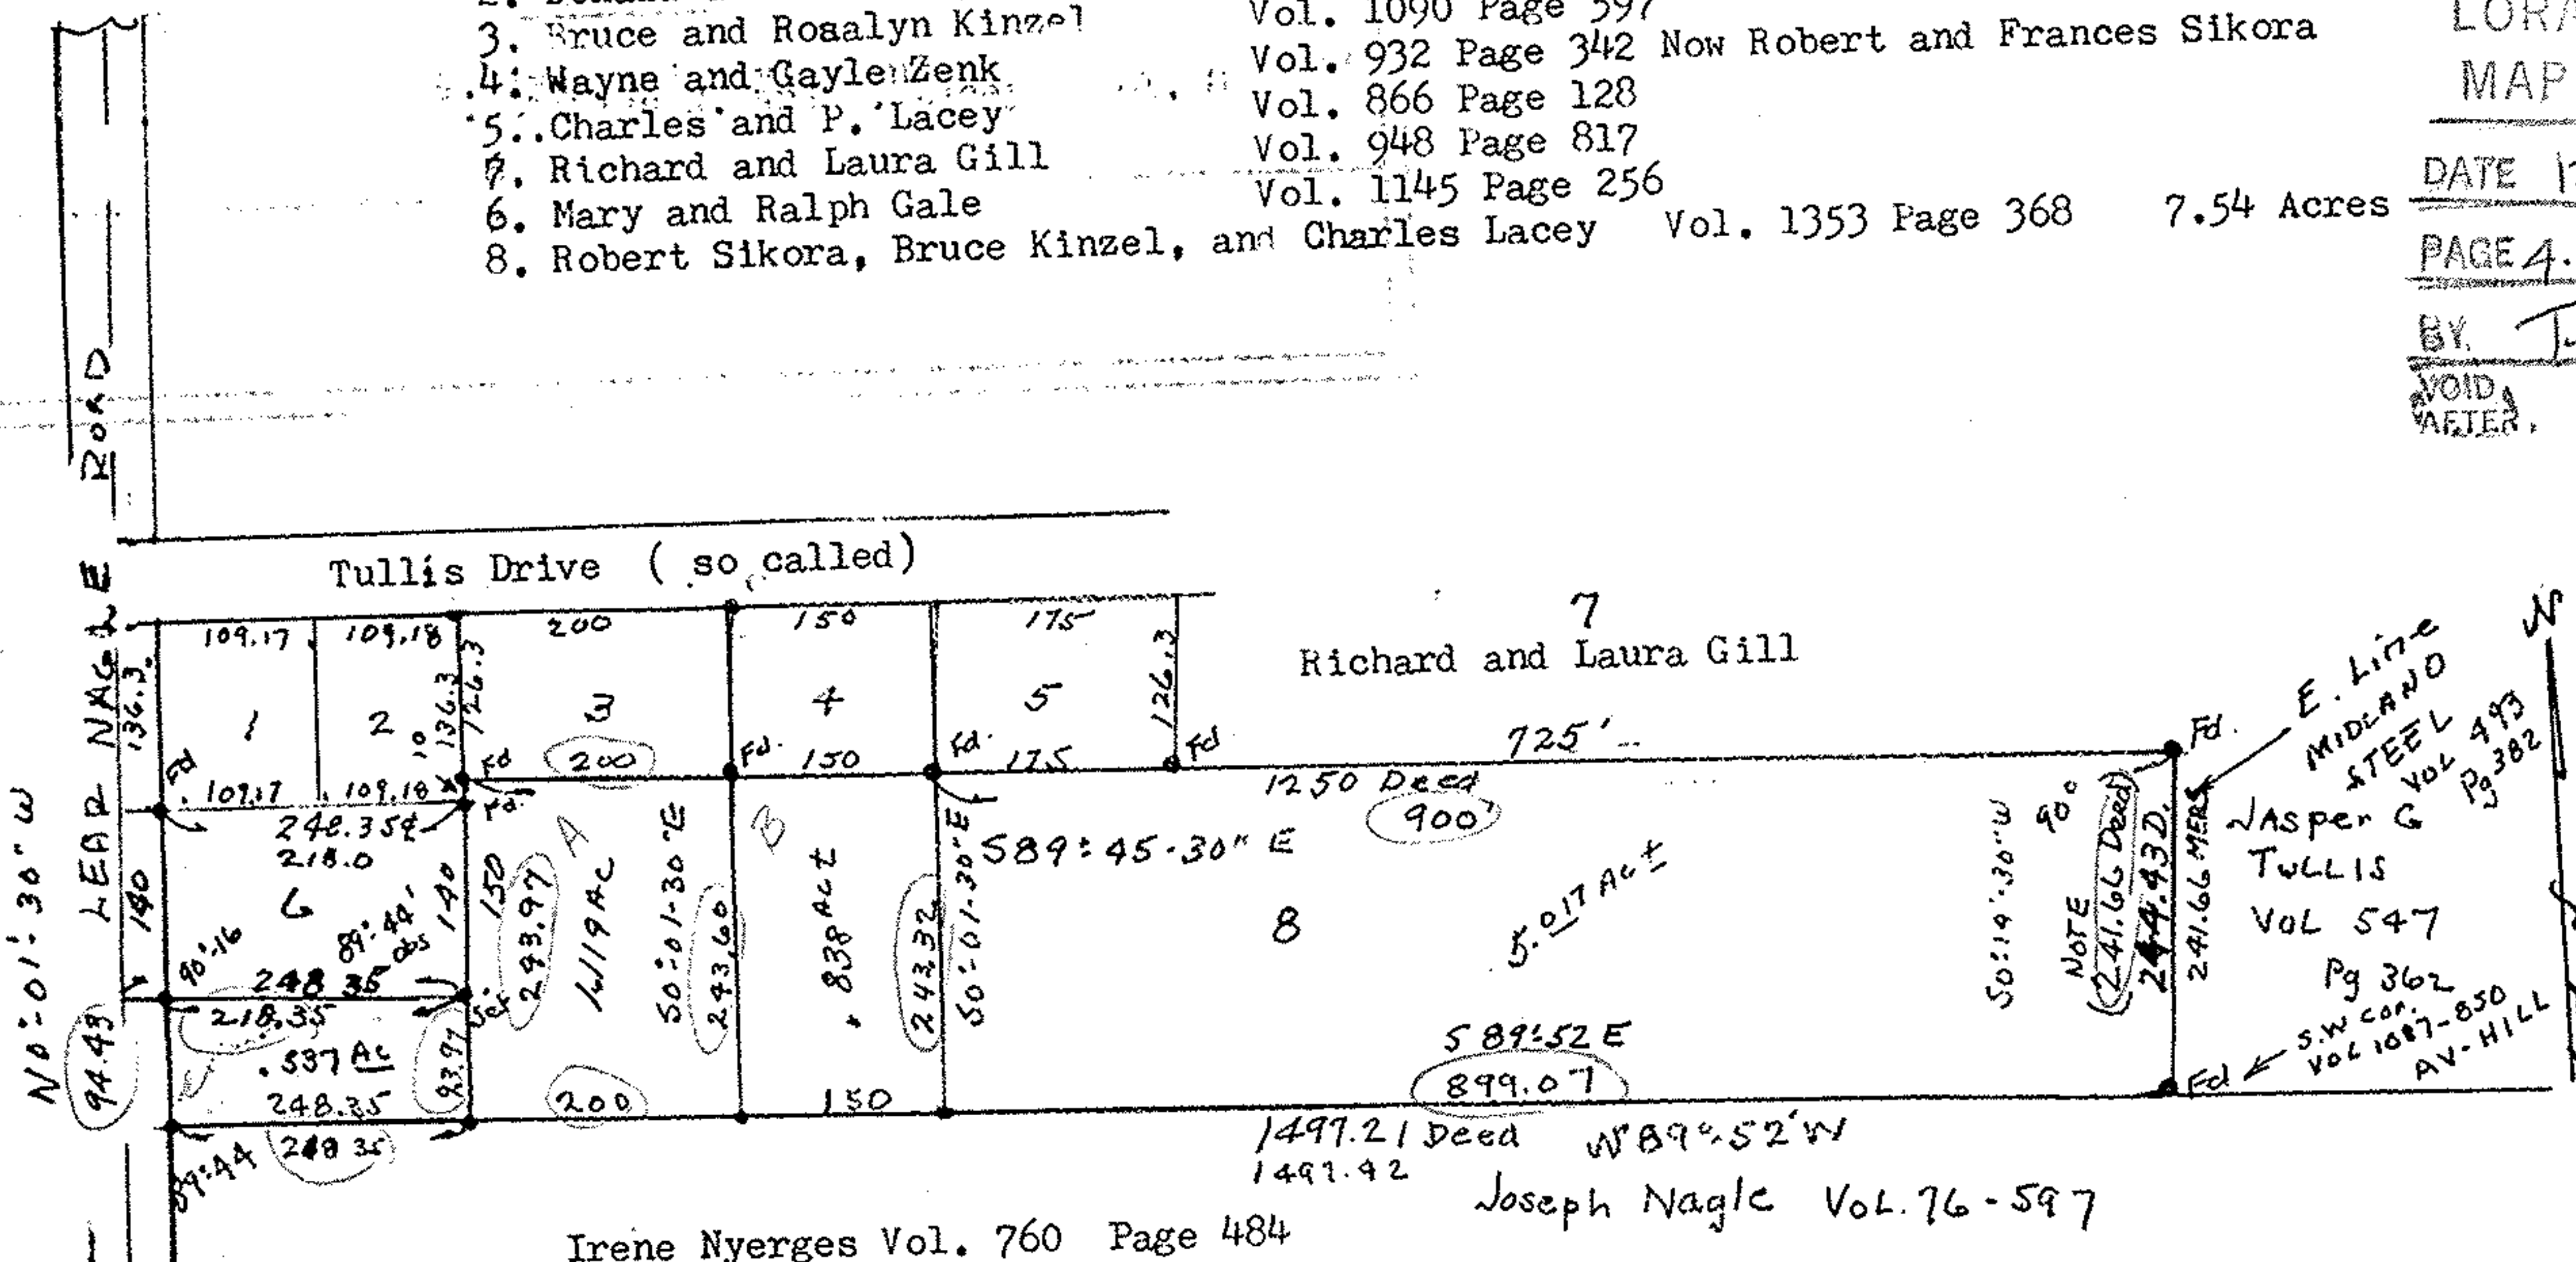

Note; For measurement of East line see deed Vol. 1087 Page 450 and Vol. 752 Page 507 Pins found are 241.66 feet

parcel # 04-00-024-000-112 thru 115

