


5.00-099.C

#15407

05 00-09

Map of Part of Lot 99 Amherst Twp. now City of Amherst Lorain Co. Ohio
Scale 1" 100' Dec. 17, 1983 By Arnold F. Koepf Reg. Surveyor No. 4306

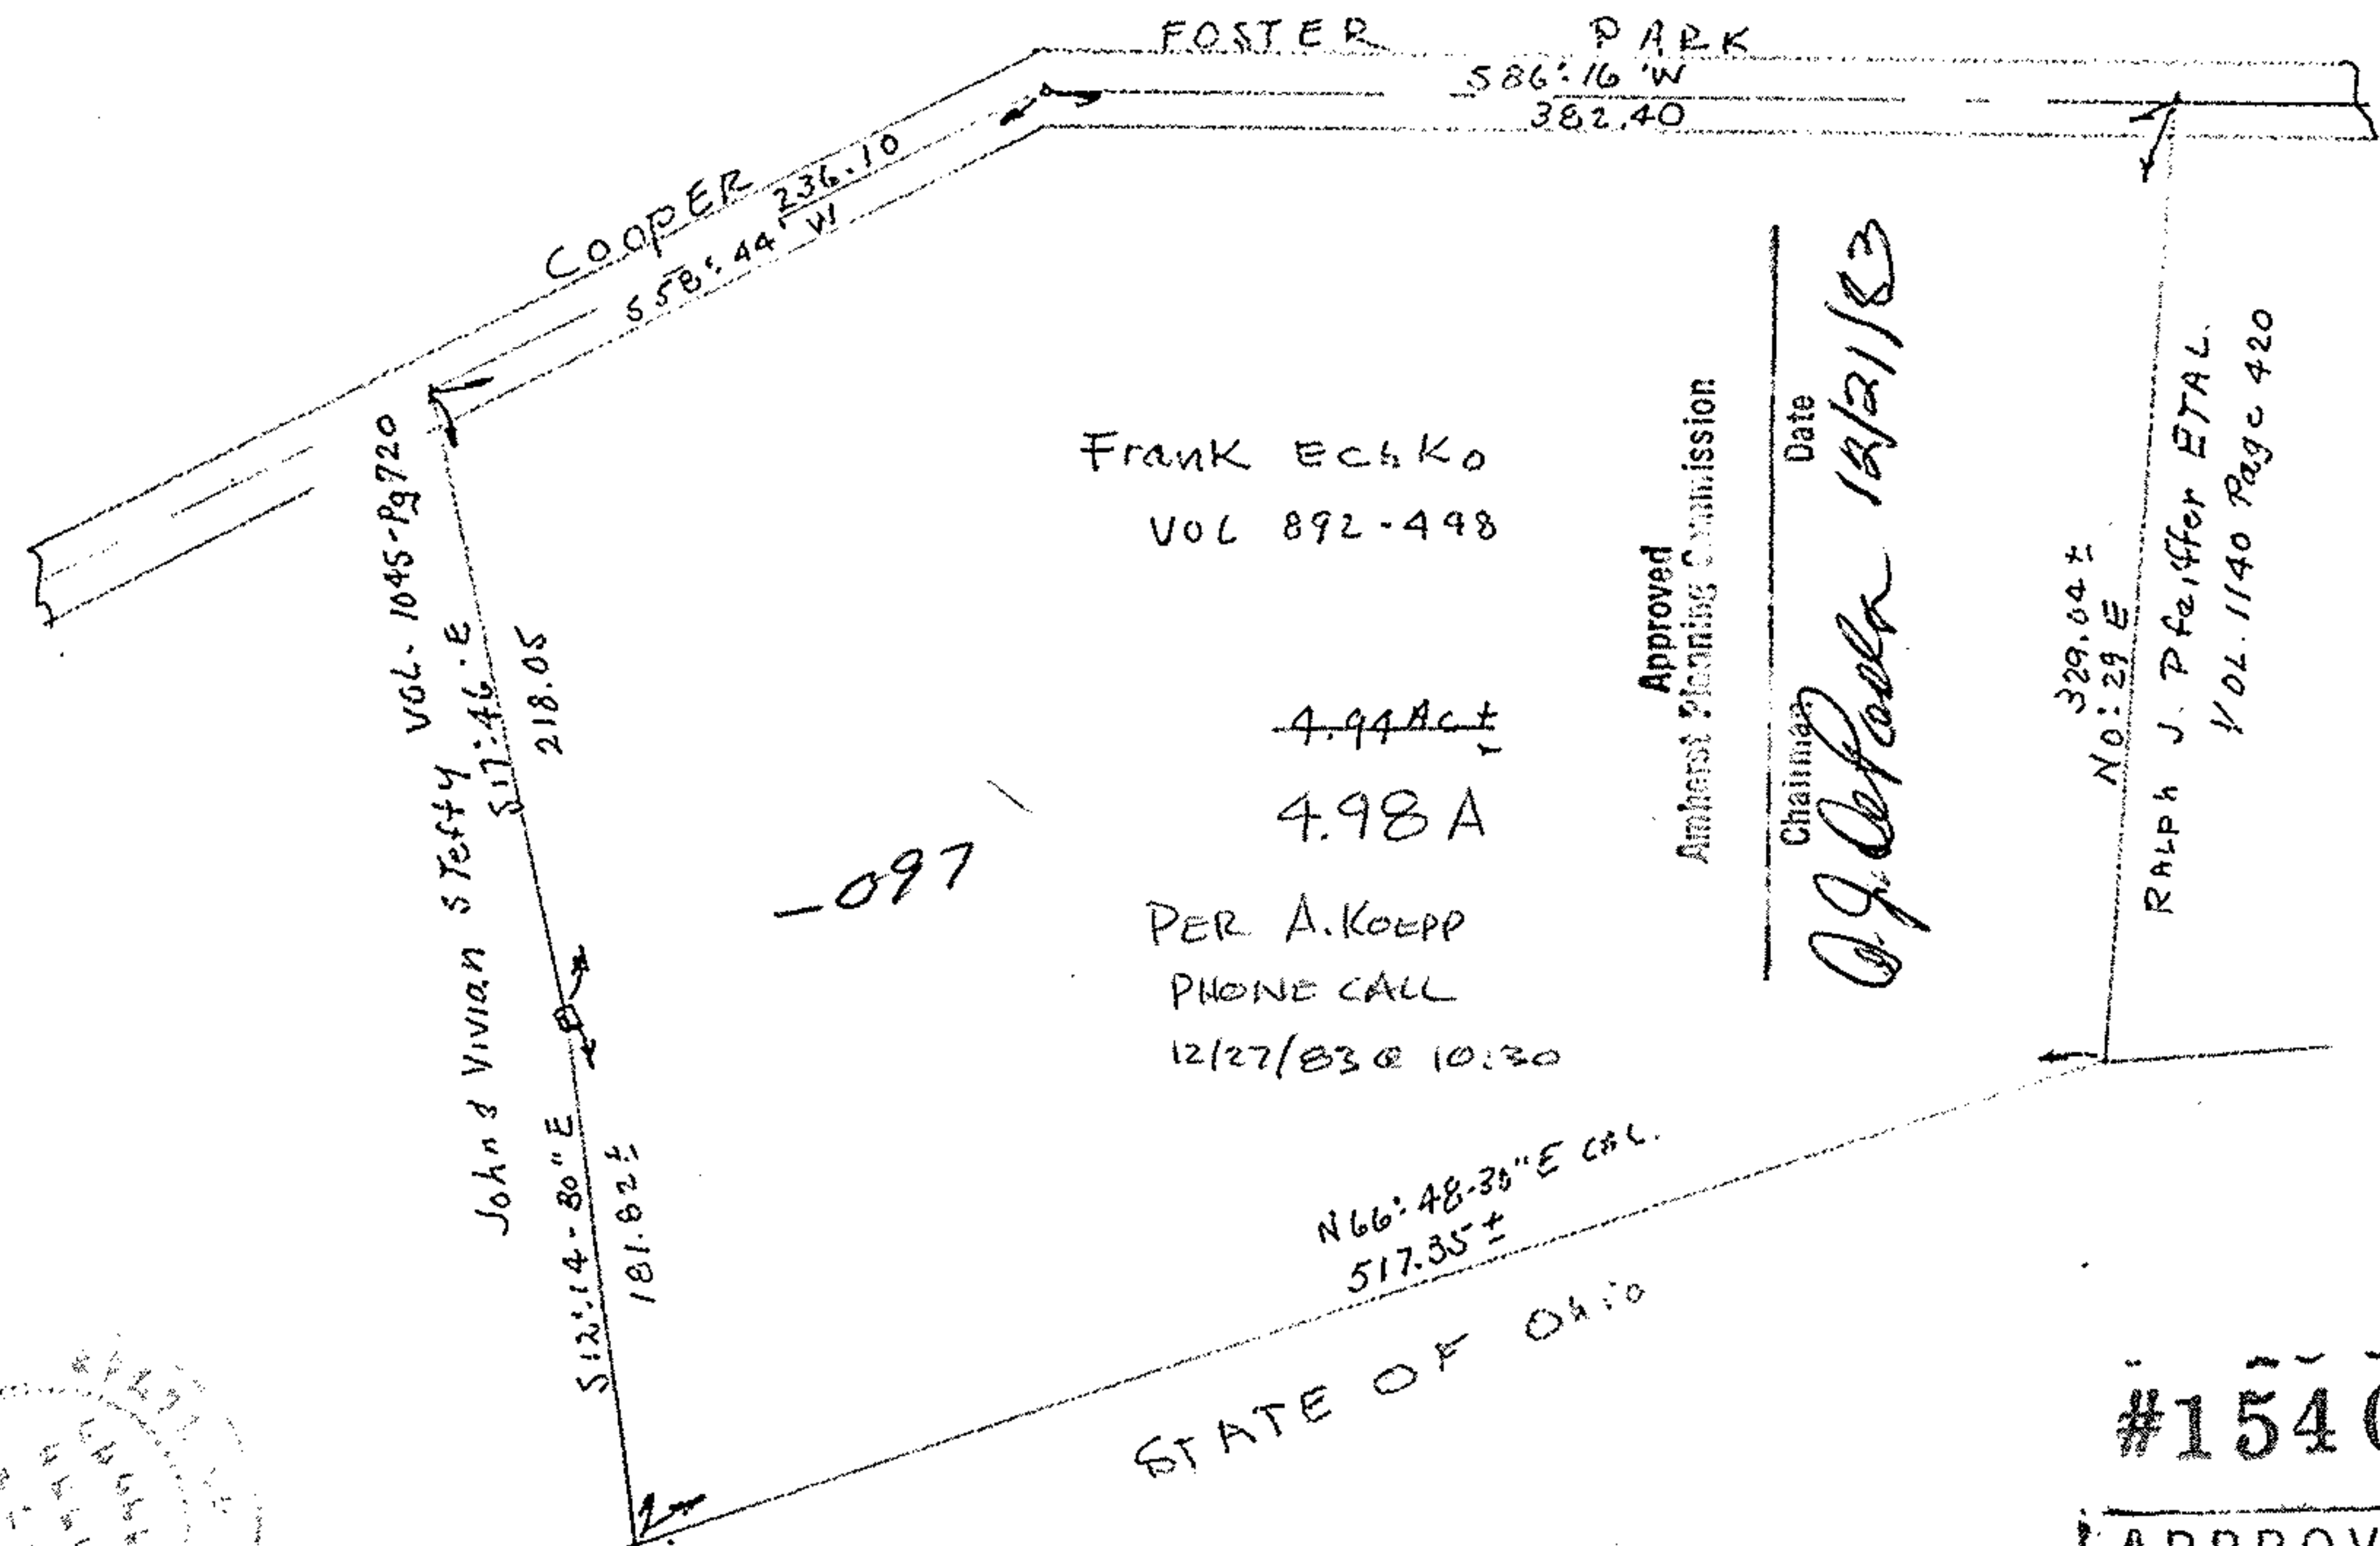

Frank Eckko
VOL 892-498

~~4.94 Act~~
4.98 A

PER A. KOEPF
PHONE CALL
12/27/83 @ 10:30


-097

Approved
Amherst Planning Commission

Chairman
Date
12/21/83

329.04±
NO: 29 E
RALPH J. PFEIFFER ETAL.
VOL. 1140 Page 420

STATE OF OHIO

 

05-00-099.000-097

#15407

APPROVED
LORAIN CO.
MAP DEPT.
DATE 12.27.83
PAGE 5.00.099.C
BY T. McNamee
VOID