
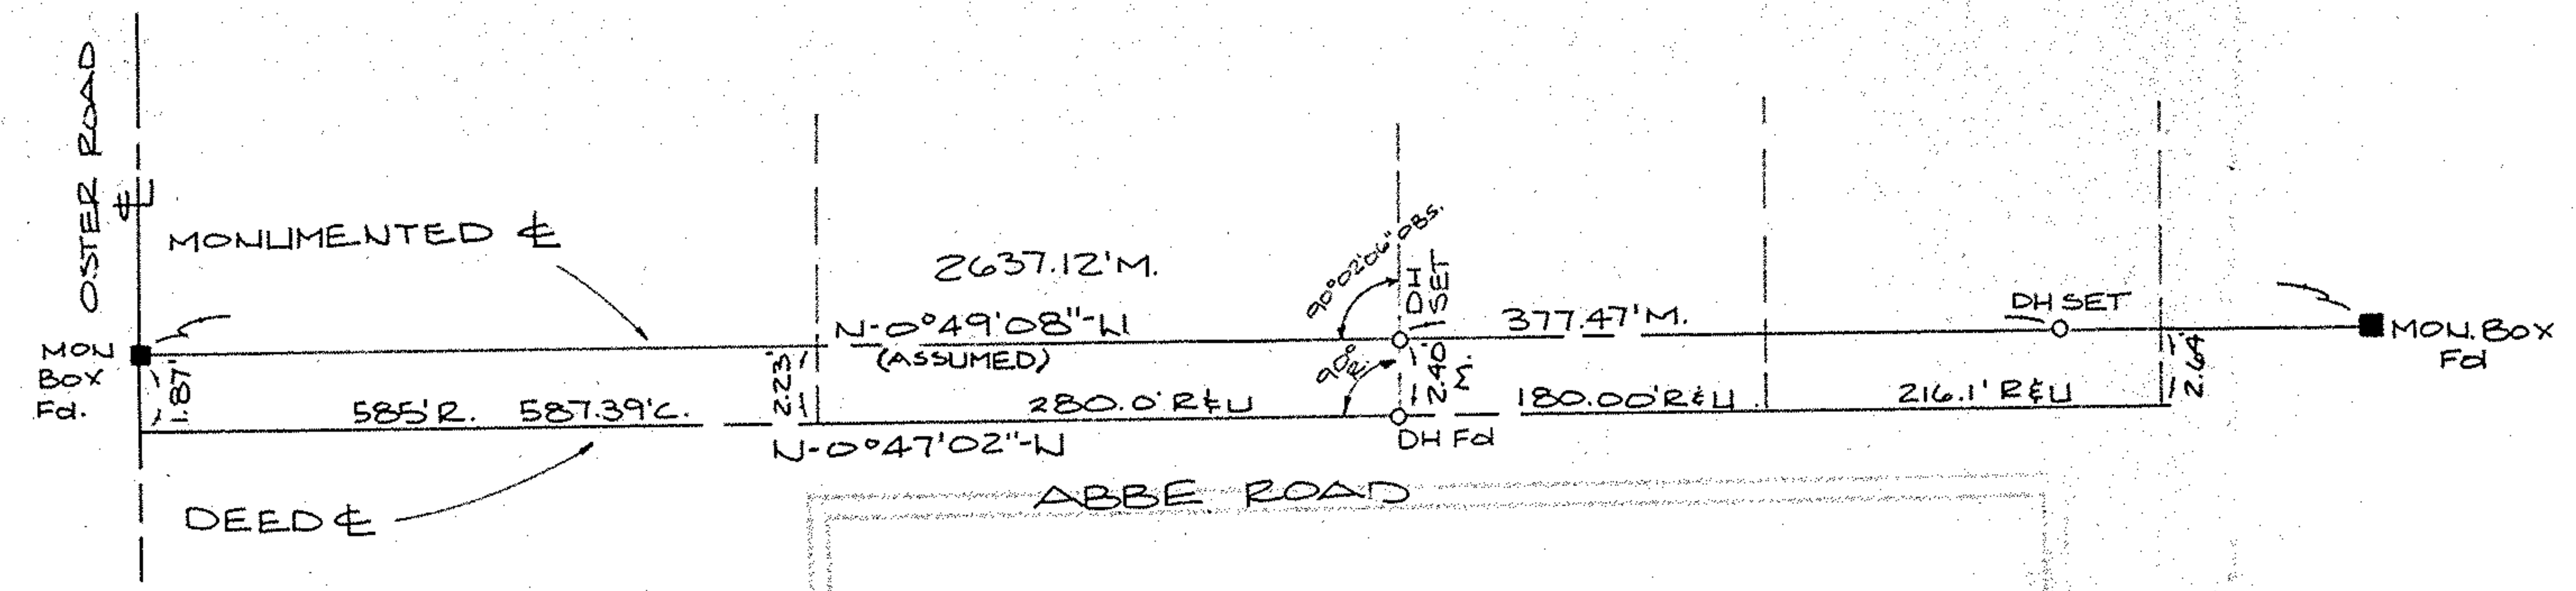


SCALE: 1"=200'

RESUB OF SHORE SUBDIVISION AND
BUCKETE COUNTRY CLUB ALLOT.

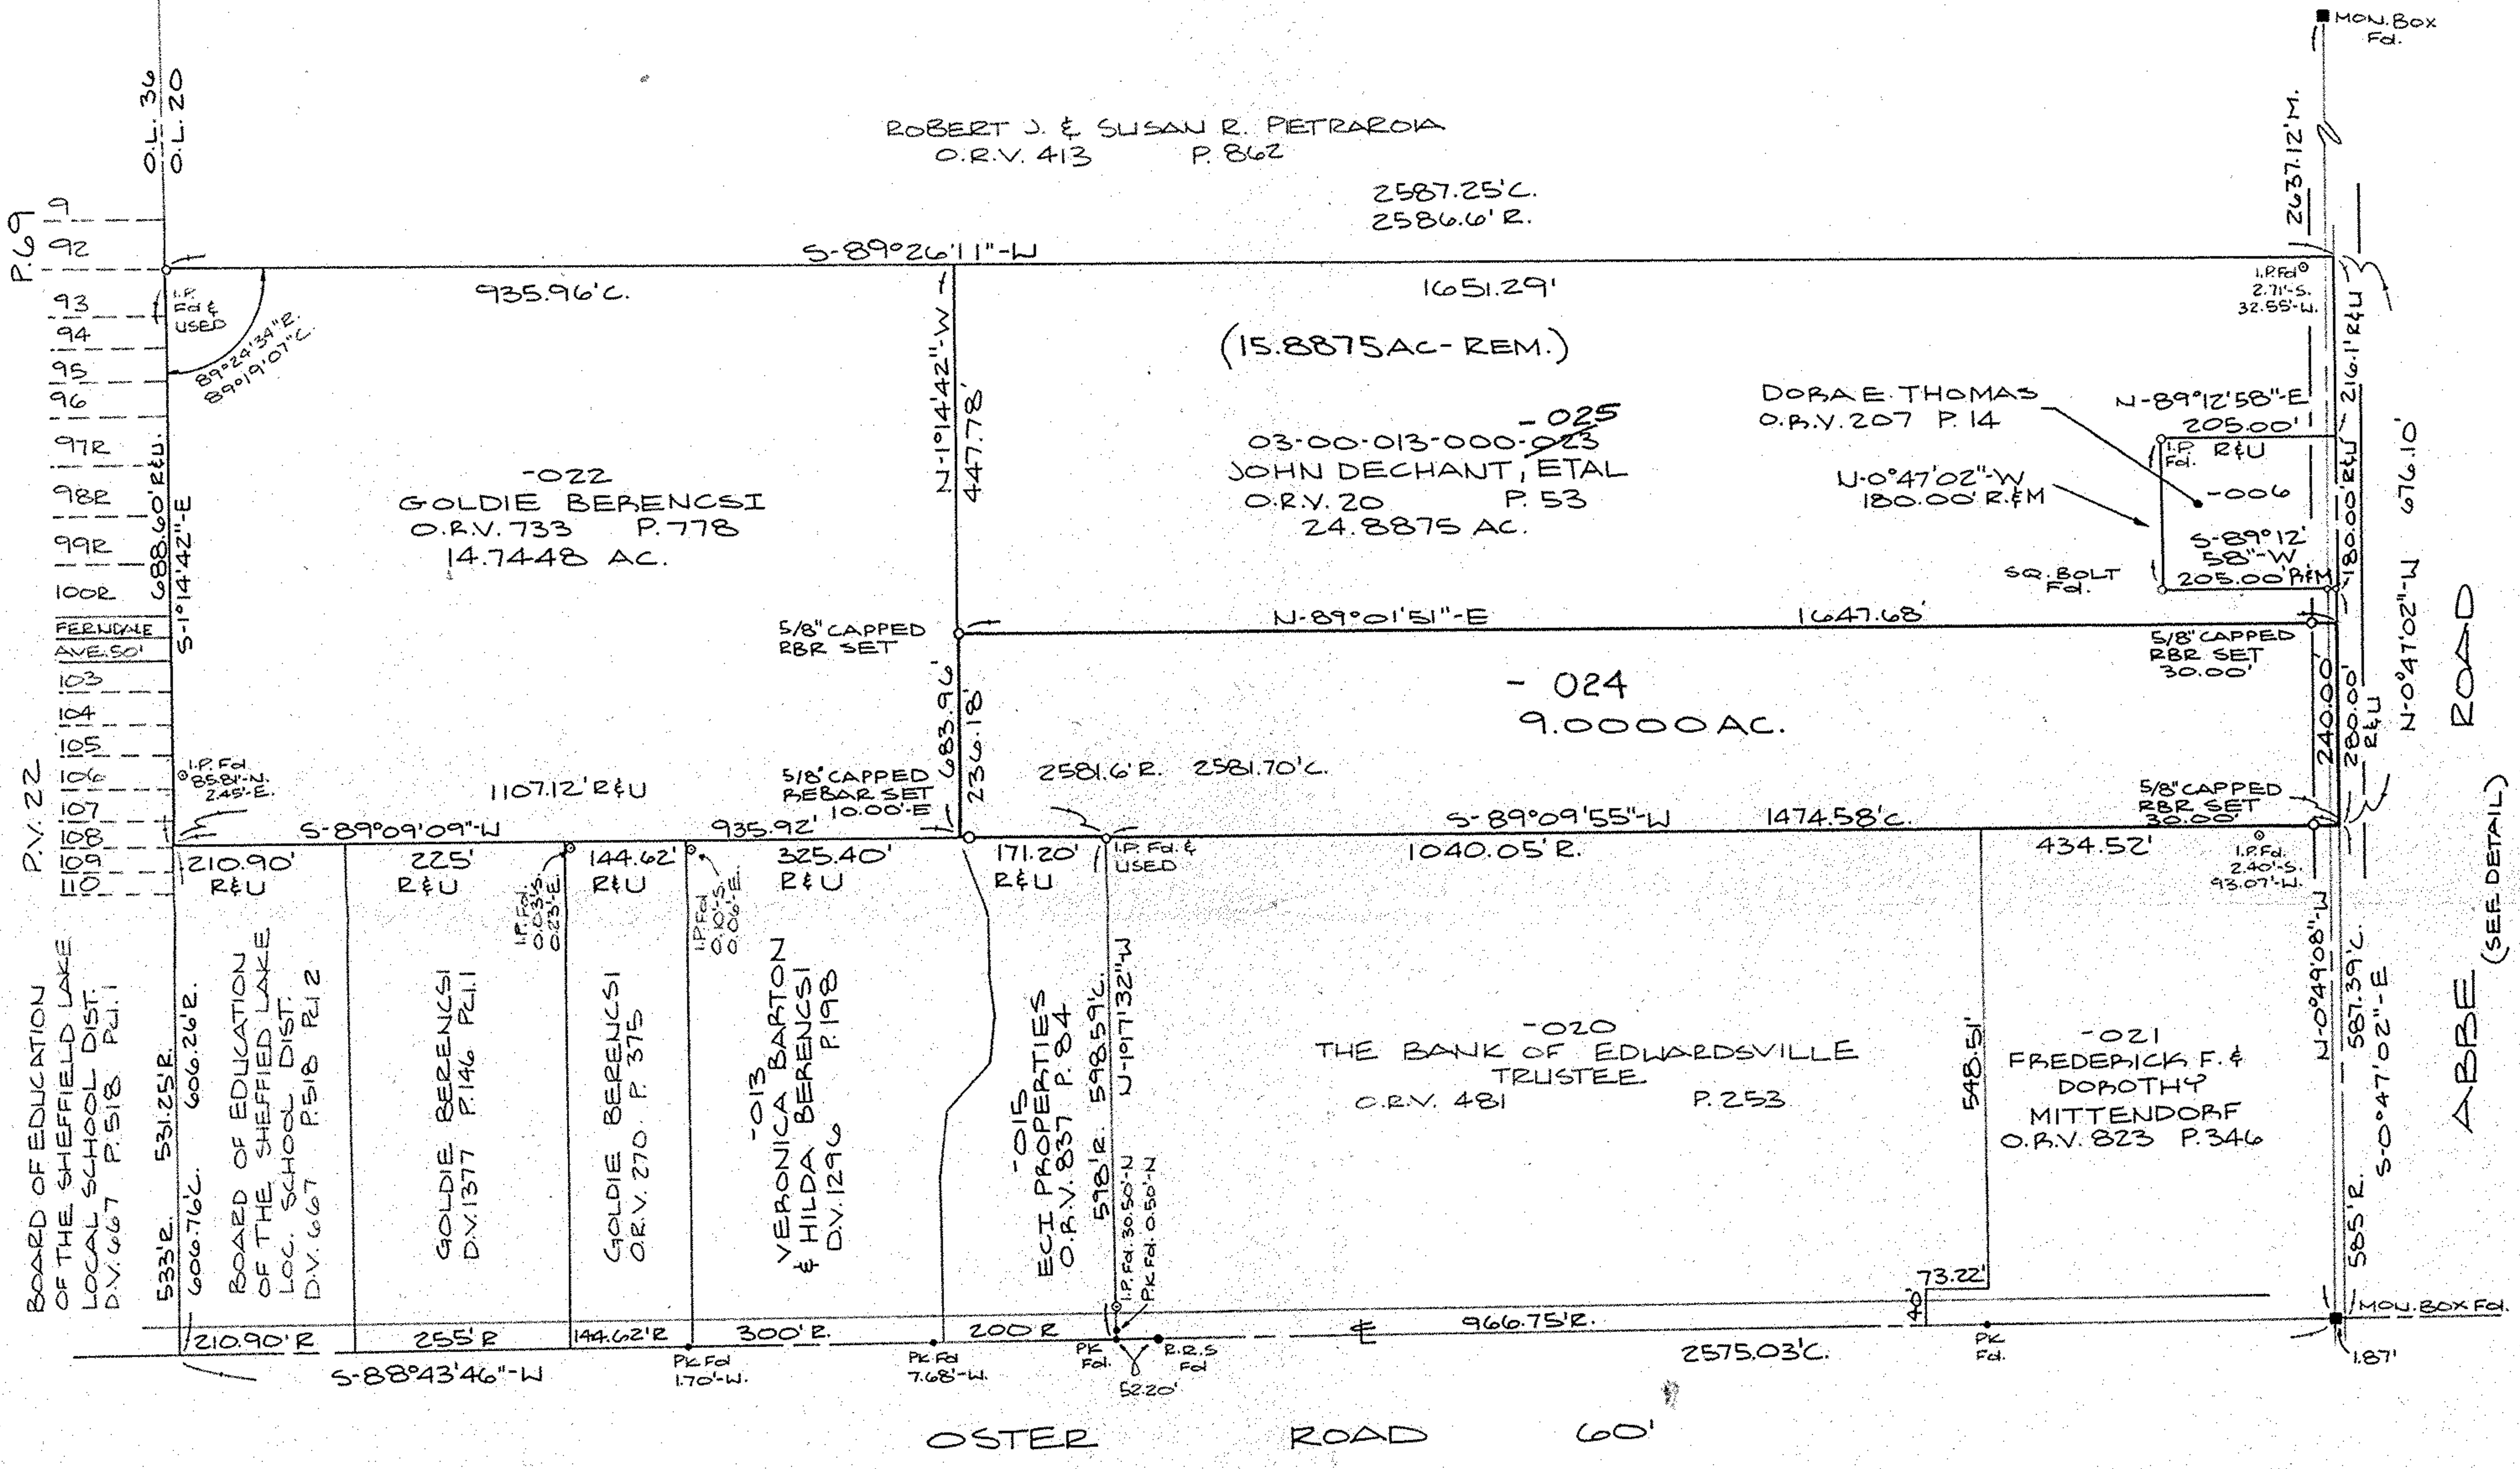


DETAIL - CENTERLINE ABBE ROAD
NOT TO SCALE

21759
APPROVED
LORAIN CO.
MAP DEPT
DATE 5-3-96
PAGE 3-01-020-A B
BY CAROLYN
FRANCIS
21759

SURVEY MAP
PART OF SHEFFIELD TOWNSHIP ORIGINAL LOT NO. 20
VILLAGE OF SHEFFIELD COUNTY OF LORAIN

STATE OF OHIO
DECEMBER 8, 1992
REVISED 3-14-96

KS ASSOCIATES INC.
ENGINEERS SURVEYORS

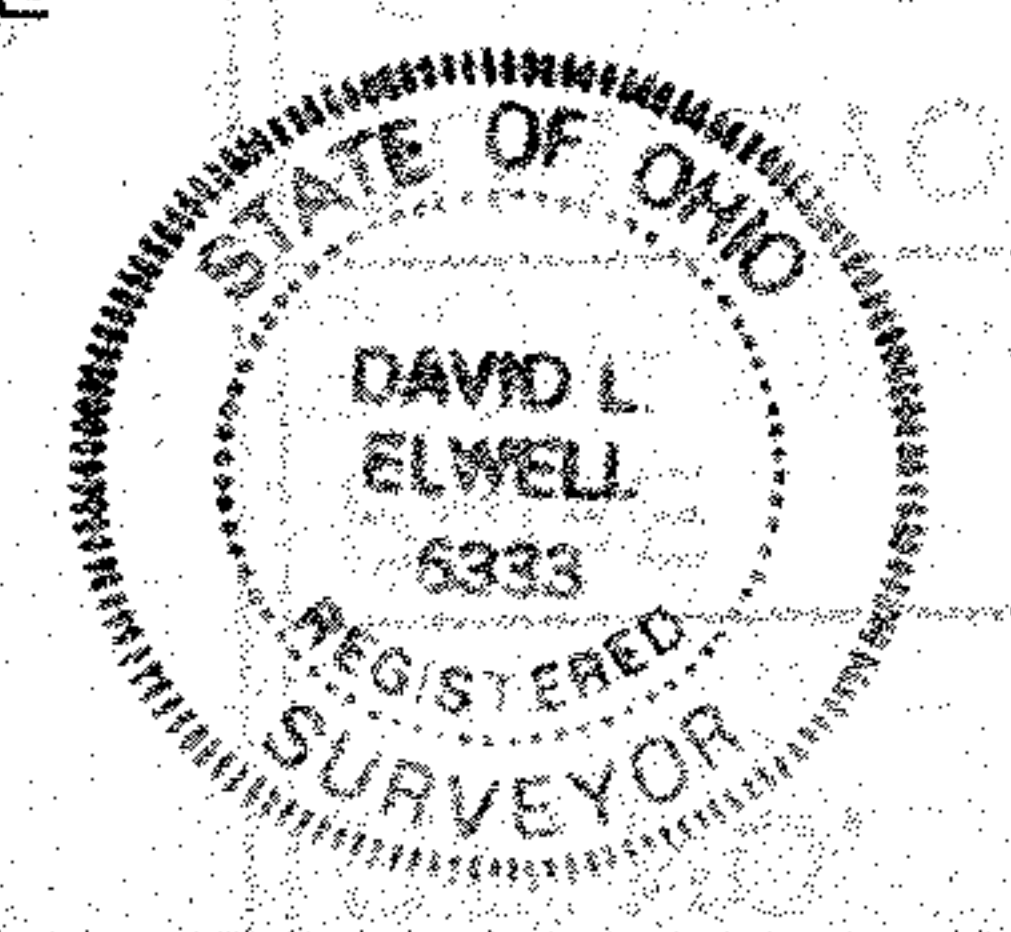

03 - 00 - 020 - 000 - 96049
92-560