


SEE 3-00-016-A

SEE 3-00-017-B

SEE 3-00-006-A

ADD INSIDE DIMENSIONS
1267.52'
1308.32'

150
95
201
146
907

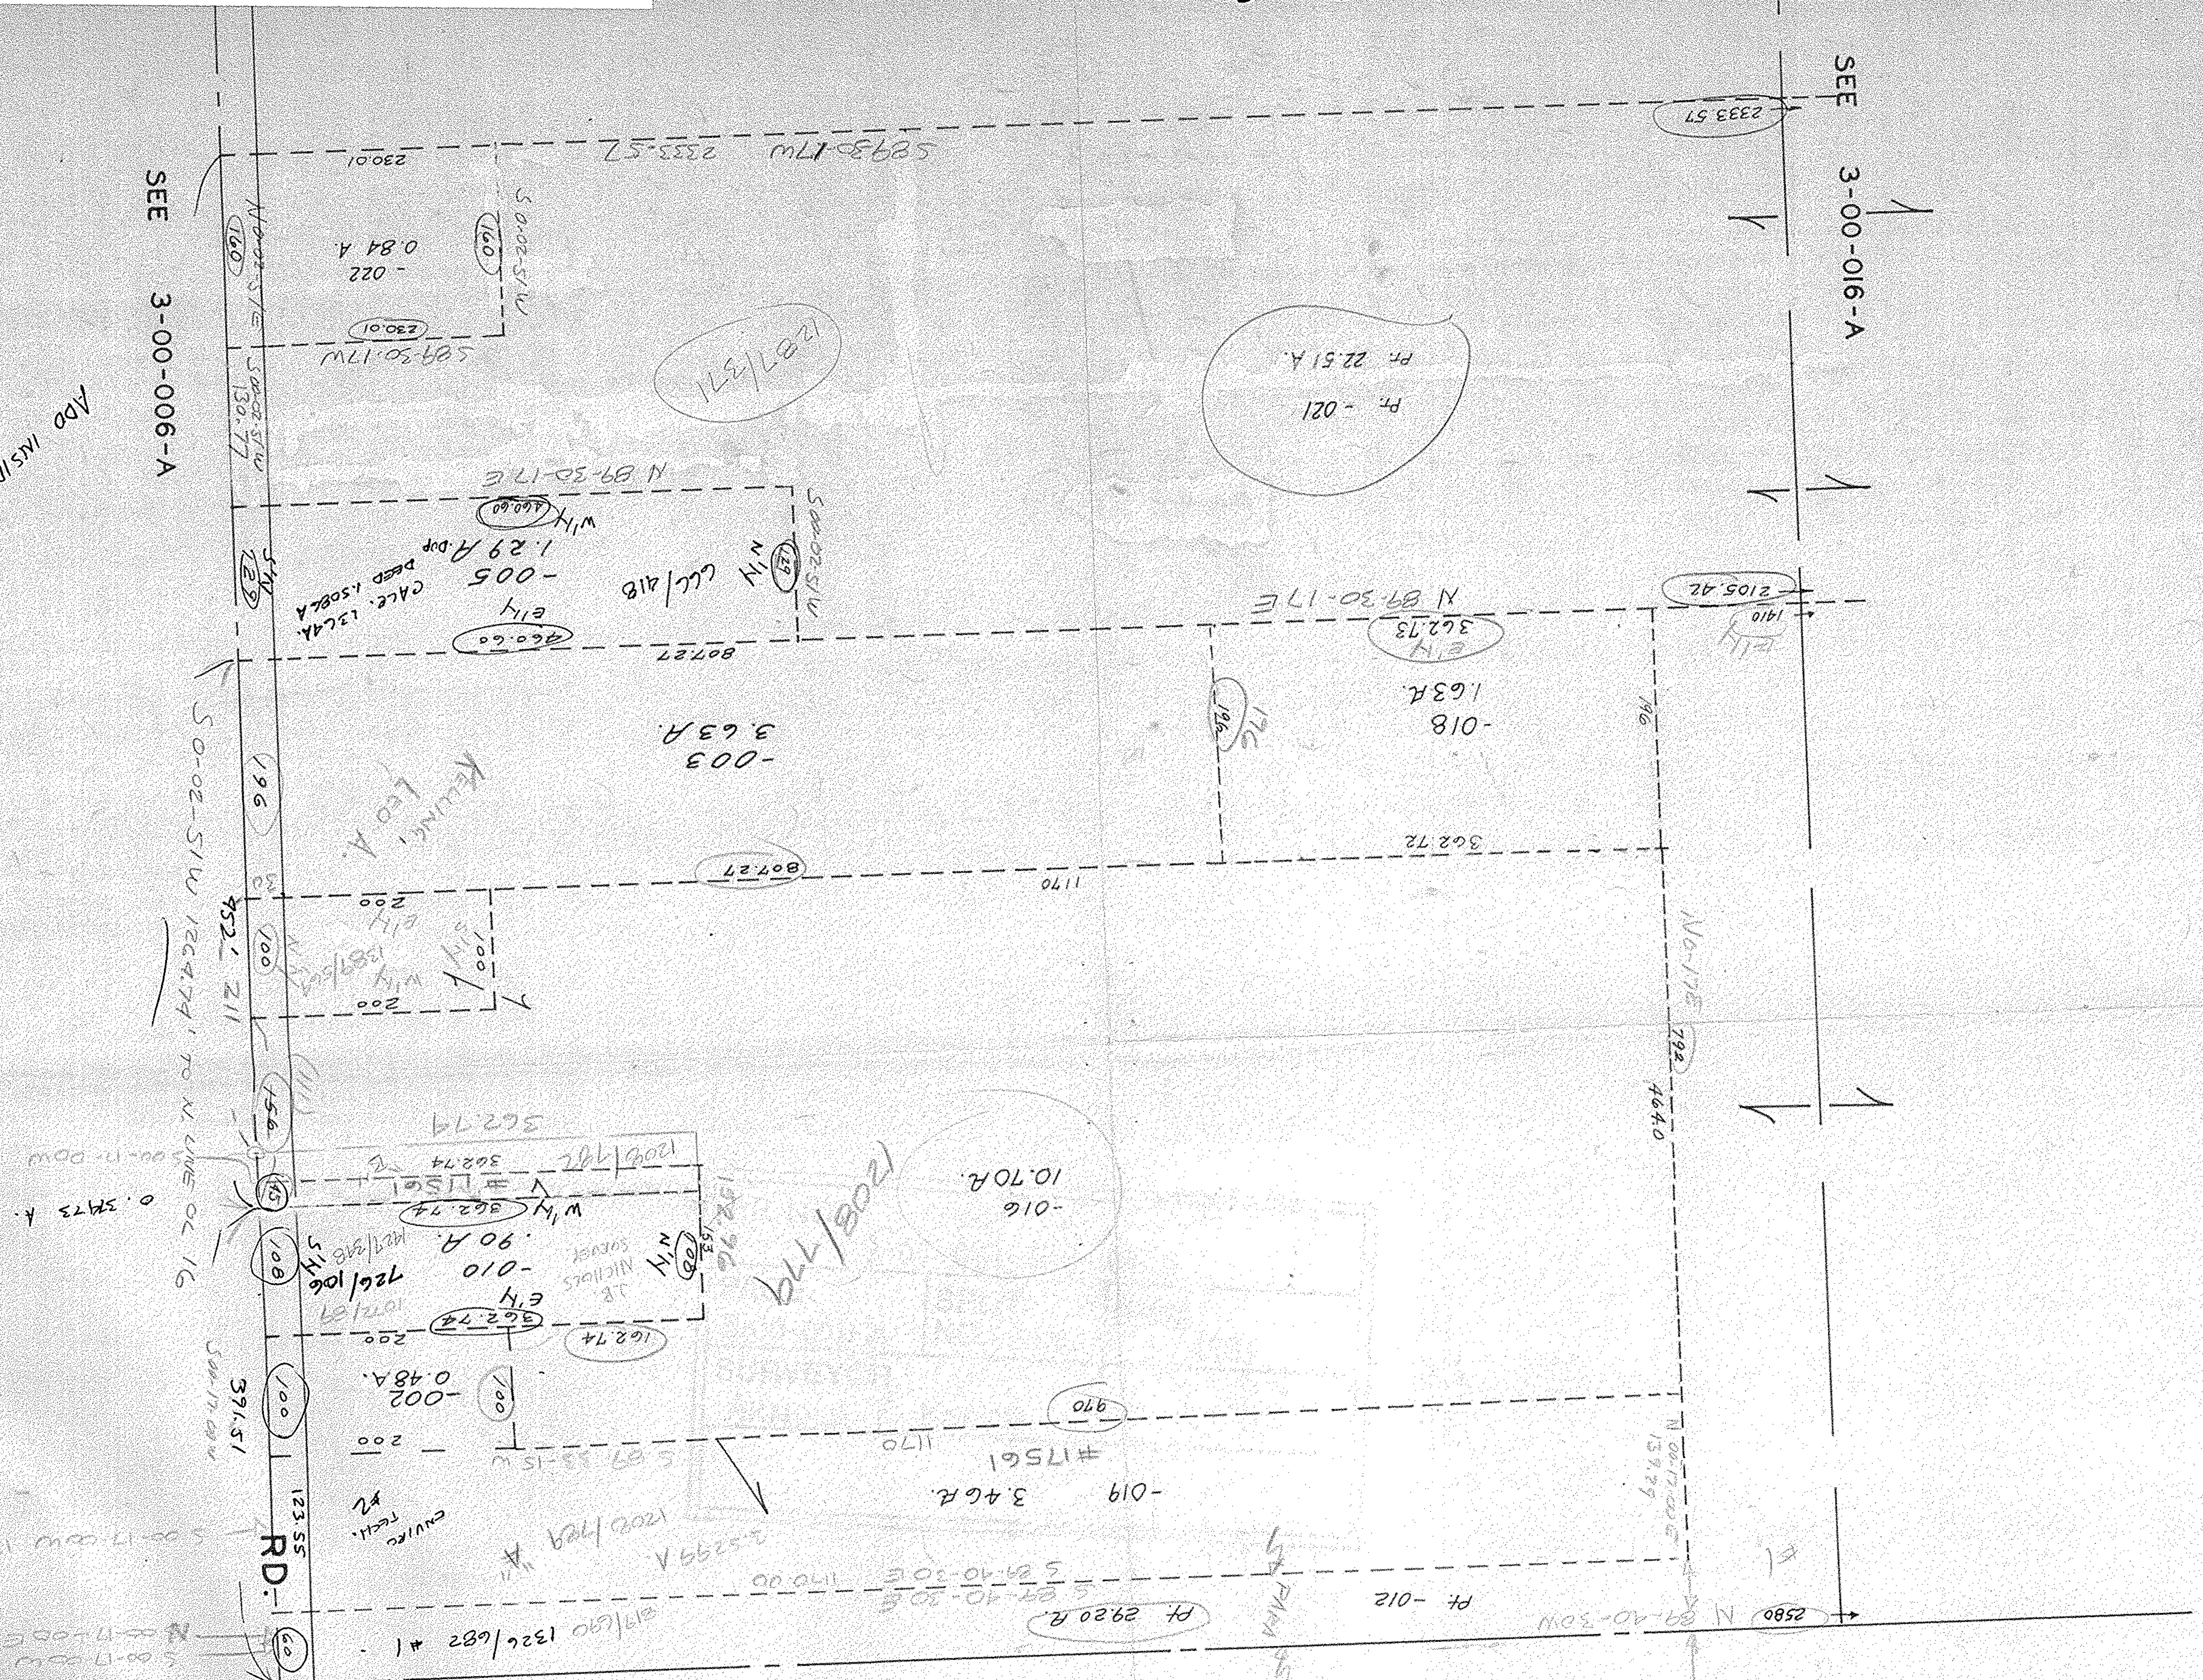

0.52973 A.

S 0-02-51W 1264.74' TO N LINE OF 16'

RD.

No. 17E

SEE