


9-00-094-A

P.P. # 03-00-085-101-004 85

09-00-085-101

OAKWOOD CITY OF LORAIN ZONE AVE

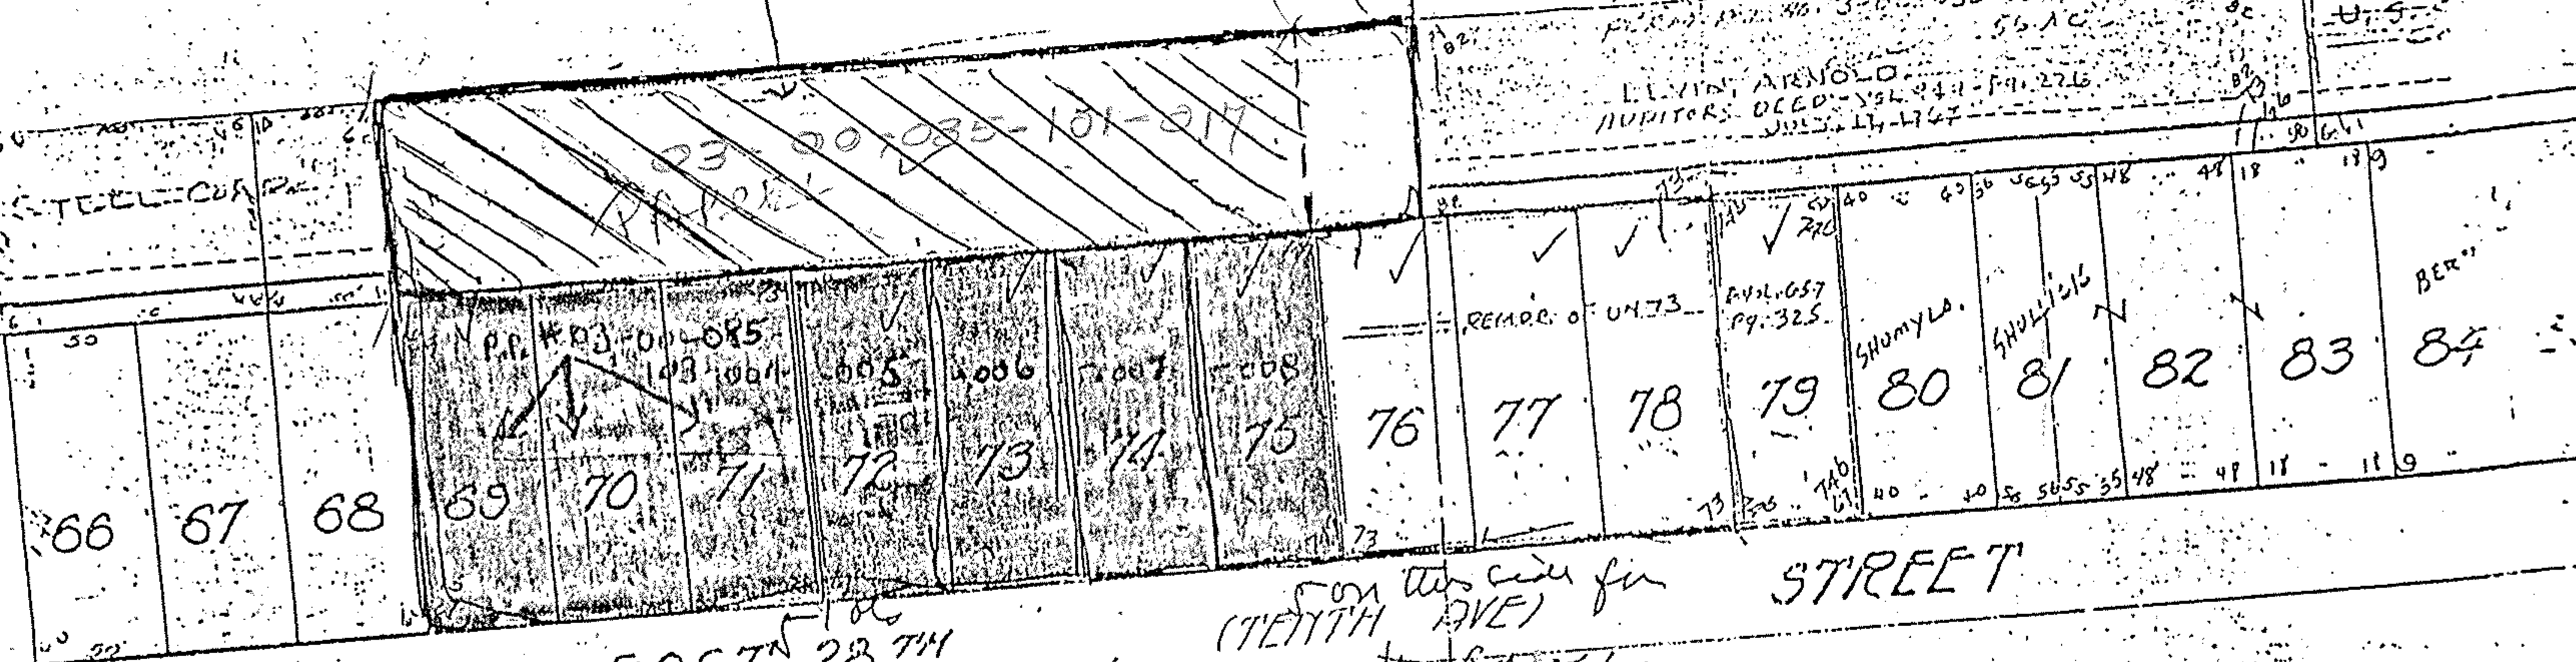

#1904

APPROVED	DATE 8-8-78
LORAIN CO.	PAGE 3-00-094-A
MAP DEPT.	BY T. M. [Signature]
VOID AFTER	

~~RETRACT~~  
 [Handwritten scribbles]  
 So