GENERAL INFORMATION FROM TAX MAPS AND CONSTRUCTION PLANS
(TO BE READ IN CONJUNCTION WITH RIGHT OF WAY PLAN)

ON S.R. 20/10 SEC. 8.21/8.63 (2ND SEC.) LORAIN CO., O. PAR. NO. 150B-WD
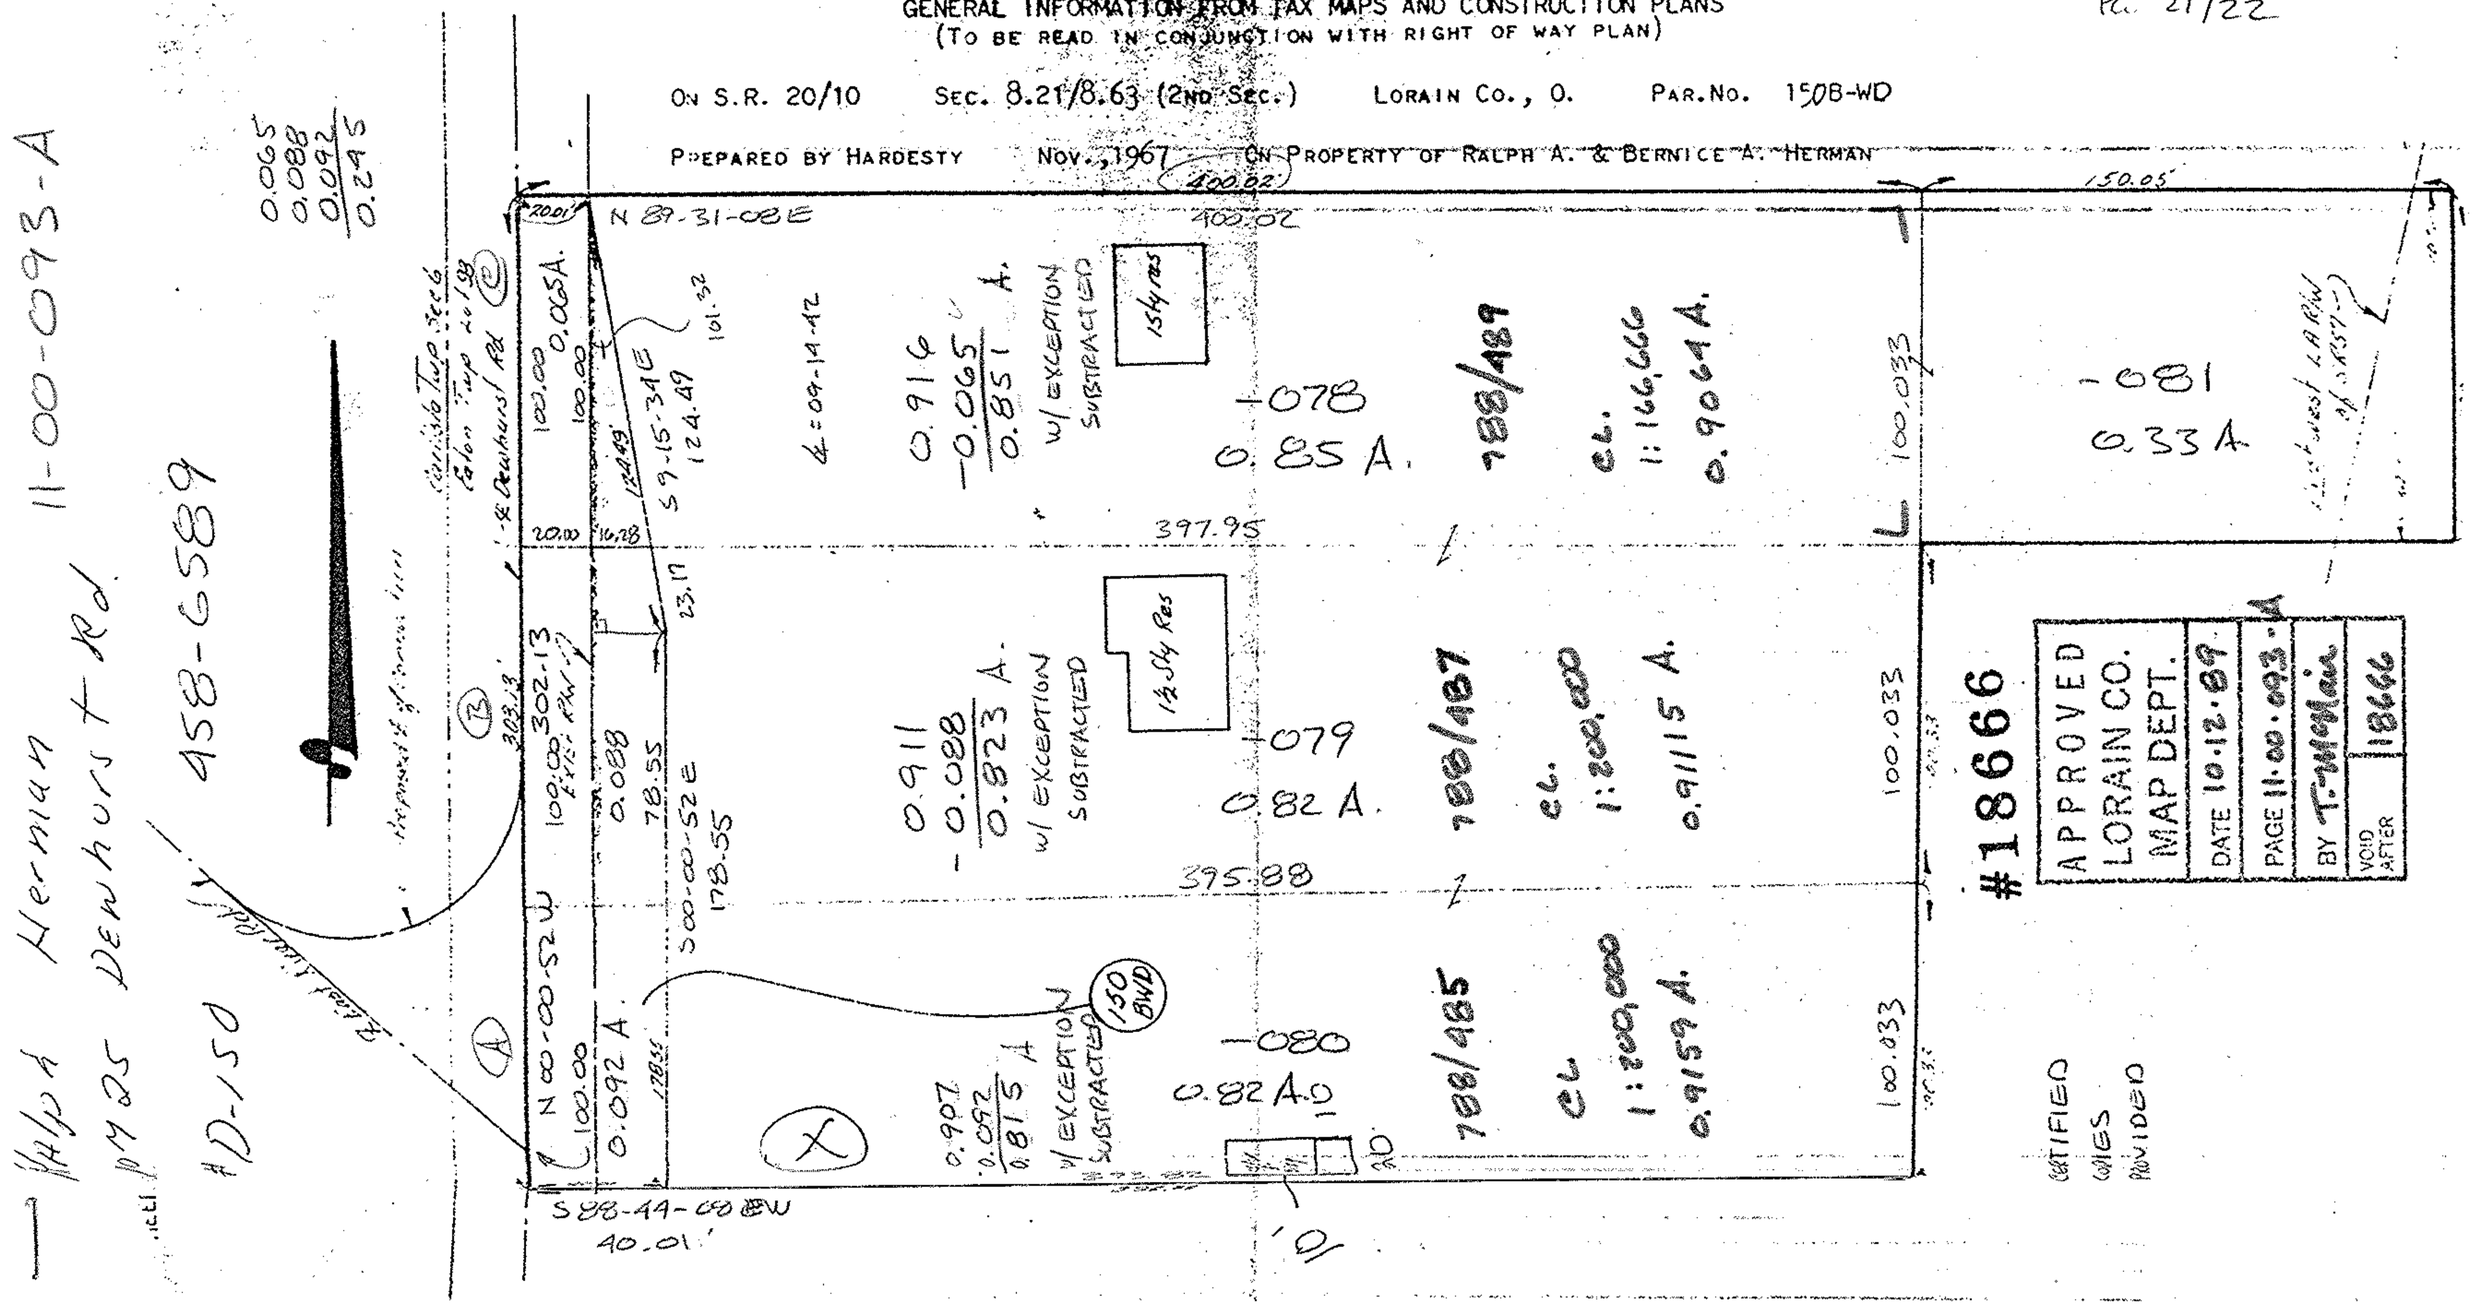
PREPARED BY HARDESTY NOV., 1967 ON PROPERTY OF RALPH A. & BERNICE A. HERMAN