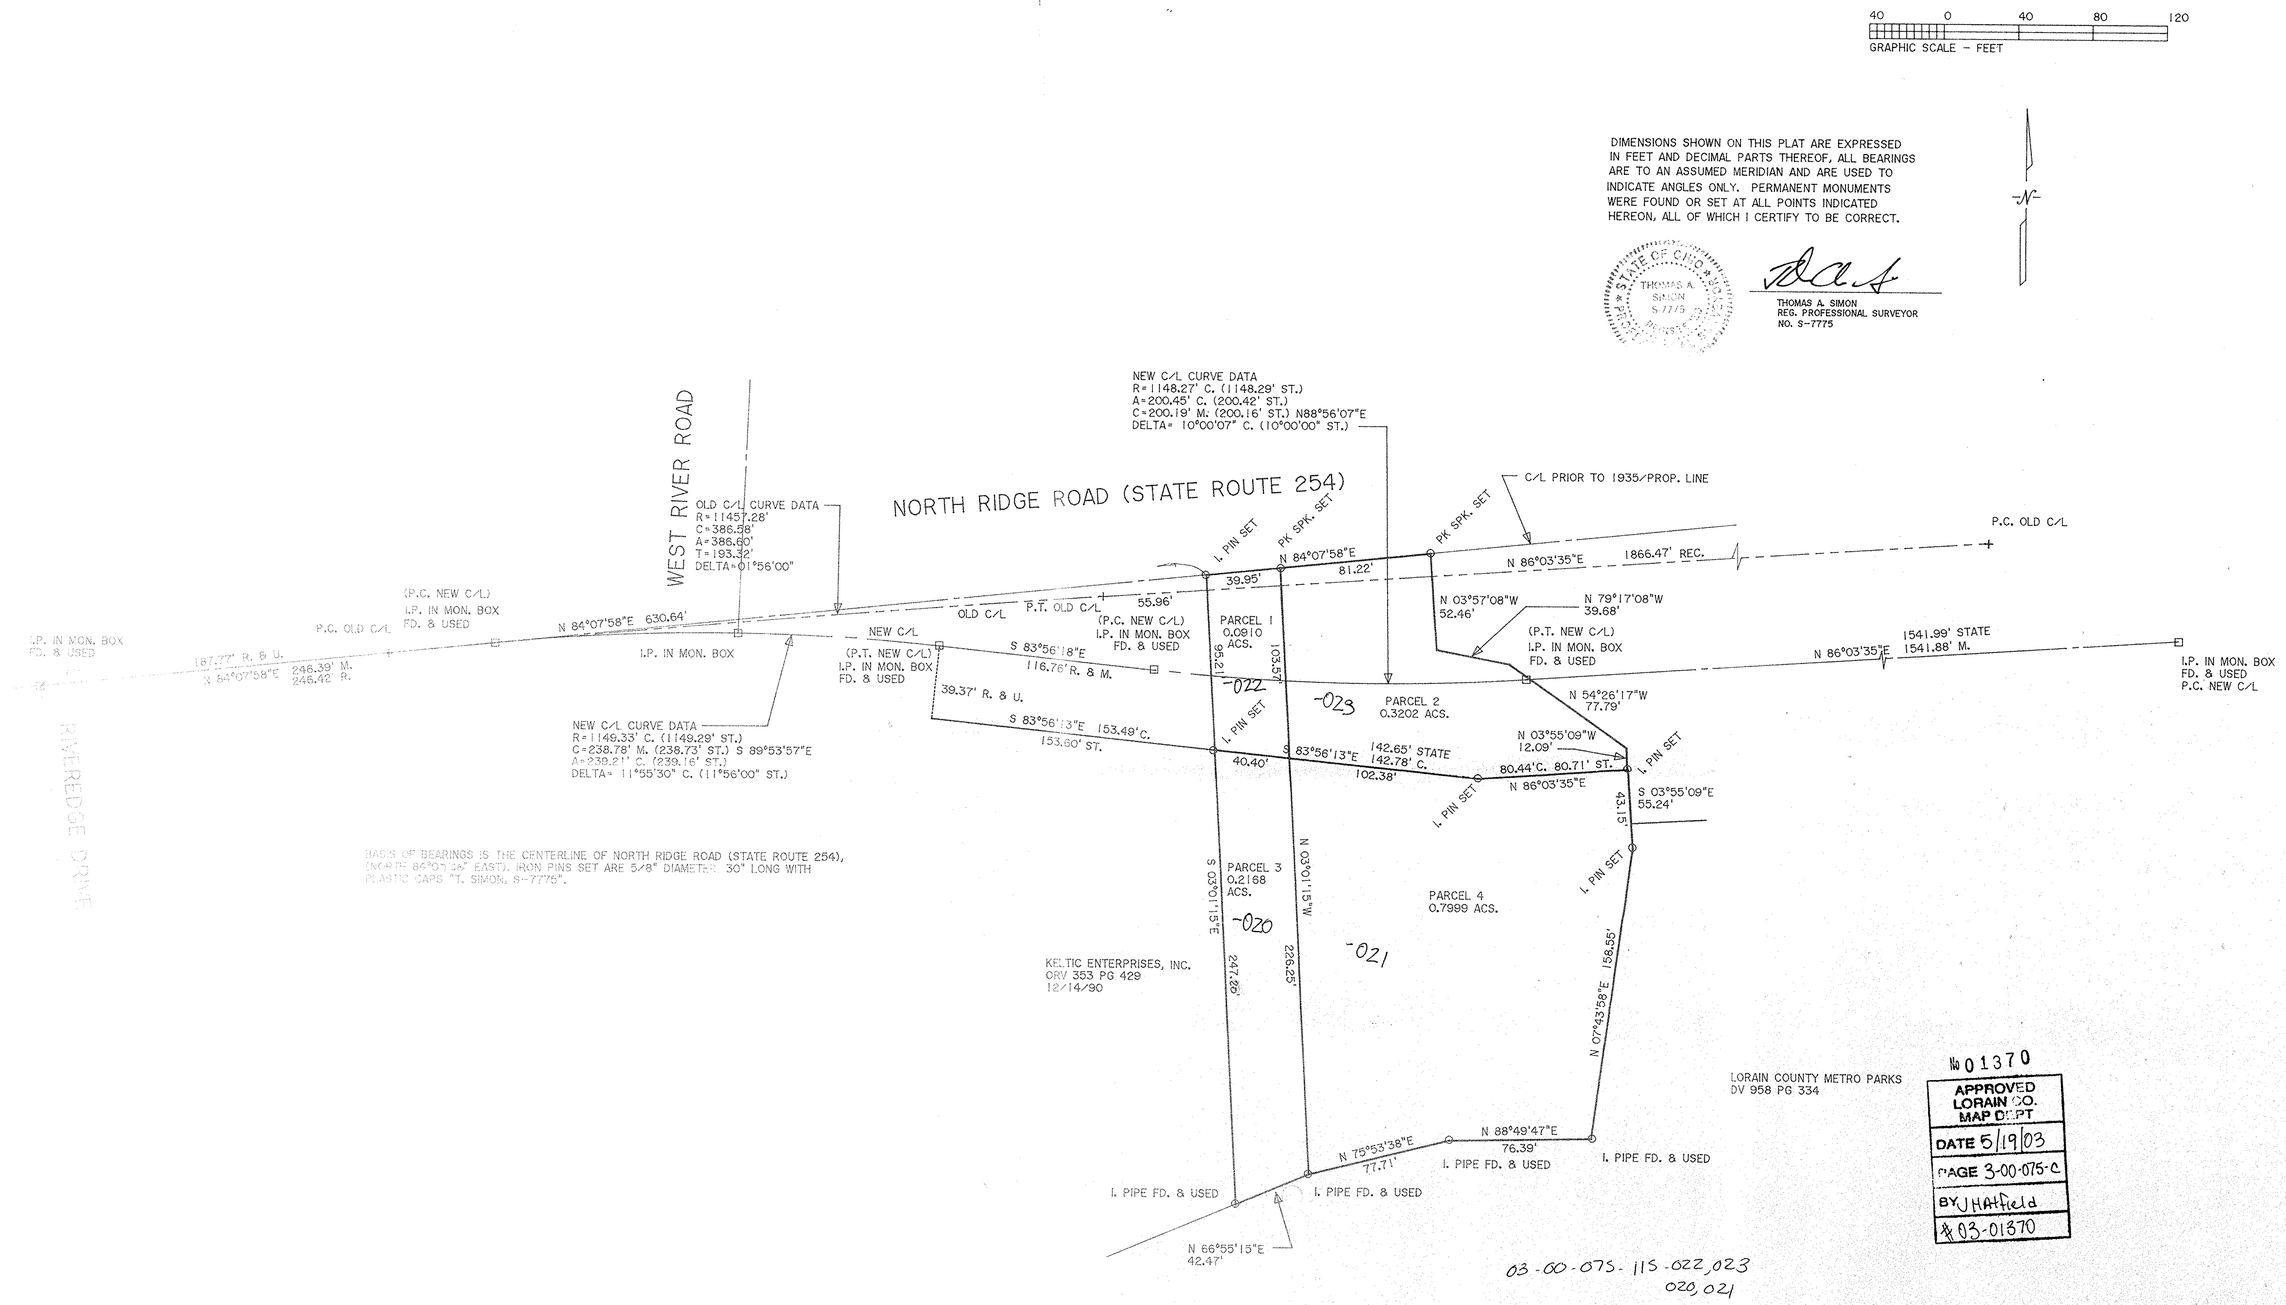

BASIS OF BEARINGS IS THE CENTERLINE OF NORTH RIDGE ROAD (STATE ROUTE 254), (NORTH 84°07'58" EAST). IRON PINS SET ARE 5/8" DIAMETER 30" LONG WITH PLASTIC CAPS "T. SIMON, S-7775".

PLAT OF SURVEY & SPLIT FOR THE STATE OF OHIO AND LORAIN COUNTY METRO PARKS

BEING KNOWN AS PART OF ORIGINAL SHEFFIELD TOWNSHIP
LOT NO. 75

COUNTY OF LORAIN STATE OF OHIO
SEPTEMBER, 2002 SCALE: 1" = 40'

REV. 1/20/2003 C/L PRIOR TO 1935 ADDED

JOB NO. 2002-057