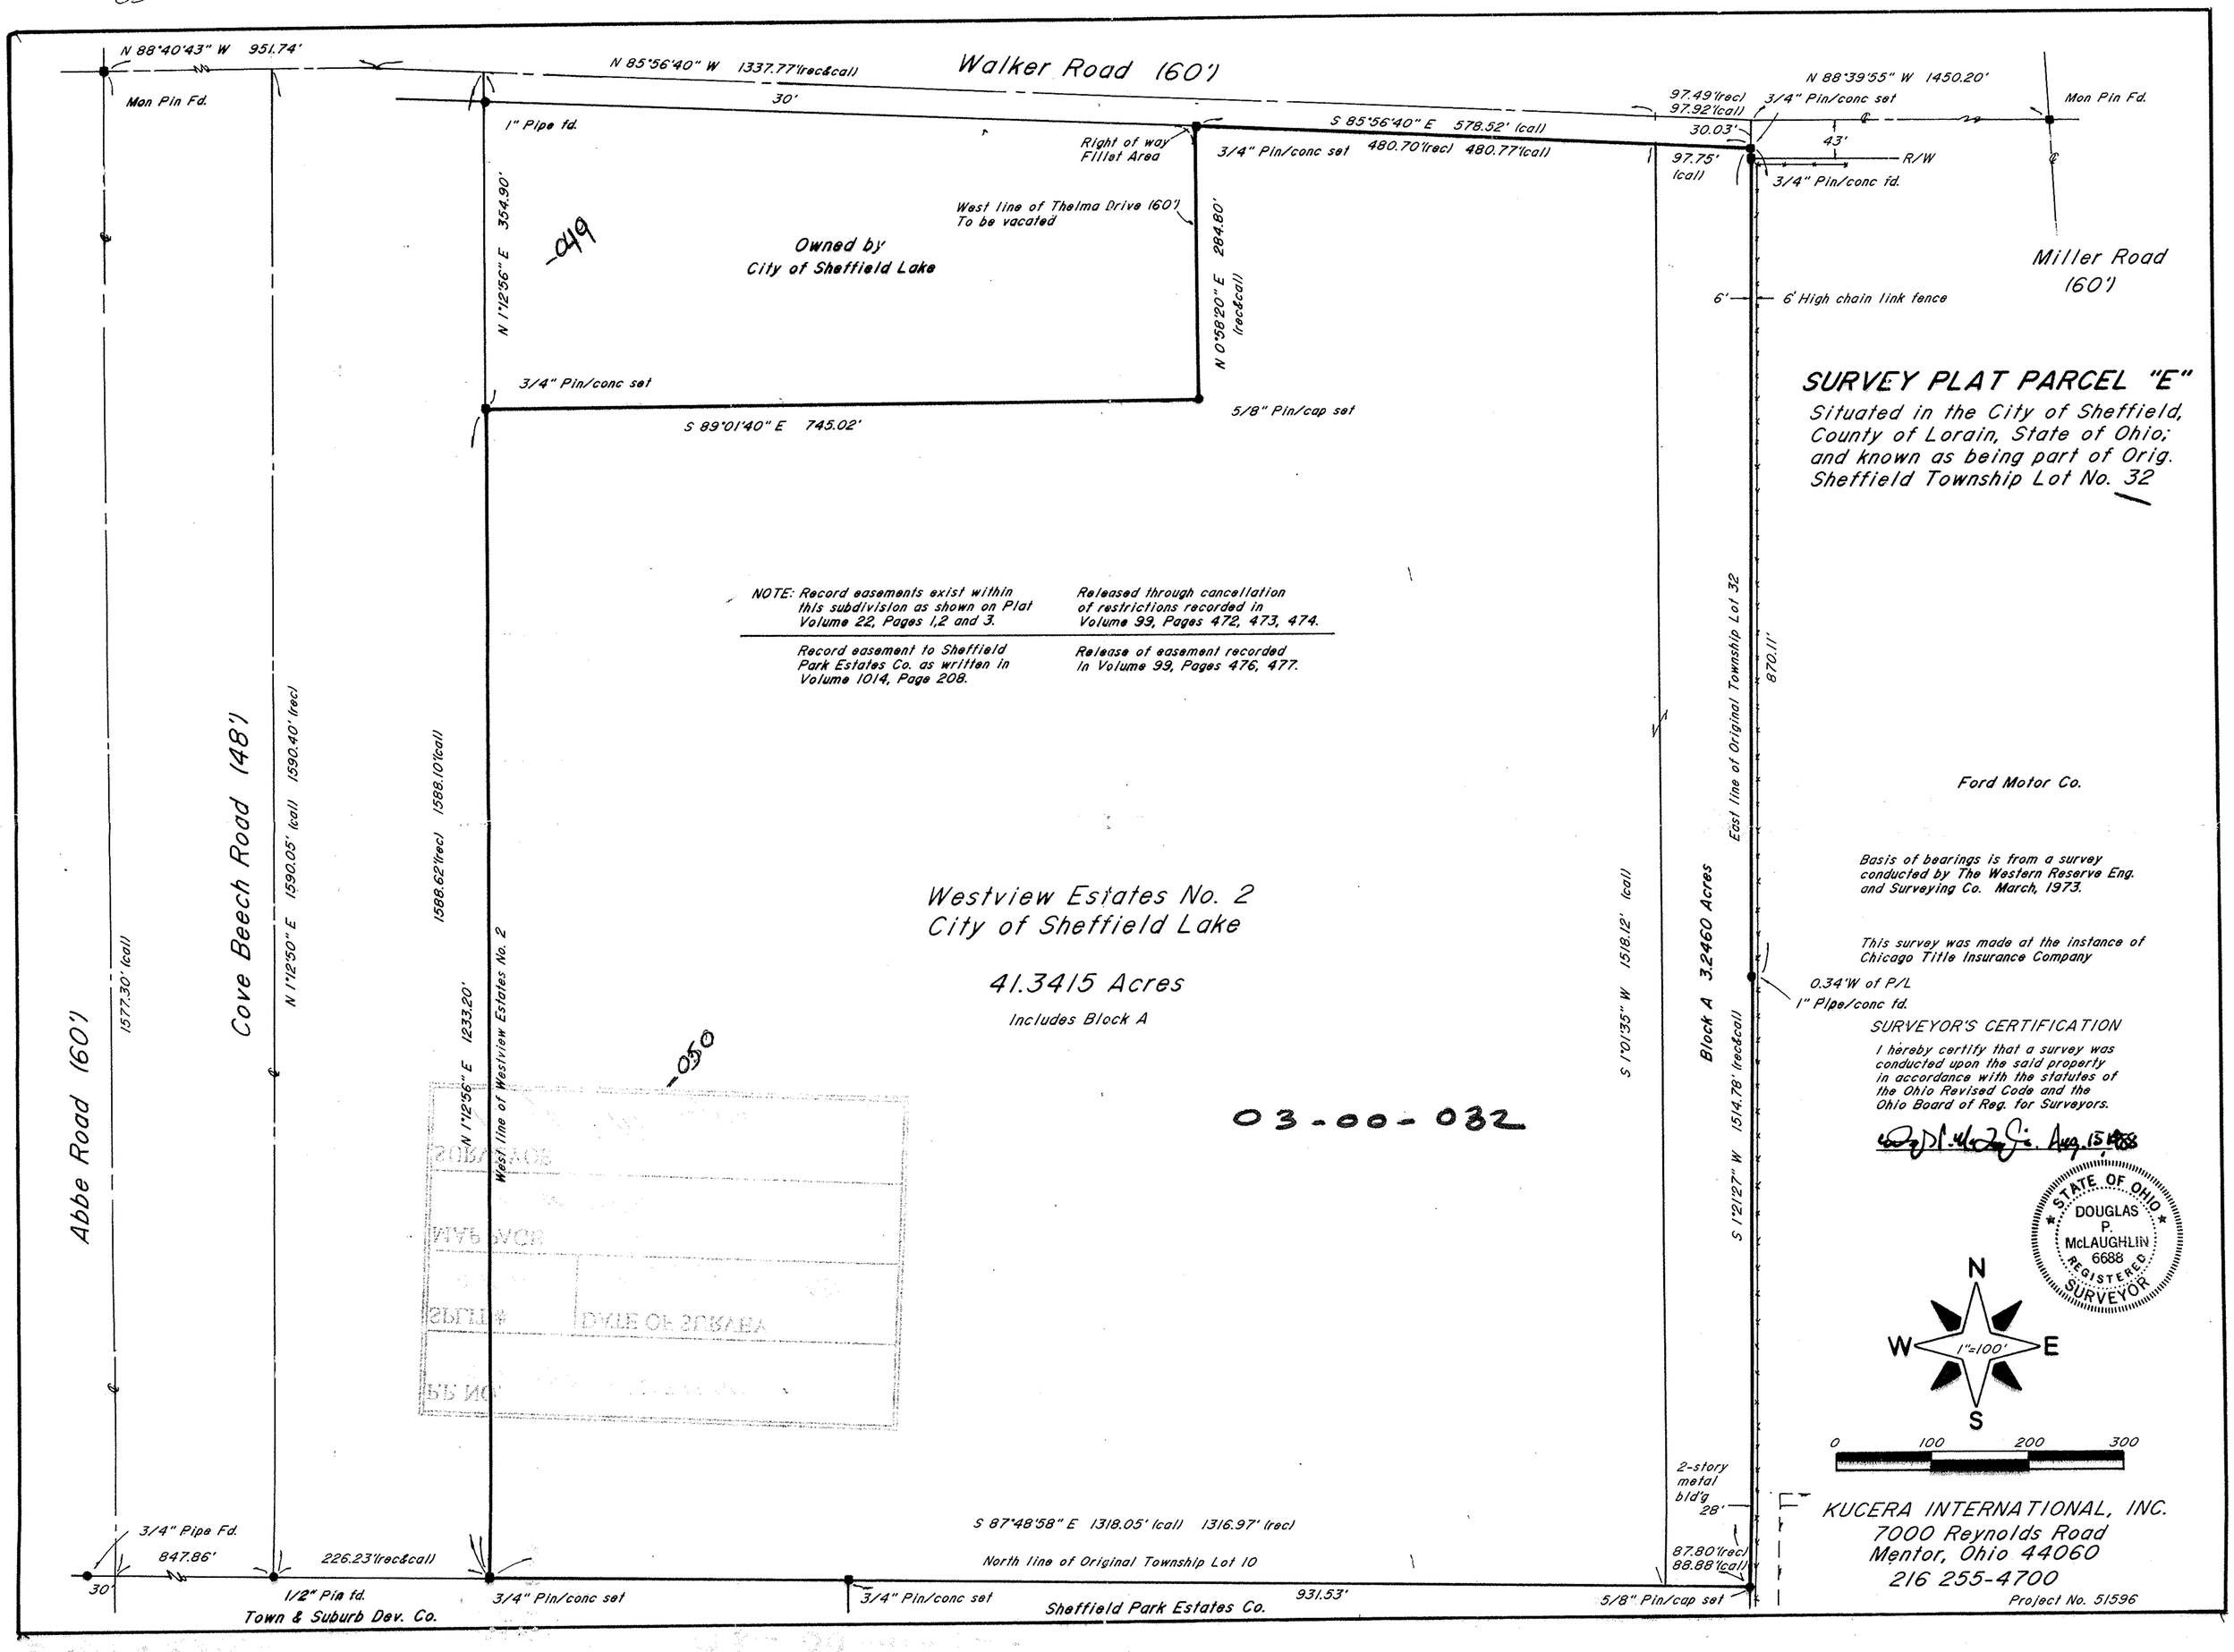03-00-032-100-049,050