03-00-076-112-007, 008
Appl # 21878
Page # 03-00-076-B

SURVEY MAP
FOR PERM. PARCEL NO. 03-00-076-112-004
SITUATED IN THE VILLAGE OF SHEFFIELD, LORAIN COUNTY
STATE OF OHIO AND KNOWN AS BEING PART OF ORIGINAL
SHEFFIELD TOWNSHIP LOTS. NO. 75 AND 76.
Vol. 969 Pg. 823

BEARINGS SHOWN HEREON ARE TO AN ASSUMED MERIDIAN AND ARE USED FOR THE PURPOSE OF DESCRIBING ANGLES ONLY.

⊡ = MONUMENT FOUND
● = IRON PIN FOUND
○ = IRON PIN SET

NOTE:
RLCWA 20' EASEMENT SHOWN IS BASED ON MOST CURRENT AVAILABLE RECORDS. ACTUAL FIELD LOCATION OF WATER LINE MAY VARY.

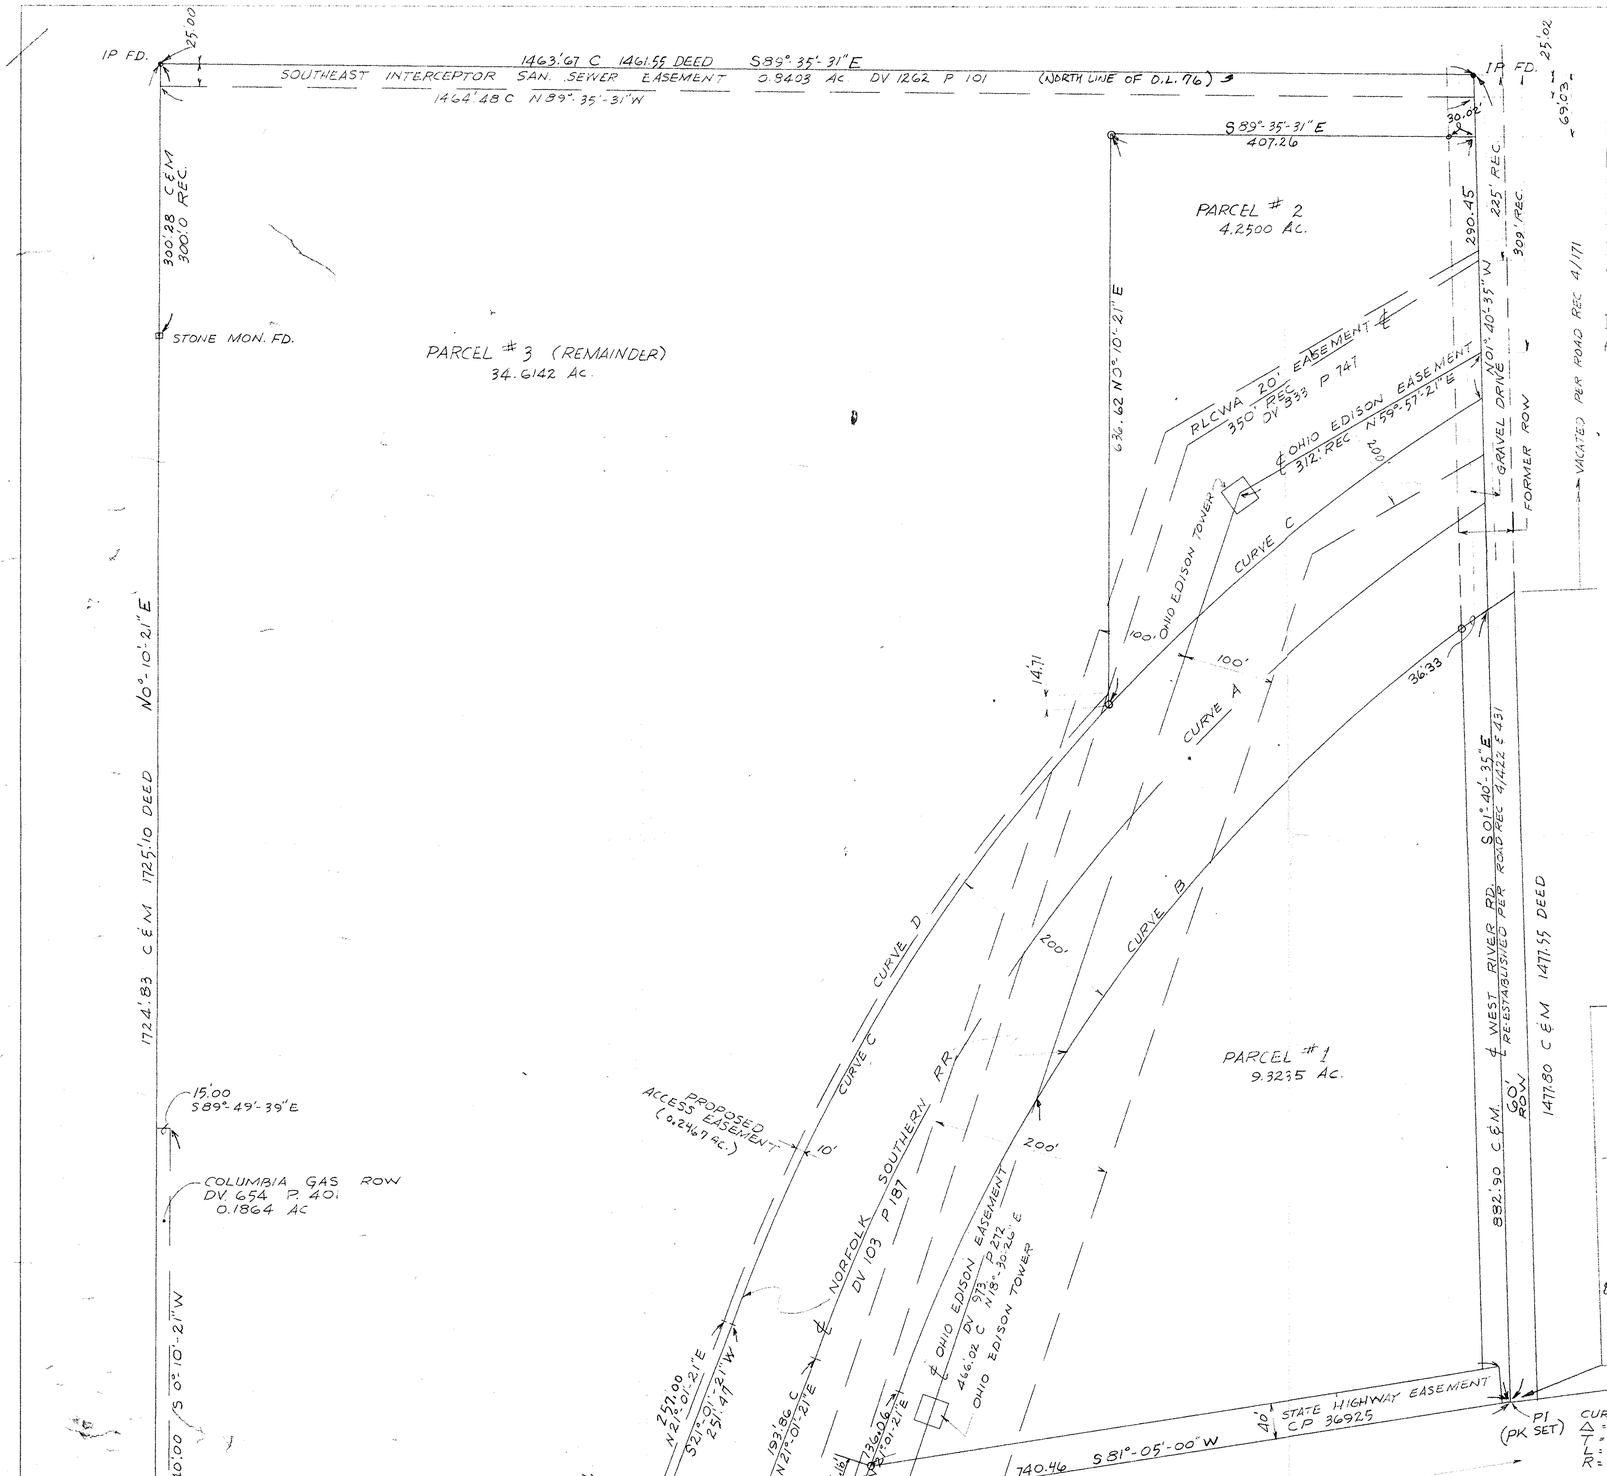

SCALE 1" 80'

PARCEL	CURVE	LENGTH	RADIUS	CHORD	BEARING
℄ RR	A	1231.98 CALC.	1910.08	1210.75	N 38°-04'-39" E
1	B	1107.55	1810.08	1090.36	N 37°-02'-40" E
2	C	542.34	2010.08	540.70	S 50°-34'-28" W
3	C	813.03	2010.08	807.50	S 31°-15'-29" W
3	D	827.39	2020.08	822.11	N 31°-24'-41" E

#21878

APPROVED
LORAIN CO.
MAP DEPT.
DATE 8-12-96
PAGE 3-00-076B
BY K.DNE
WHO ATTOR 121978

Doug Mosley
DOUG MOSLEY
REG. SURVEYOR NO. 6303

BRAMHALL
ENGINEERING & SURVEYING COMPANY
1926 OLD CENTER ROAD
AVON, OHIO 44011
(216) 937-5778

STATE OF OHIO
DOUGLAS H. MOSLEY
6303
REGISTERED
PROFESSIONAL SURVEYOR

REVISIONS
REV. 1 7/29/96 ADJUST BOUNDARY SURVEY PP#03-00-076-112-004

DATE: 7/10/96
DRAWN BY: mcb
DWG NAME: BGLR

P-254