



01-00-002-111

#15480

1-00-002-B

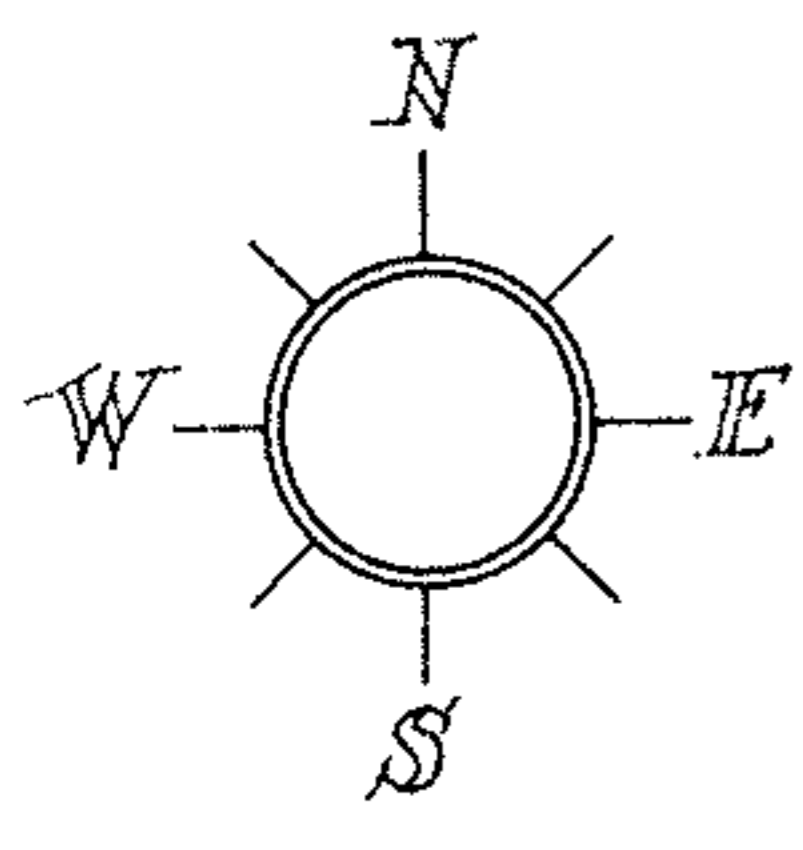

P.P.N. 01-00-002-111-075
076

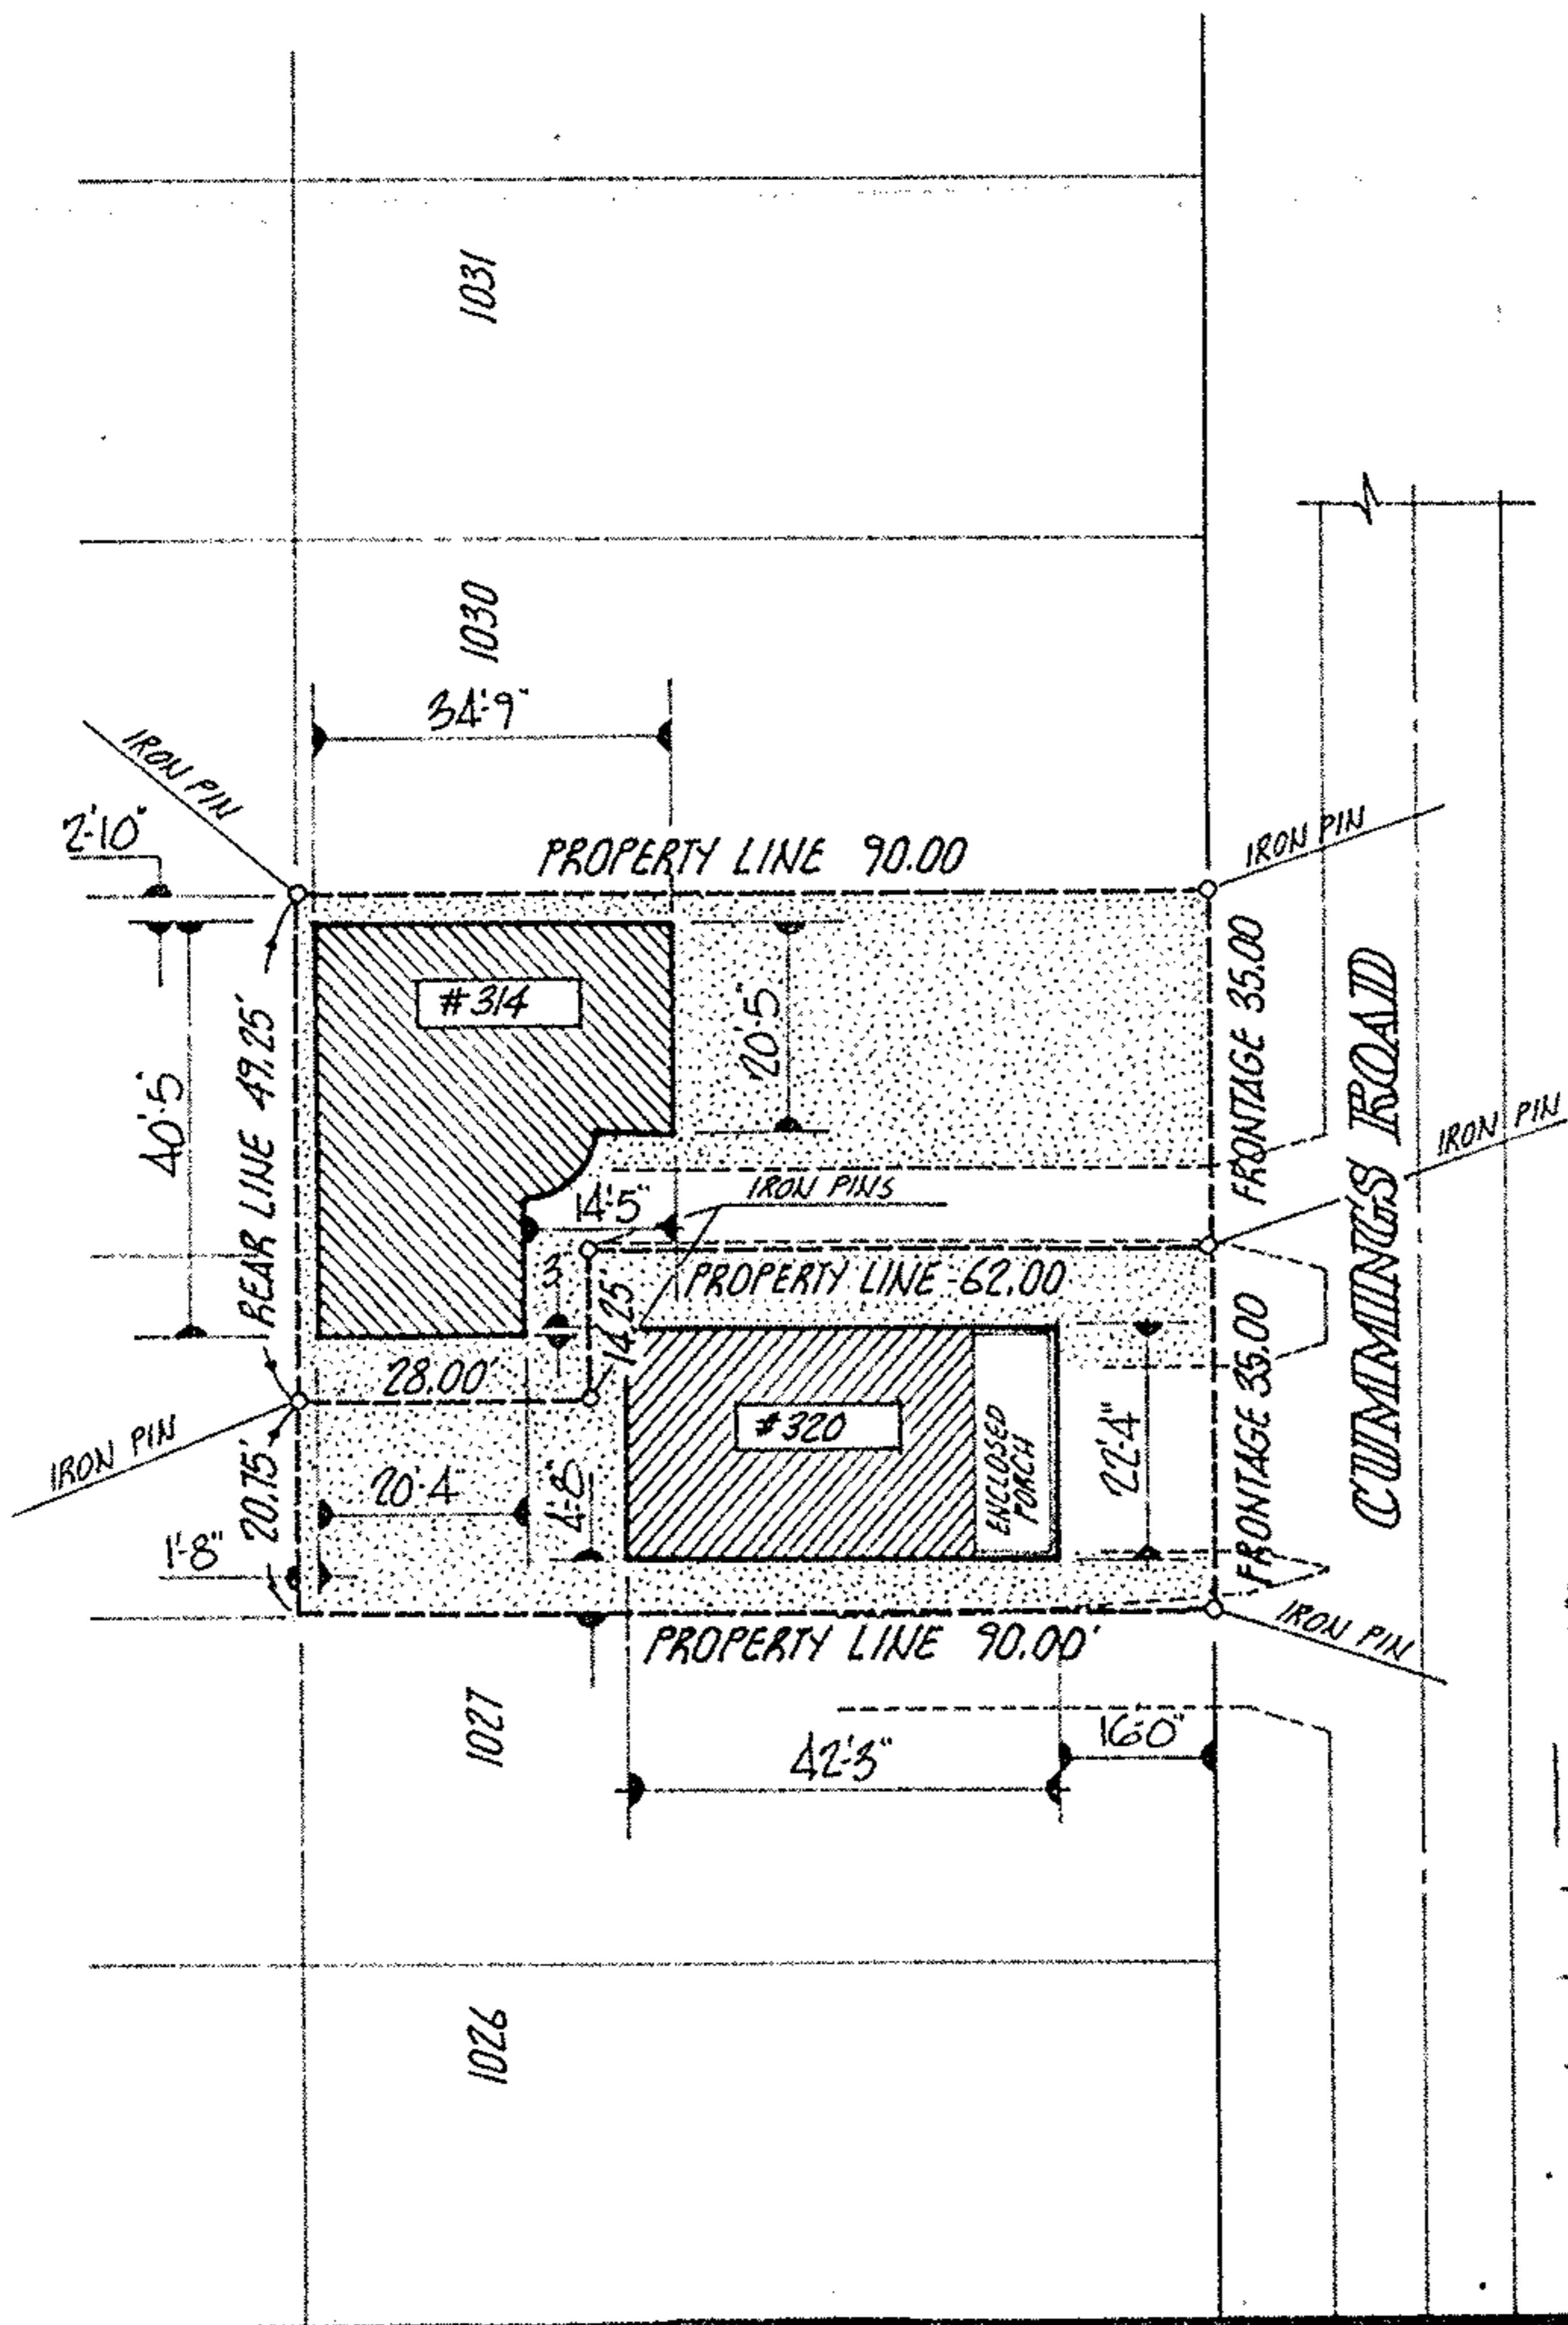

#15480
 APPROVED
 LORAIN CO.
 MAP DEPT.
 DATE 3.22.84
 PAGE 1-00-002-B
 BY T. McMan

ACREAGE ---

DATE 02-15-84

DRAWN MGH

SCALE 1" = 30' ft.

PREPARED FOR MR. DOUG KIETH

MICHAEL G. HURA, registered surveyor
12706 MASON RD., VERMILION, O., Ph(216) 965 4040



PERIMETER SURVEY

SUBLOT(s) 1028 & 1029 of VERMILION-ON-THE-LAKE
 SUBDIVISION No. 1, Volume 10 Page 18 of PLATS
 PART OF O.L. _____ TRACT _____ SECTION _____ OF
 BROWNHELM TOWNSHIP LORAIN CO., OHIO
 PERMANENT PARCEL No. _____

CITY OF VERMILION