


By Arnold F. Kaupp Registered Surveyor No. 1306

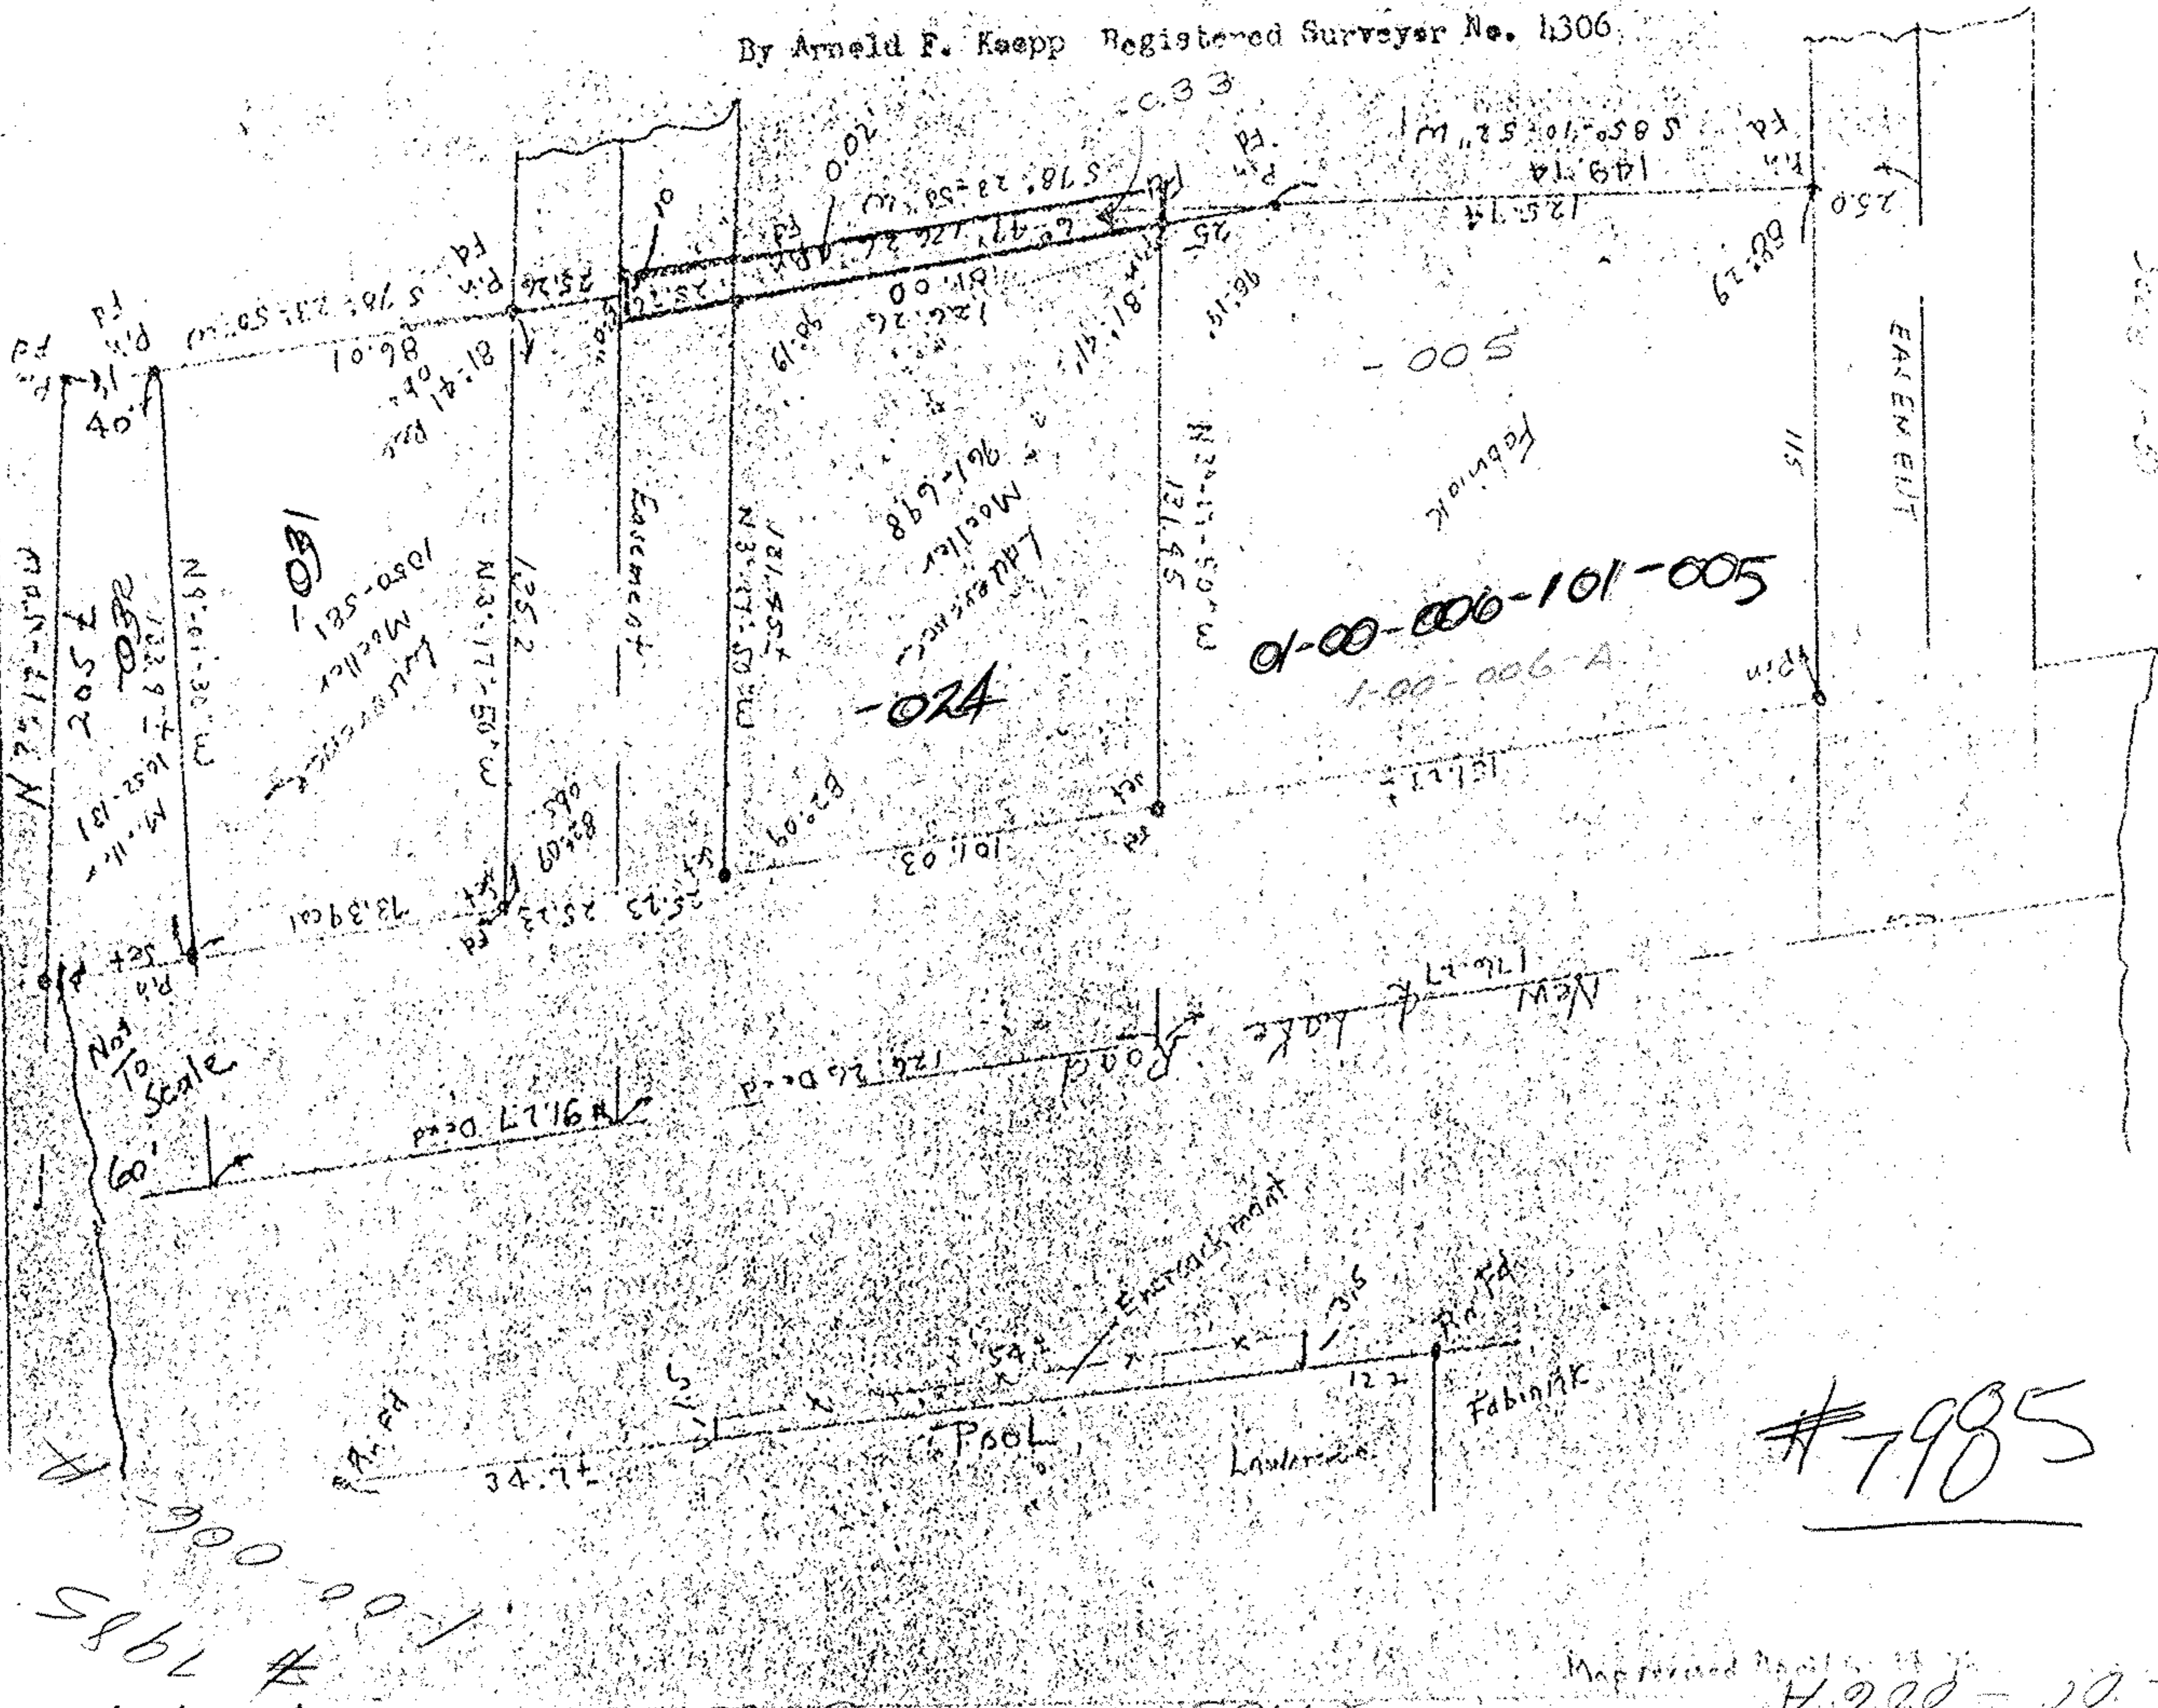

1-00-006-101-005

#7985

#7985

01-00-006-101-005, 074, 031, 032

#7985

1-00-006-101-006