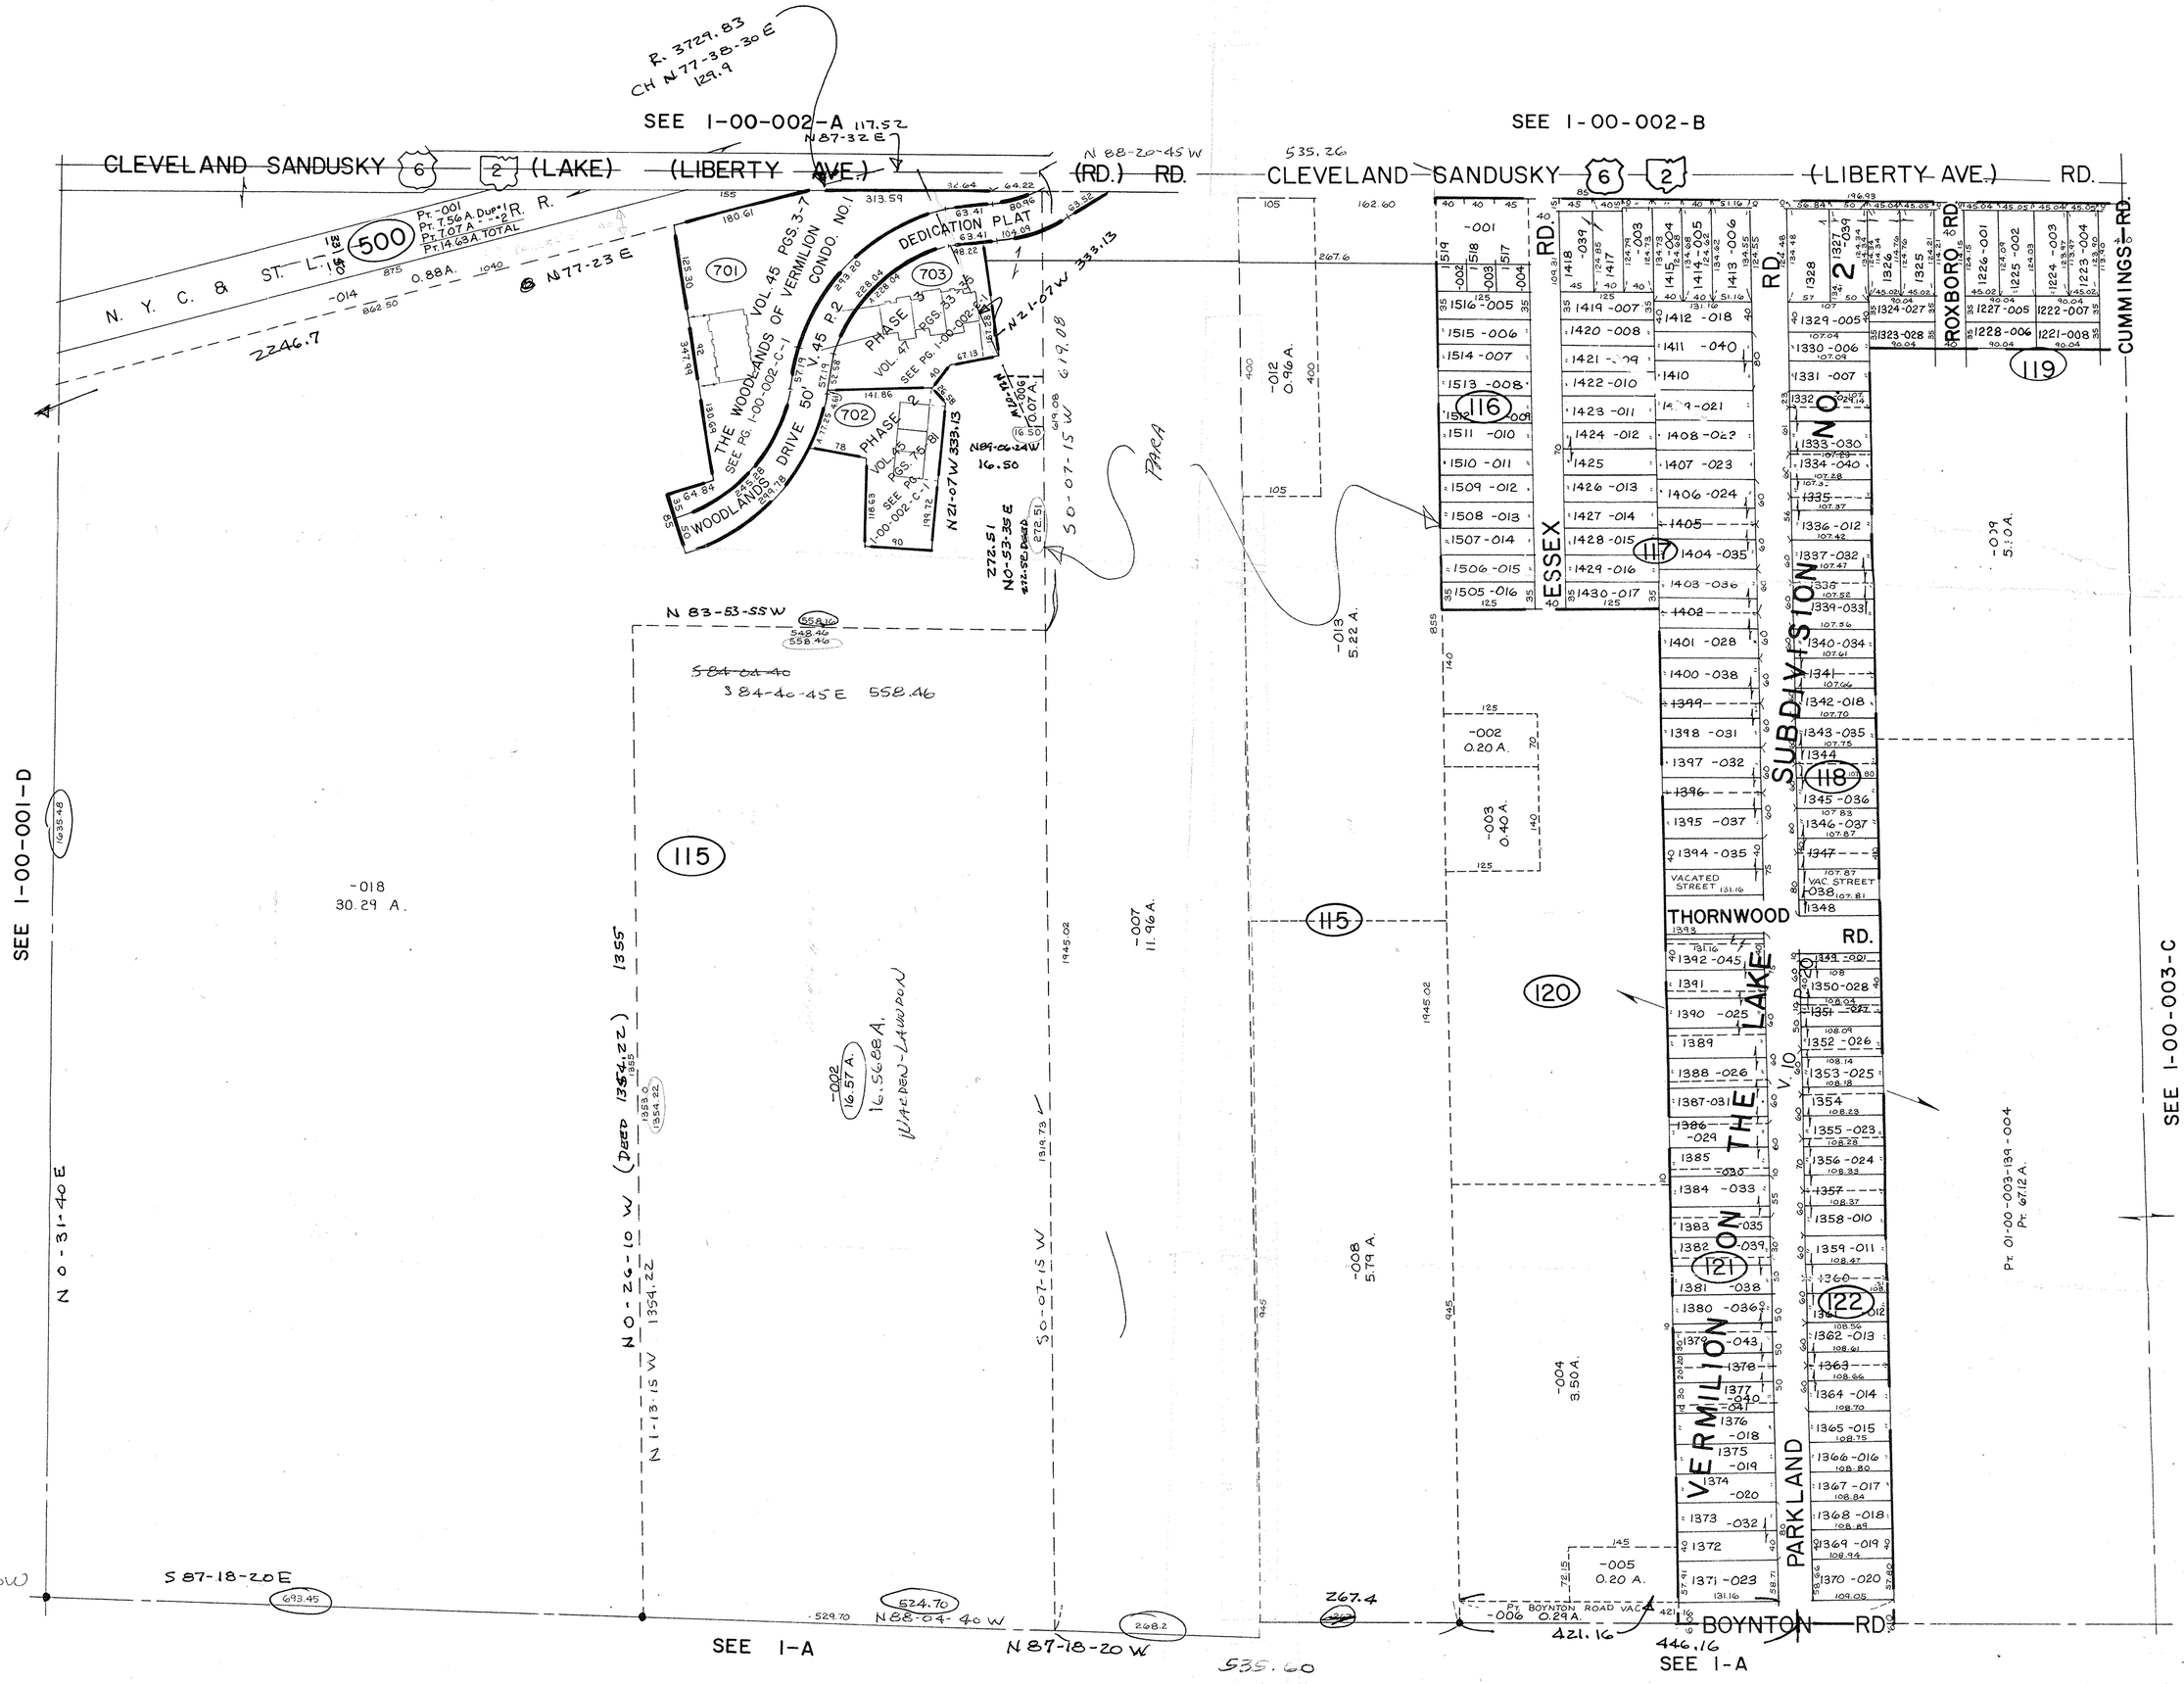

BROWNHELM TWP.

BROWNHELM TWP.

SCALE 1" = 100'

S. E. PT. LOT 2

REVISED