#11407
#11408
#11409

APPROVED
LORAIN CO.
MAP DEPT.
DATE 2-16-78
PAGE 01-00-017 A&B
BY T. McMillan
VOIDED AFTER 11407 11408 11409

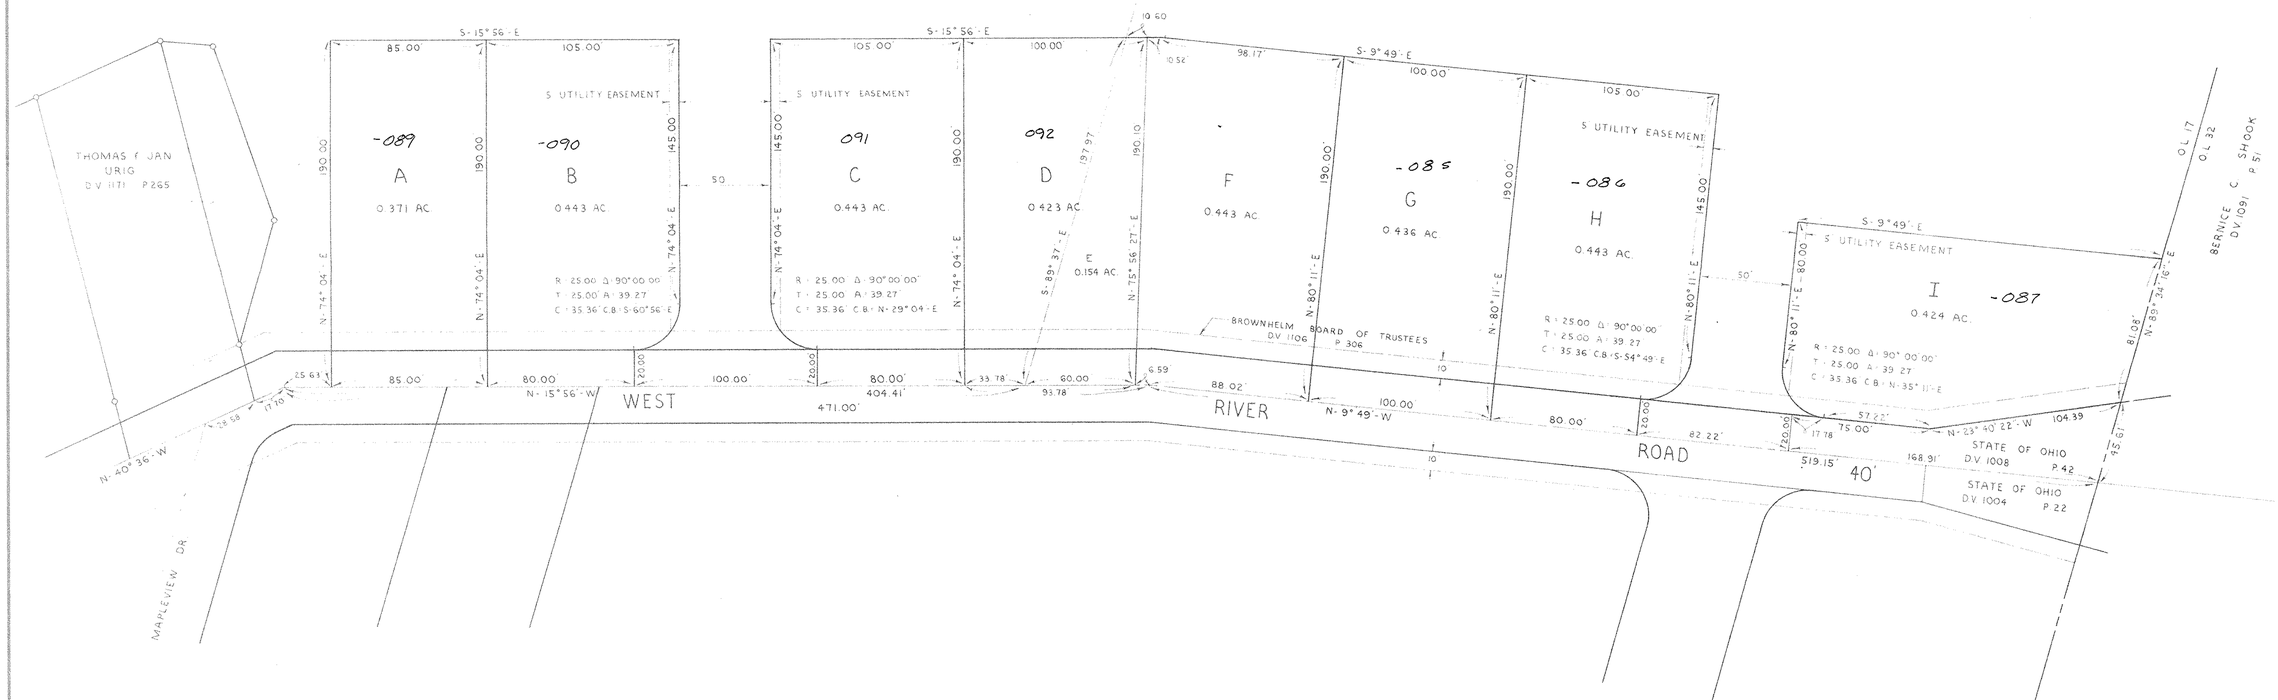

P.P. NO. 01-00-017-000-085, 086, 087, 089, 090, 092, 091	
SPLIT #11408 ~~11410~~ 11407 11409	DATE OF SURVEY
MAP PAGE 01-00-017-A&B	
SURVEYOR	

PARCEL MAP
OF PART OF
ORIGINAL BROWNHELM TOWNSHIP LOT 17
COUNTY OF LORAIN STATE OF OHIO
JAN. 1978
SCALE: 1" = 40'

PREPARED FOR: KENNETH F. CASSELL
PREPARED BY: KLEINOEDER ~ SCHMIDT & ASSOCIATES

01-00-017-000
1-00-017-A
* 11407
11408
11409

REV. 2-15-78

73-202
DLH