99-00183

BRNHLM 1-D
8.5.99
01-00-010-XXX-XXX D. R. Holland

LOT SPLIT & CONSOLIDATION PLAT
FOR
CASSELL ENTERPRISES, INC.

SITUATED IN THE CITY OF LORAIN, COUNTY OF LORAIN, STATE OF OHIO, AND KNOWN AS BEING PART OF SUBLOTS 3 AND 8 OF NORTHCOAST INDUSTRIAL PARK SUBDIVISION NO. 1

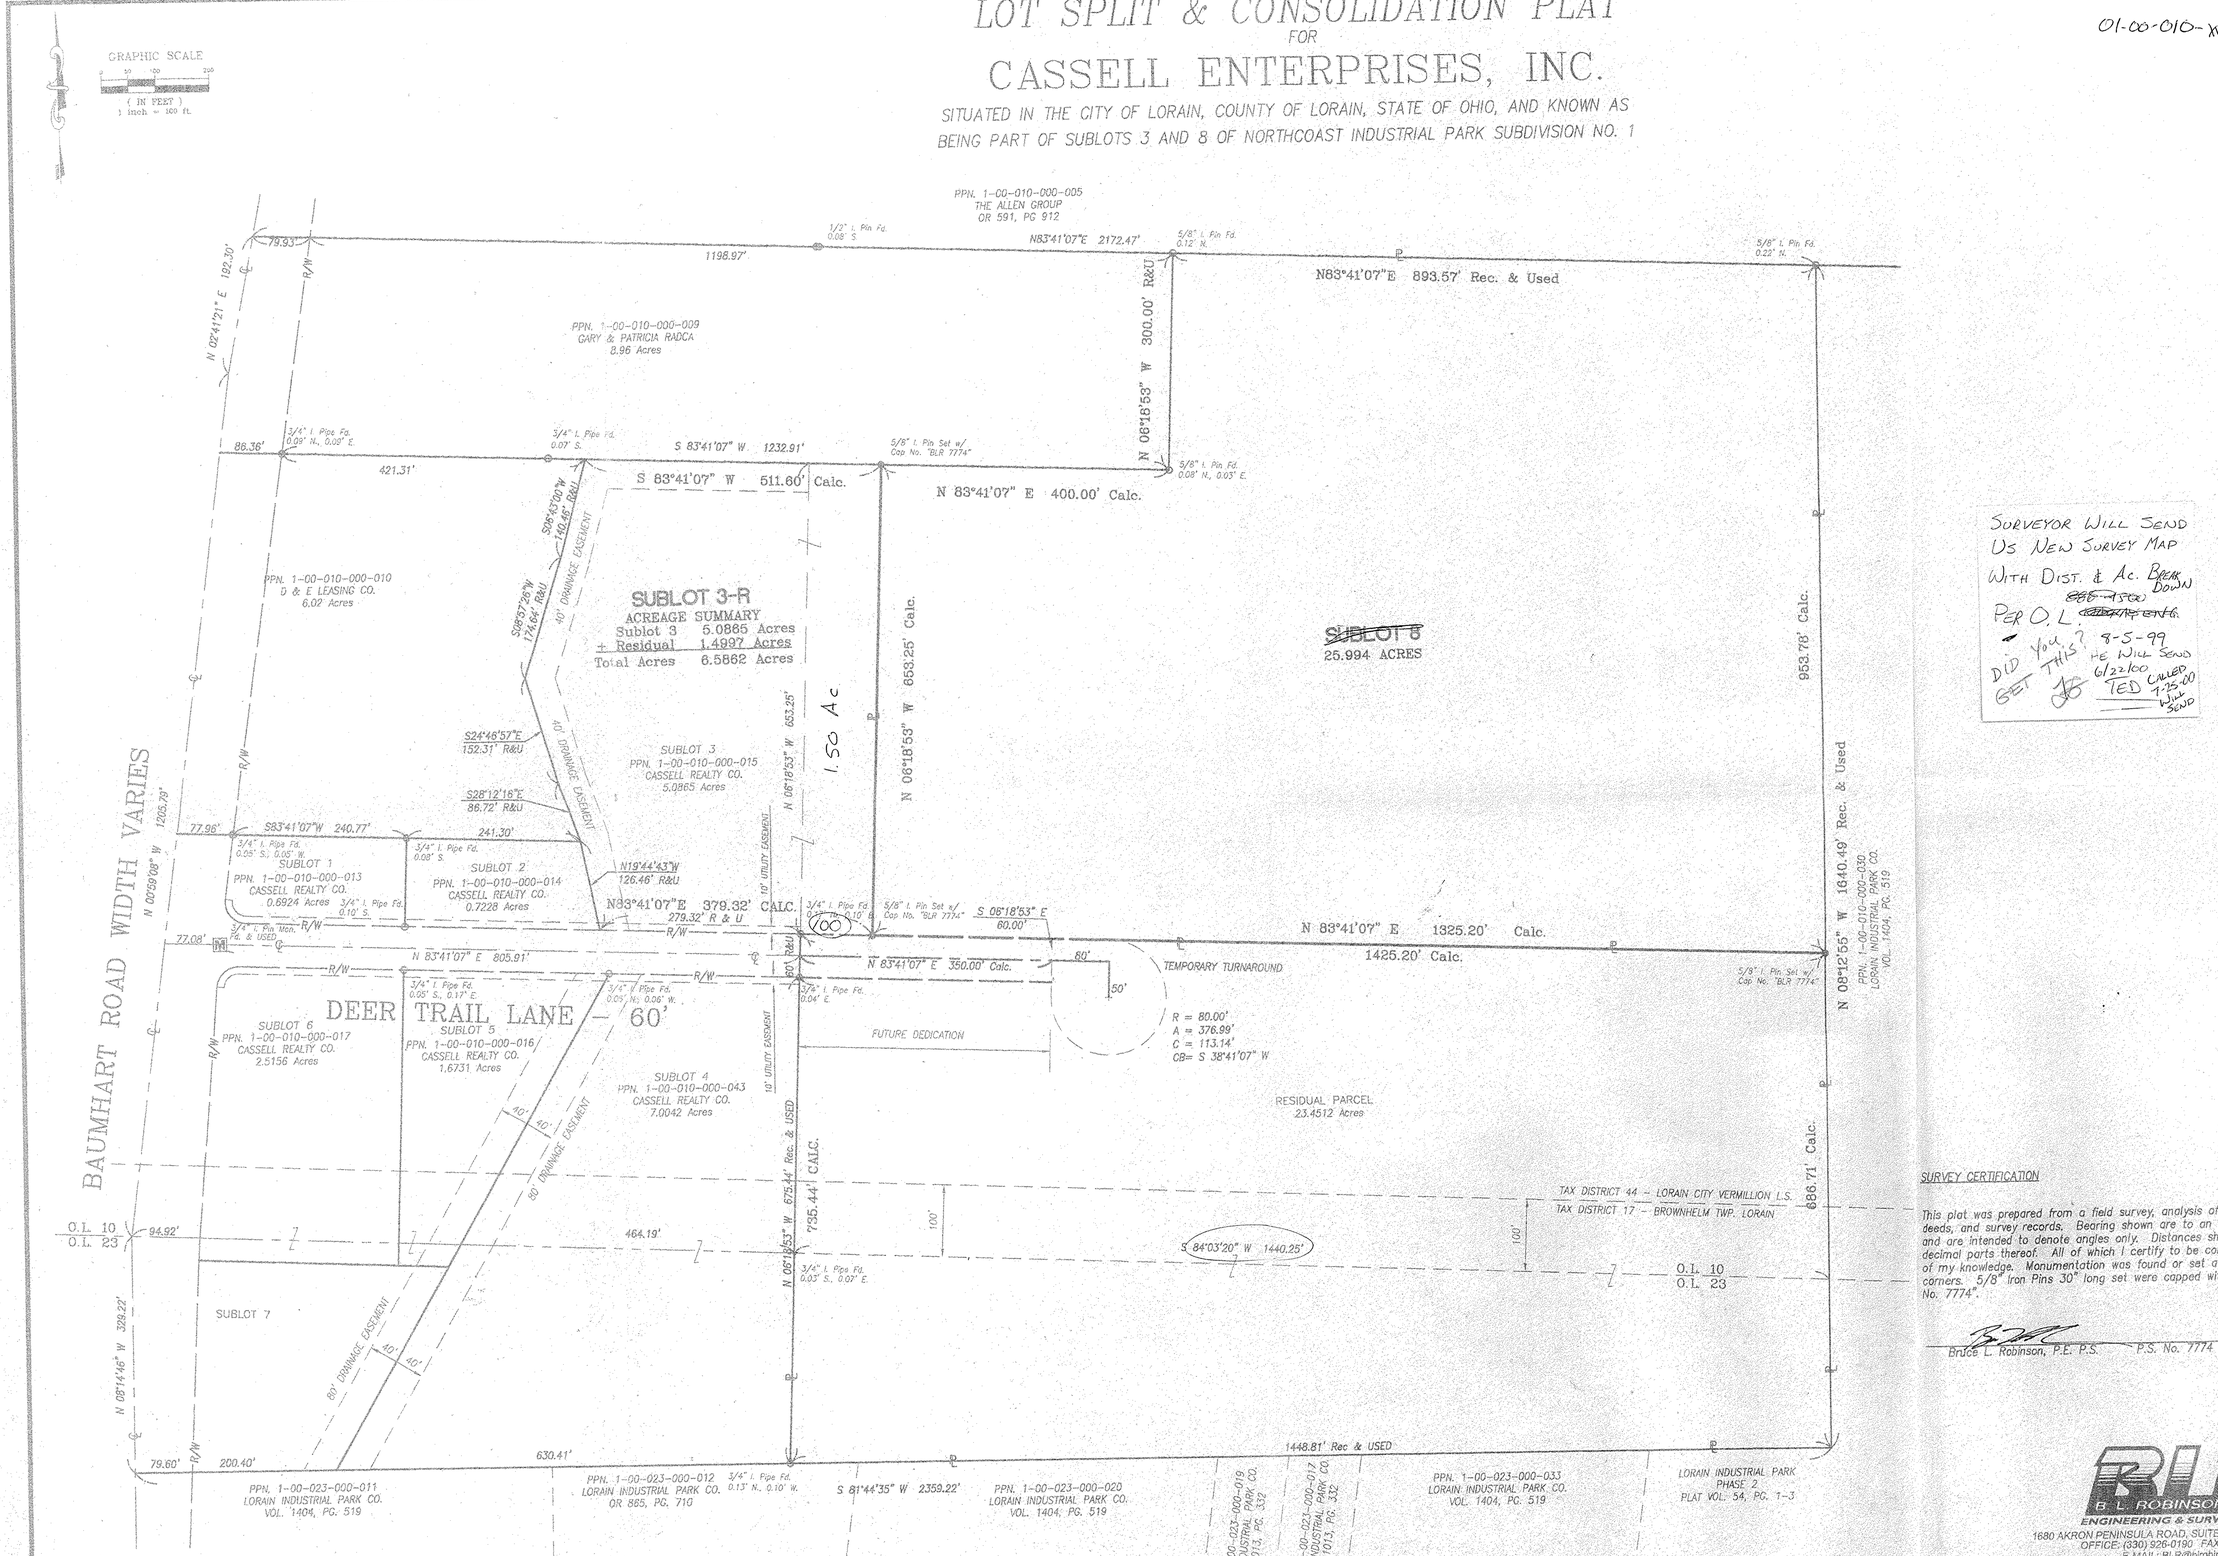

SURVEYOR WILL SEND US NEW SURVEY MAP WITH DIST. & AC. BREAK DOWN
PER O.L. ~~[illegible]~~
DID YOU GET THIS? 8-5-99
HE WILL SEND 6/22/00
TED CALLED 7-25-00 WILL SEND

SURVEY CERTIFICATION

This plat was prepared from a field survey, analysis of recorded plats, deeds, and survey records. Bearing shown are to an assumed meridian and are intended to denote angles only. Distances shown are in feet and decimal parts thereof. All of which I certify to be correct to the best of my knowledge. Monumentation was found or set at all property corners. 5/8" Iron Pins 30" long set were capped with "Robinson RLS No. 7774".

Bruce L. Robinson, P.E. P.S. — P.S. No. 7774 — 8/2/99 Date

STATE OF OHIO — BRUCE L. ROBINSON 7774 — REGISTERED PROFESSIONAL SURVEYOR

B L ROBINSON ENGINEERING & SURVEYING CO.
1680 AKRON PENINSULA ROAD, SUITE 201, AKRON, OHIO 44313
OFFICE: (330) 926-0190 FAX: (330) 926-0191
E-MAIL: BLR@blrobinson.net

JOB NO. M006 PAGE 1 OF 1

REVISED HMP TO BE SENT