Map of Part of O.L. 22 Brownhelm Twp.
Now City of Vermilion, Lorain Co. Ohio
Scale 1" 60' July 5, 1982
By Arnold F. Koepp
Reg. Surveyor

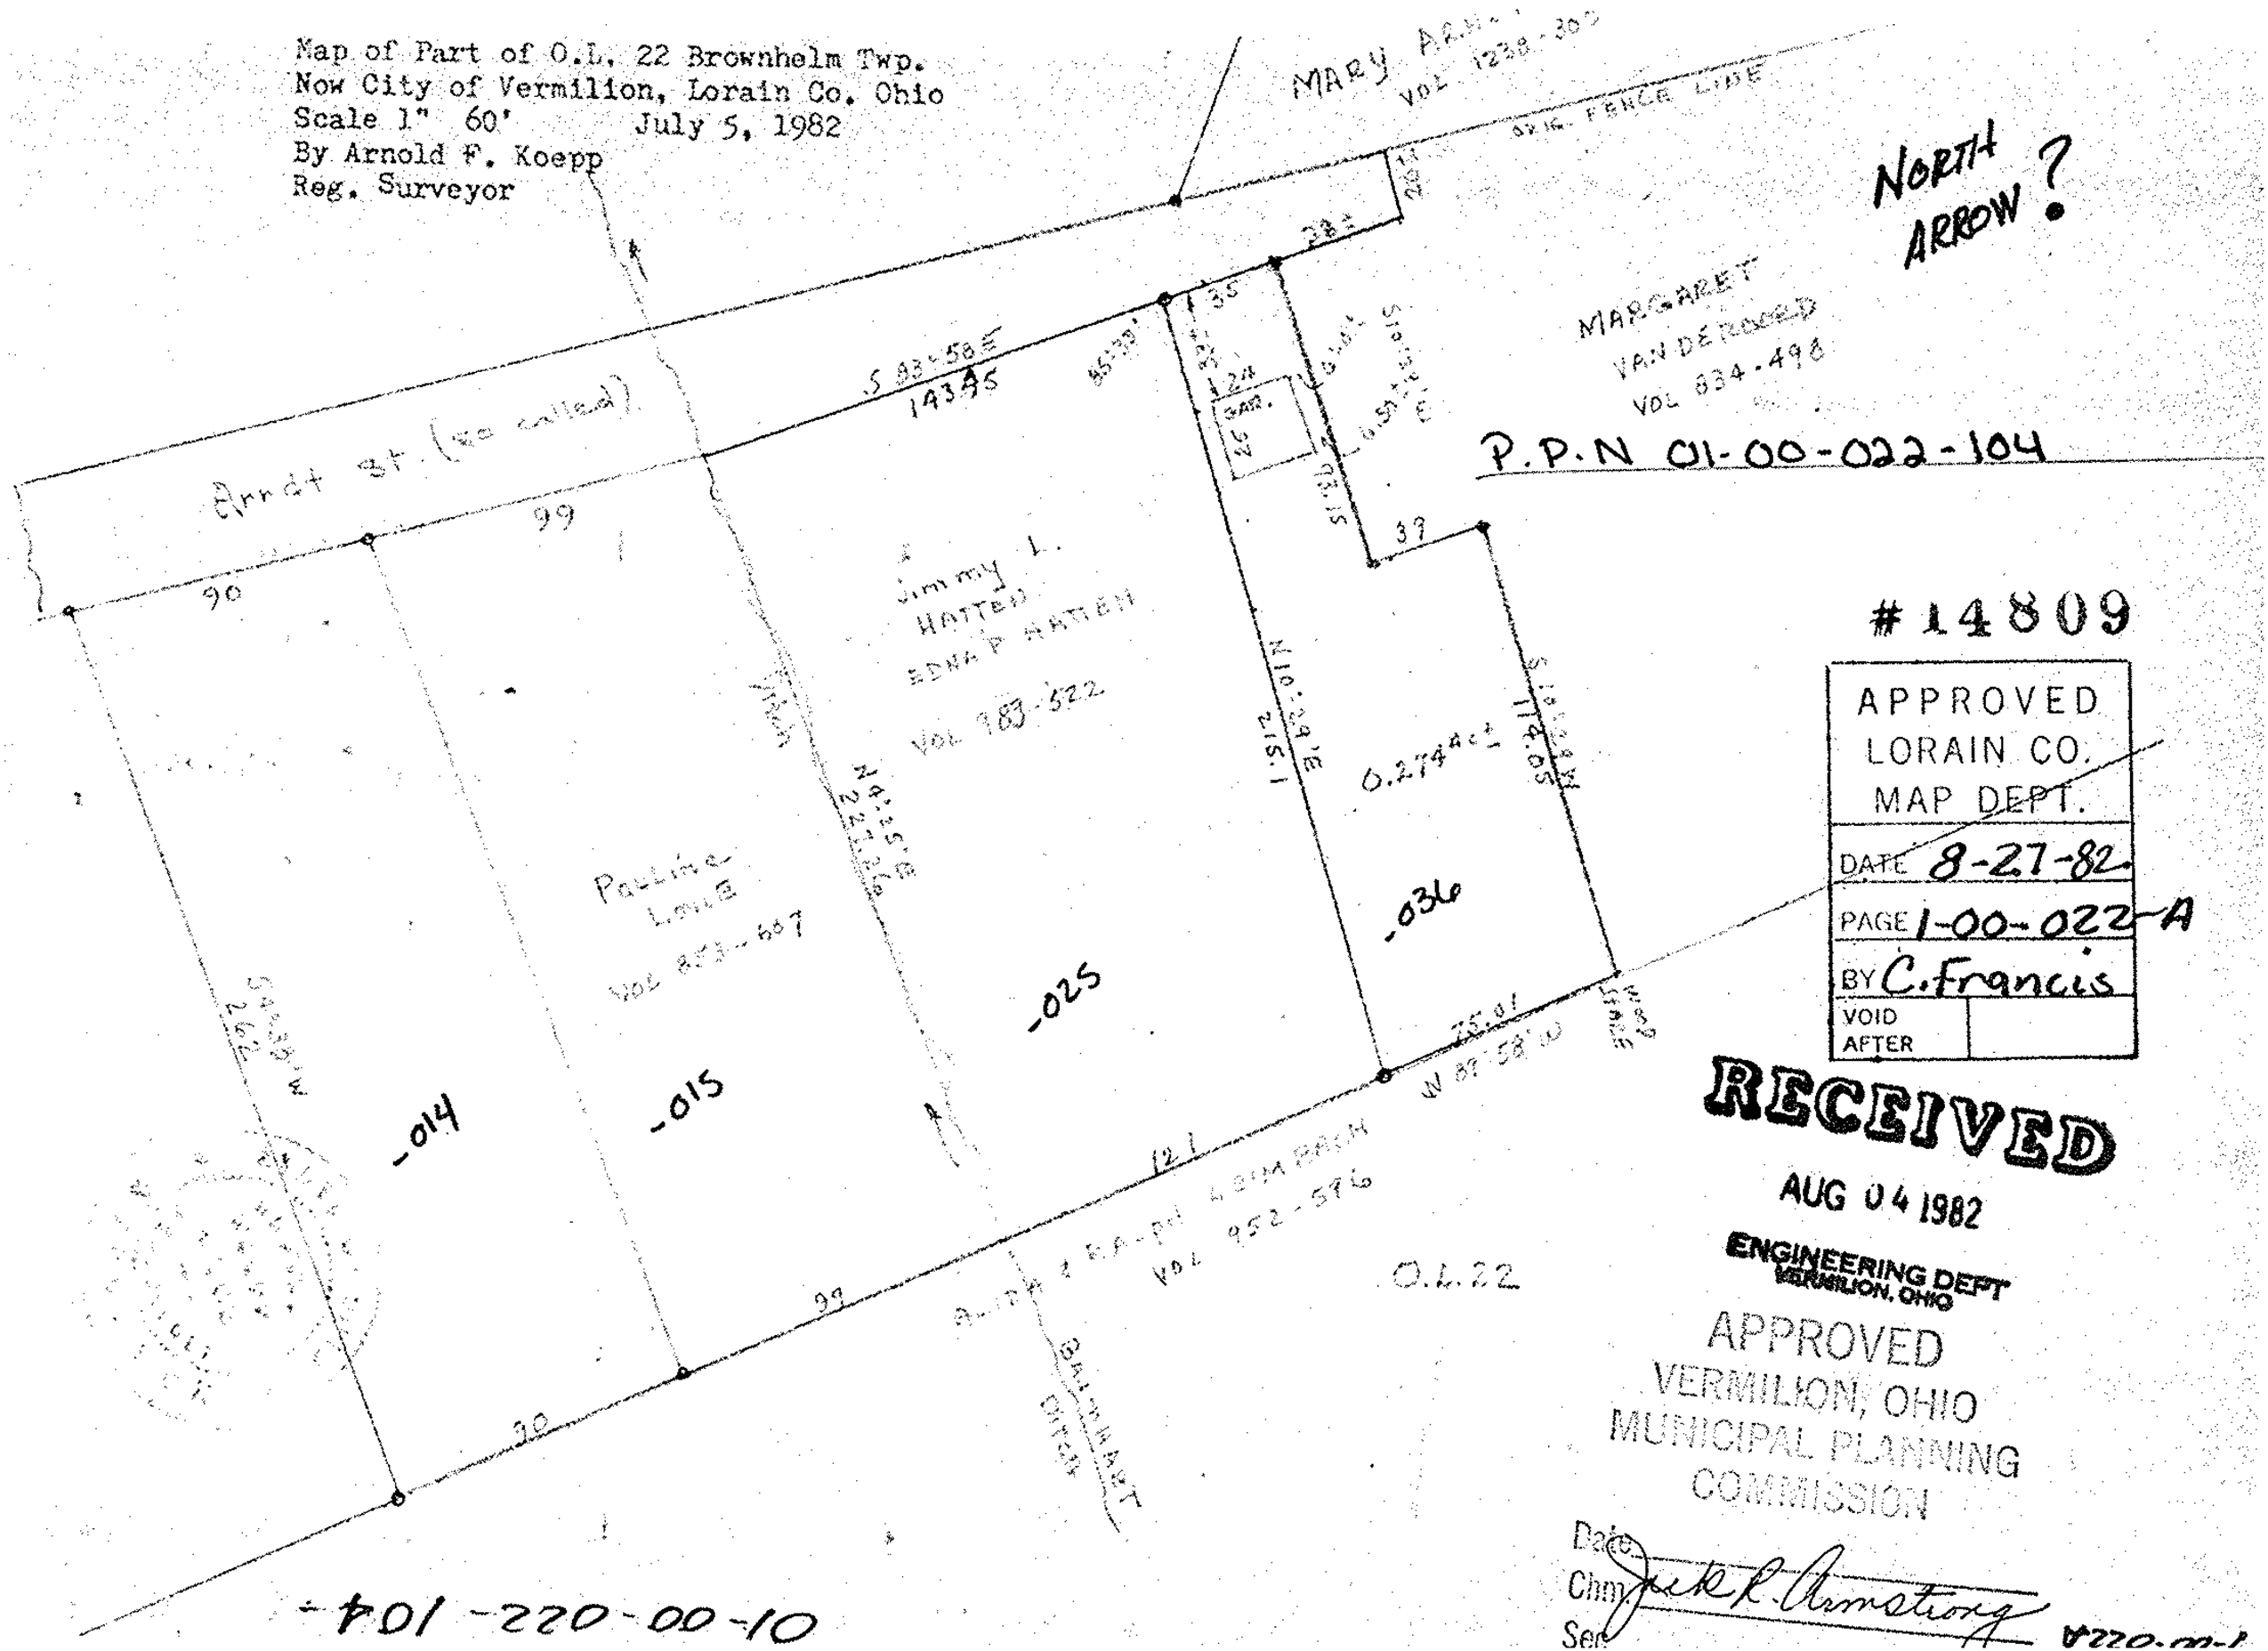

#14809

APPROVED
LORAIN CO.
MAP DEPT.
DATE 8-27-82
PAGE 1-00-022-A
BY C. Francis
VOID AFTER

RECEIVED
AUG 04 1982
ENGINEERING DEPT
VERMILION, OHIO

APPROVED
VERMILION, OHIO
MUNICIPAL PLANNING
COMMISSION
Date
Chm. Jack R. Armstrong
Sec.

01-00-022-104