ARNOLD KOEPP
REGISTERED SURVEYOR
629 BRENNAN DRIVE
AMHERST, OHIO 44001

Feb. 27, 1971

Survey for John Love Part of Lot 21 Lot 22 Brownhelm Twp. Now City of Vermilion
Lorain Co. Ohio Scale 1" 100'

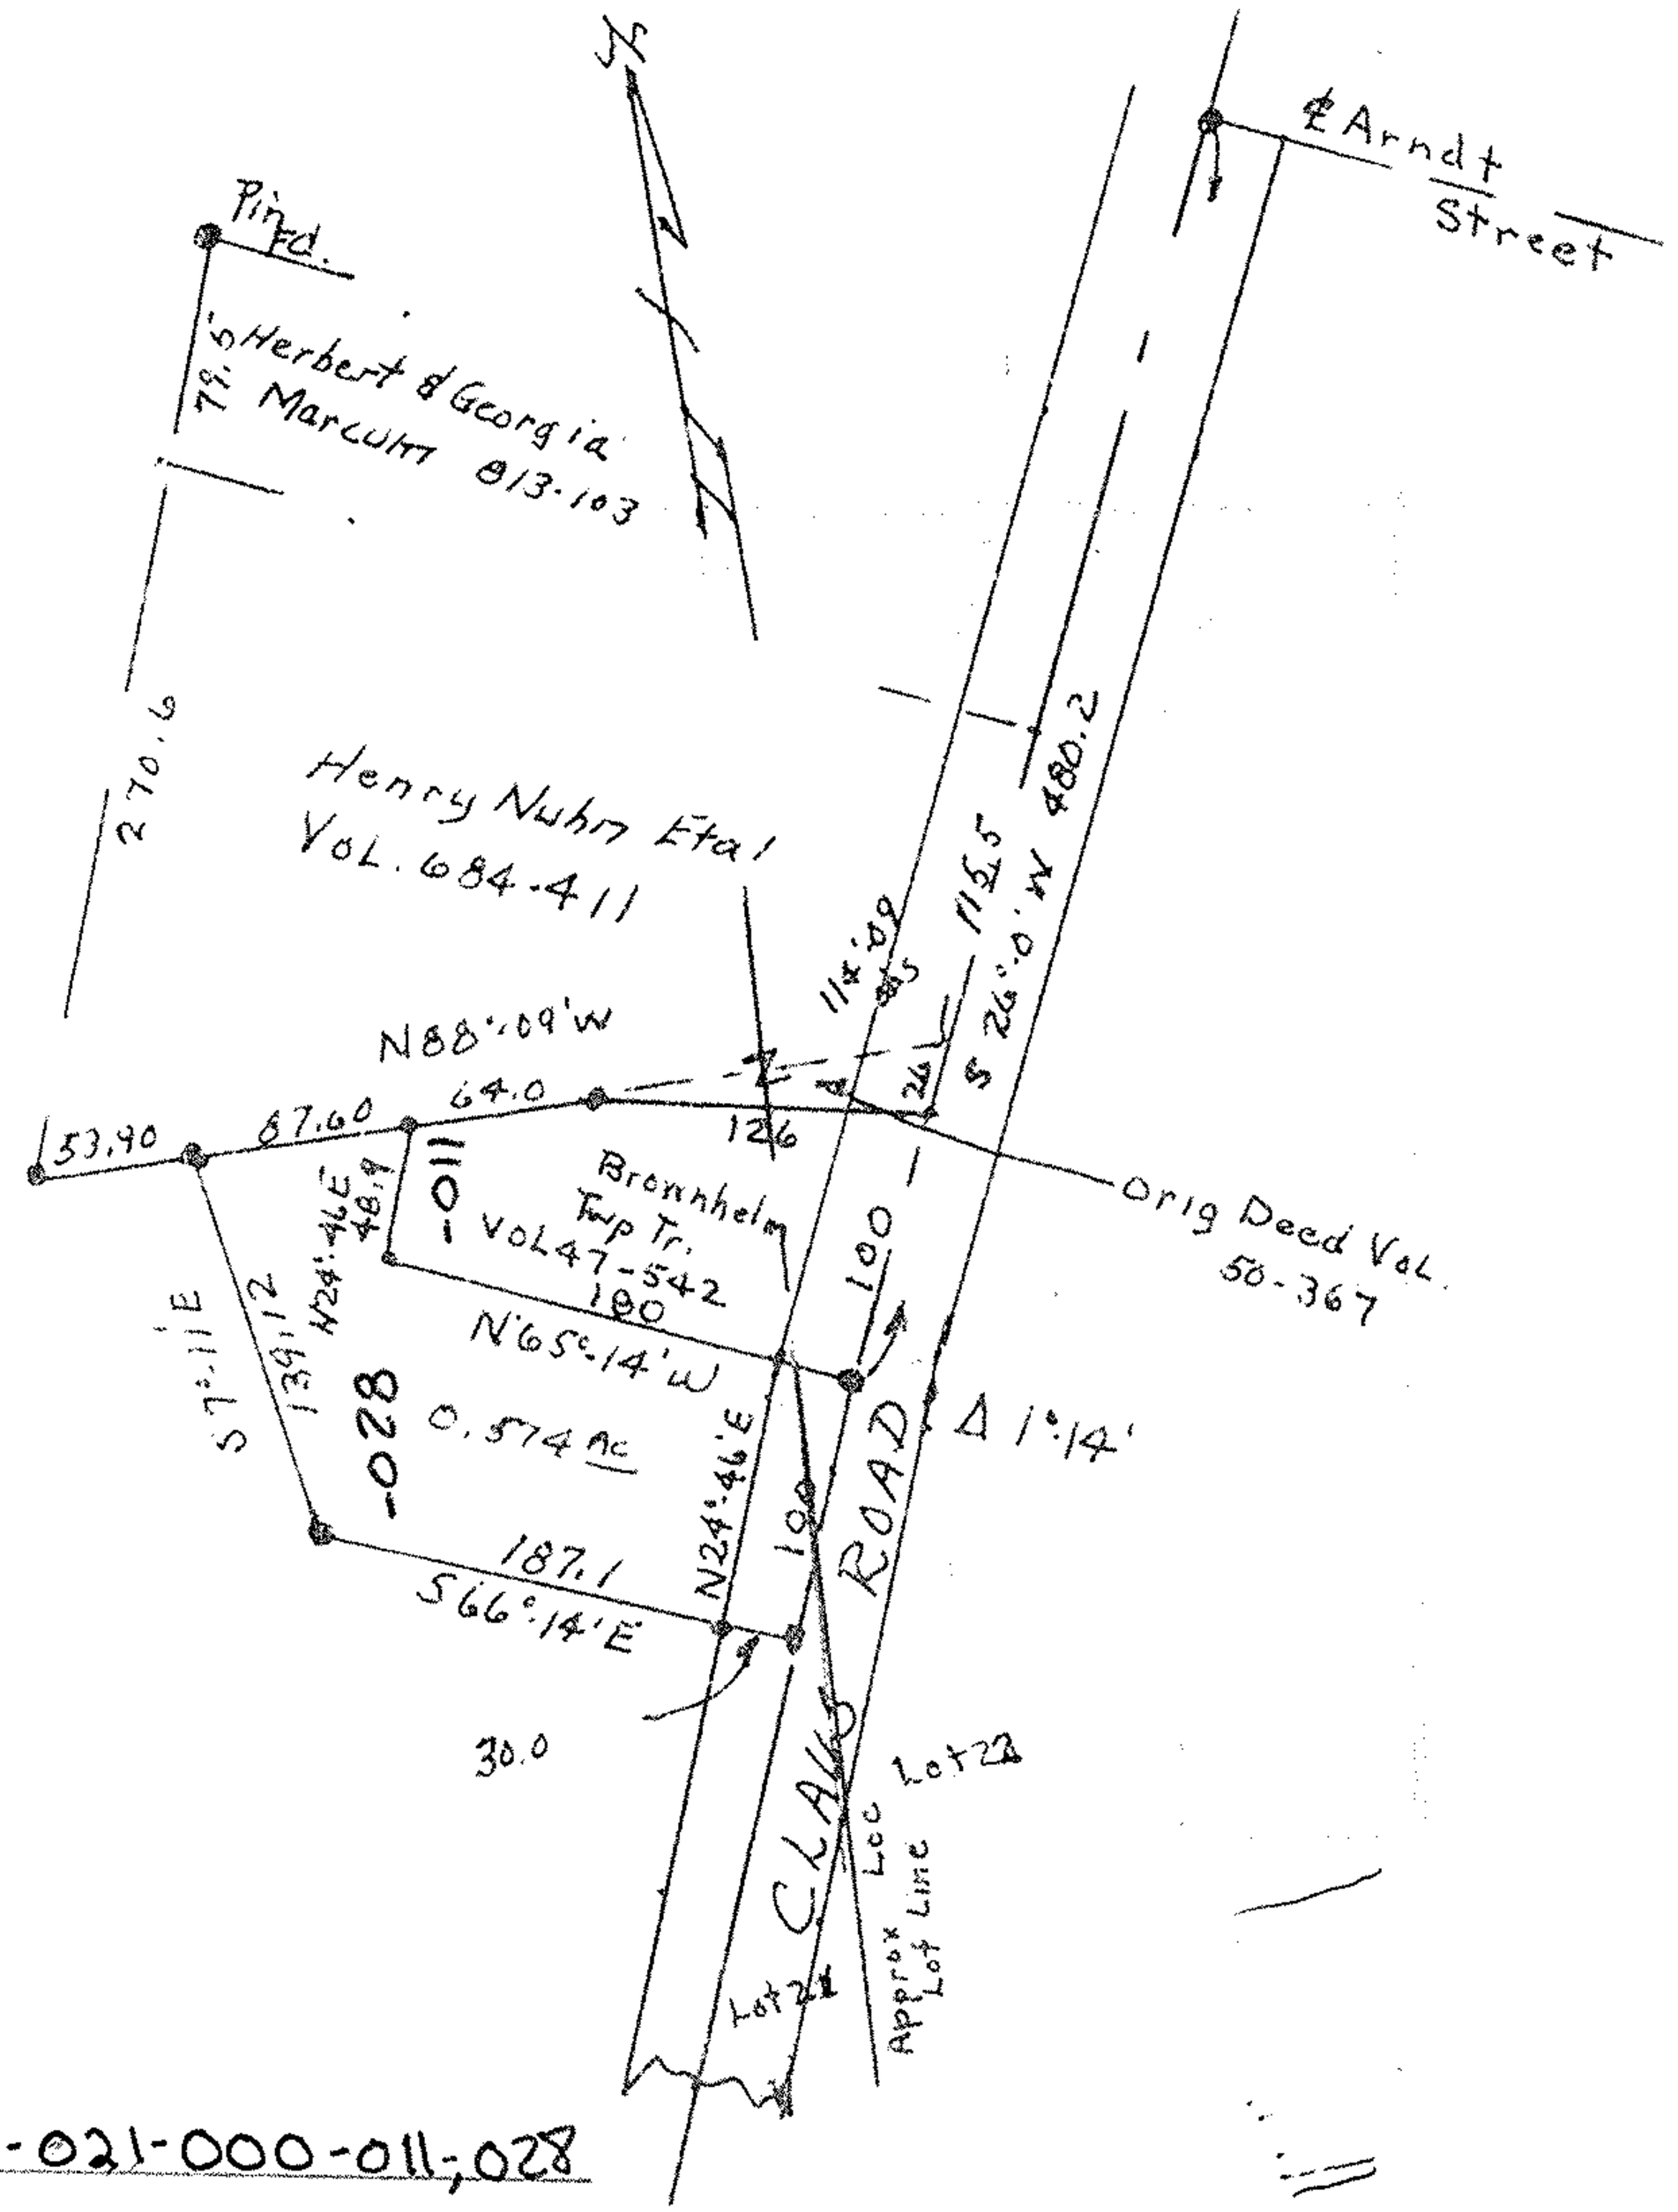

P.P.N 01-00-021-000-011,028

01-00-021-000

1-00-021
1-00-022