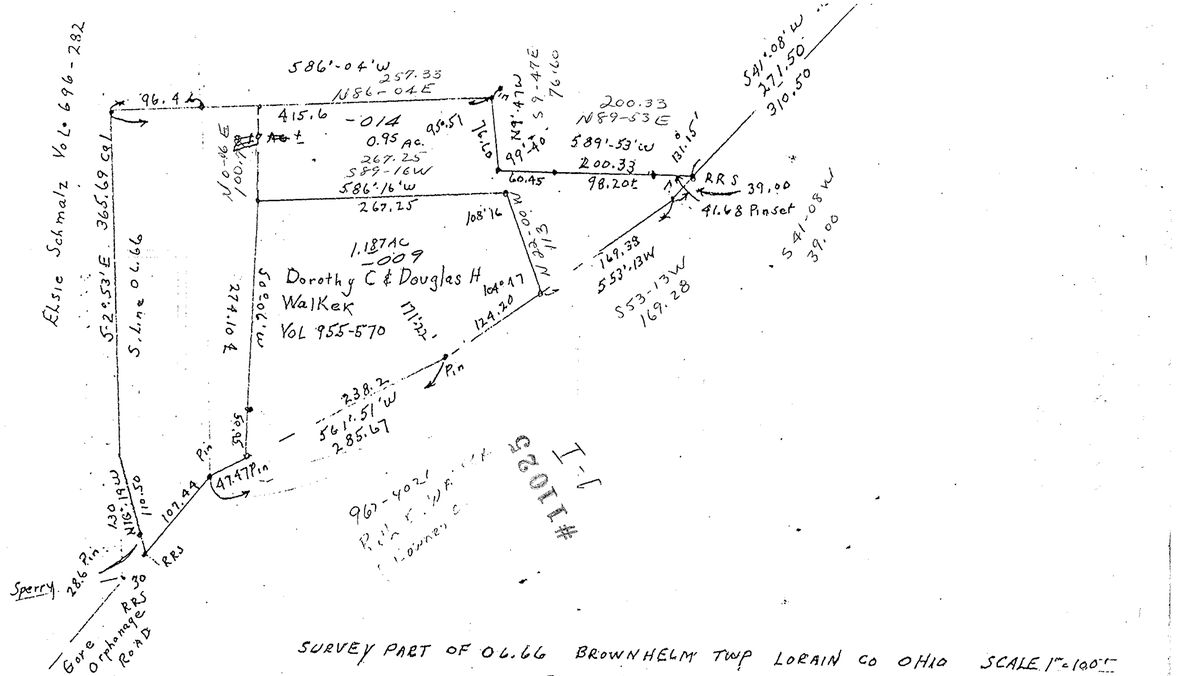
Elsie Schmalz Vol. 696-282
S. Line O.L. 66
S2°53'E 365.69 cal
586°04'W 257.33
N86-04E
96.4
415.6
-014
0.95 Ac.
95.51
267.25
S89-16W
586°16'W
267.25
N0-46E
100.1
N9°47'W
S9-47E
76.60
200.33
N89-53E
S89°53'W
200.33
98.20t
60.45
131.15'
RRS
39.00
41.68 Pinset
S41°08'W
271.50
310.50
S41-08W
39.00
108°16
N22-00W
169.38
S53°13W
169.28
1.187AC
-009
Dorothy C & Douglas H
Walker
Vol 955-570
104°17
124.20
238.2
S61°51'W
285.67
Pin
N0°10'E
274.10
S0°06'W
58.55
97.47 Pin
107.49
130
N0°16'W
Sperry
286 Pin
RRS
30
Gore Orphanage Road
960-402'
#11025
T-I
SURVEY PART OF O.L. 66 BROWNHELM TWP LORAIN CO OHIO SCALE 1"=100'

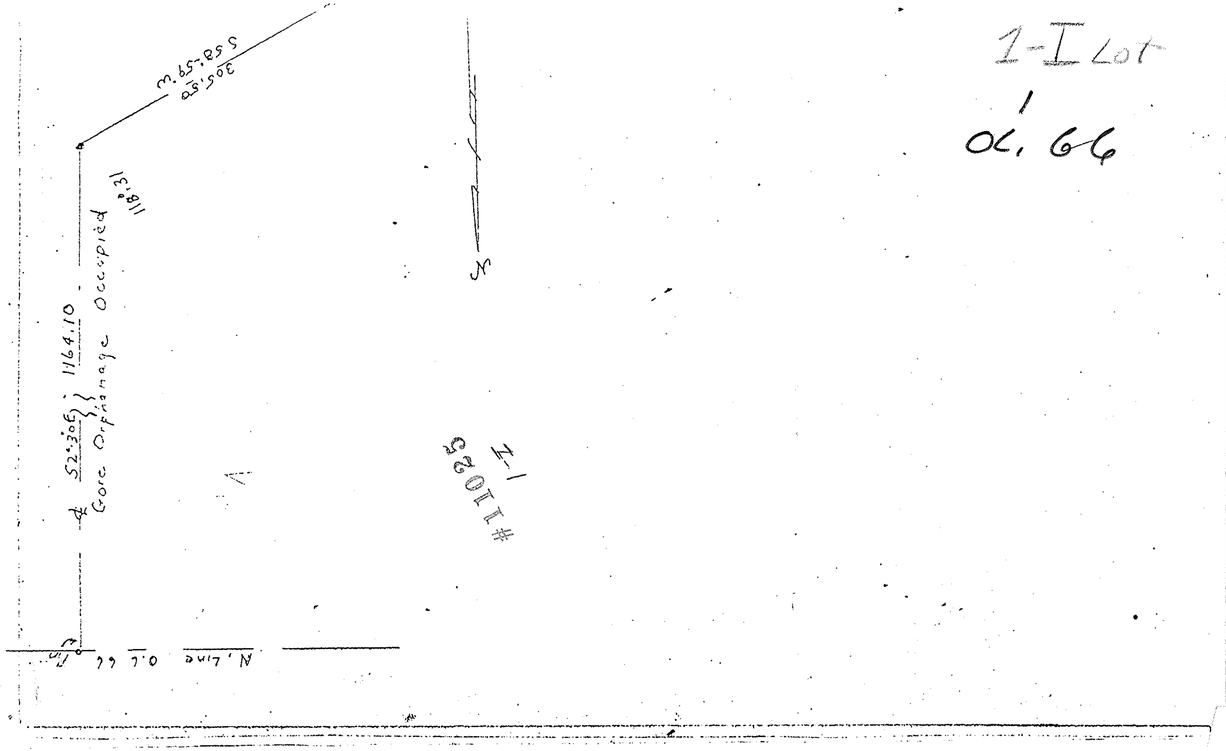
1-I Lot
1
O.L. 66
118°31'
S2°30E
1164.10
Gore Orphanage Occupied
N. Line O.L. 66
#11025
T-I