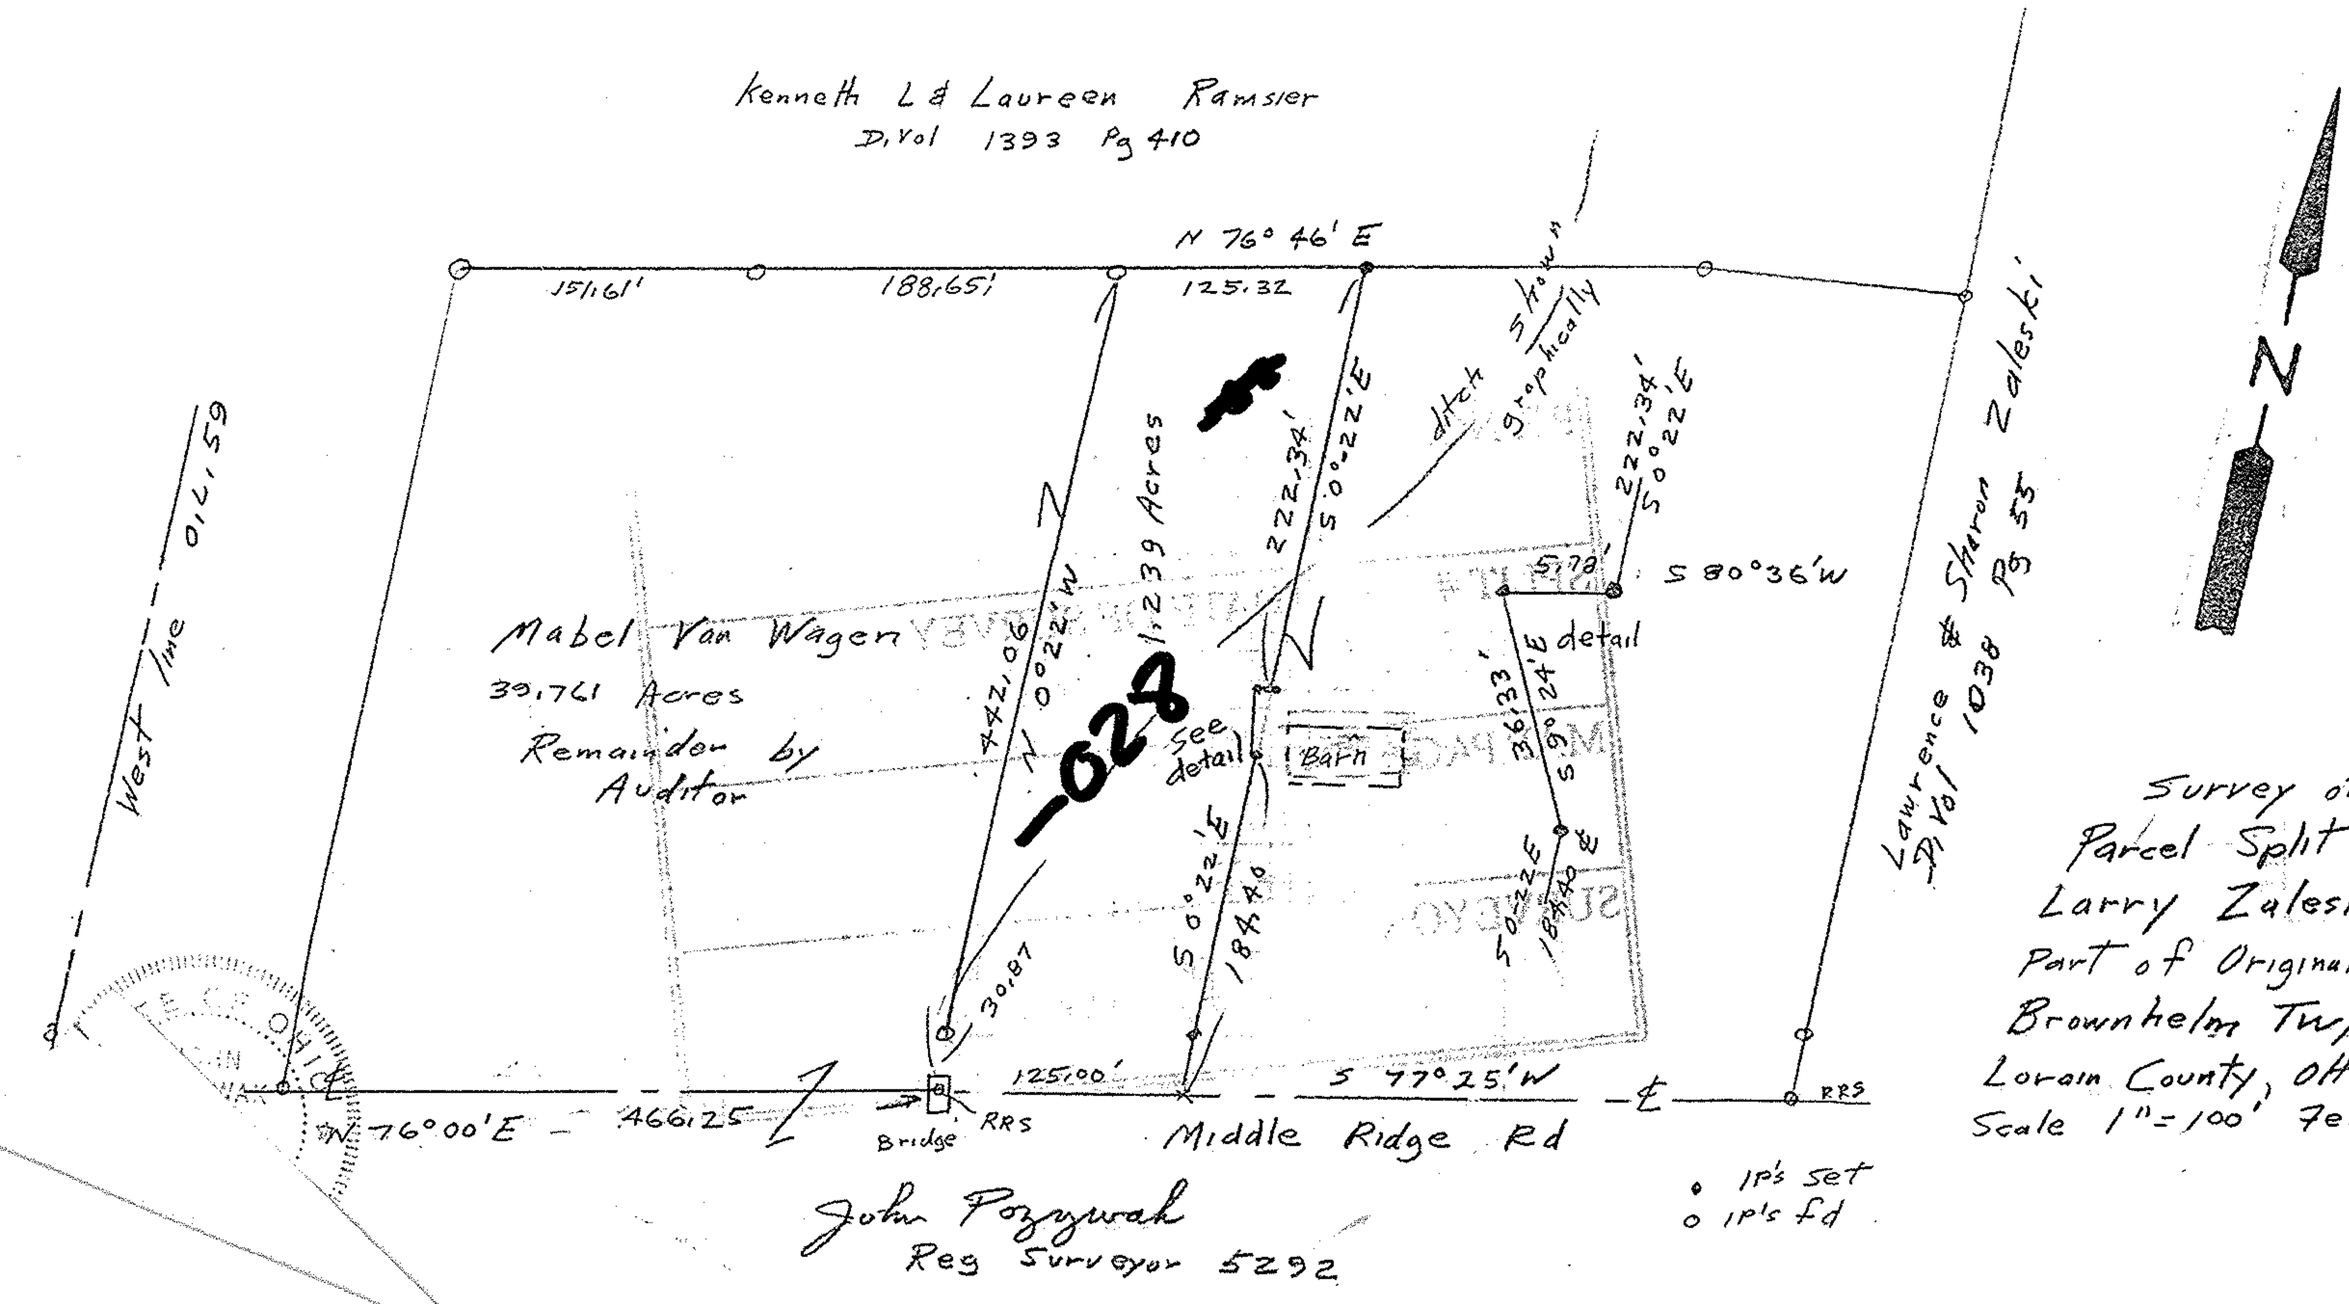01-00.059-000-028