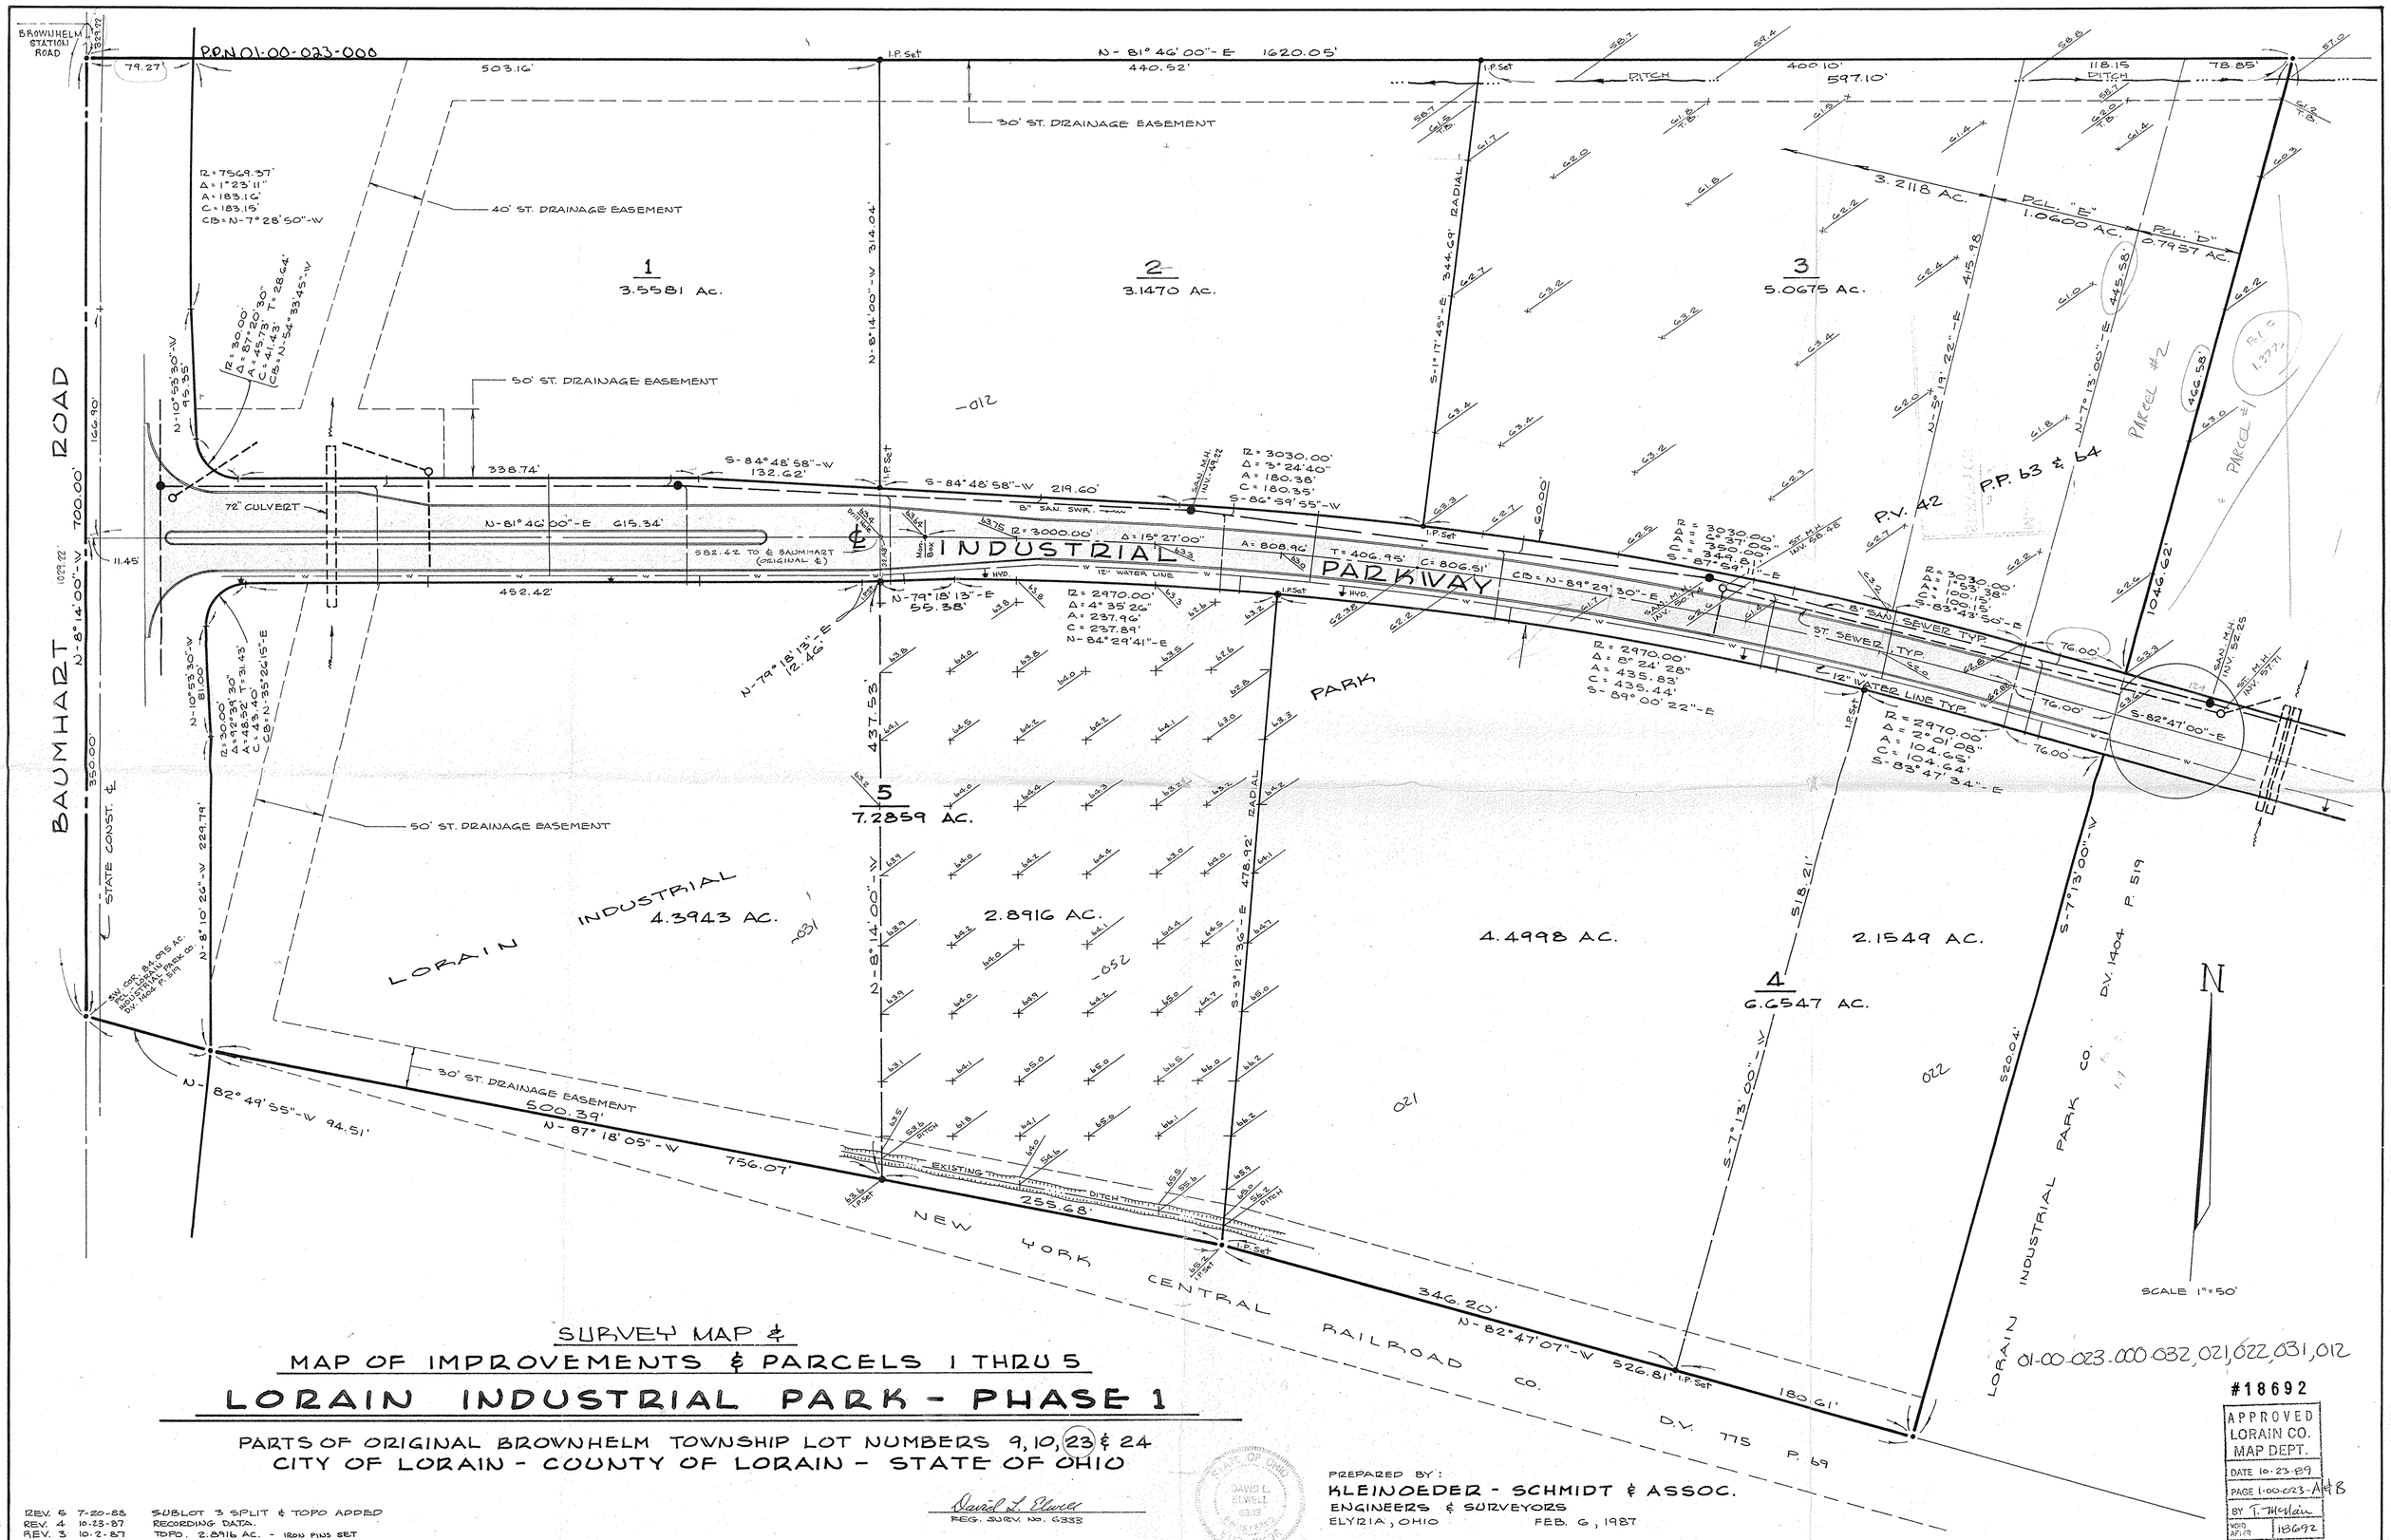

SURVEY MAP &

MAP OF IMPROVEMENTS & PARCELS 1 THRU 5

LORAIN INDUSTRIAL PARK - PHASE 1

PARTS OF ORIGINAL BROWNHELM TOWNSHIP LOT NUMBERS 9, 10, 23 & 24
CITY OF LORAIN - COUNTY OF LORAIN - STATE OF OHIO

REV. 5 7-20-88 SUBLOT 3 SPLIT & TOPO ADDED
REV. 4 10-23-87 RECORDING DATA.
REV. 3 10-2-87 TOPO. 2.8916 AC. - IRON PINS SET
REV. 2 8-5-87 SUBLOT 5 SPLIT - IRON PINS SET
REV. 1, 6-29-86 SUBLOT 4 SPLIT - IRON PINS SET

David L. Elwell
REG. SURV. NO. 6333

STATE OF OHIO DAVID L. ELWELL 6333 REGISTERED SURVEYOR

PREPARED BY:
KLEINOEDER - SCHMIDT & ASSOC.
ENGINEERS & SURVEYORS
ELYRIA, OHIO FEB. 6, 1987

#18692

APPROVED
LORAIN CO.
MAP DEPT.
DATE 10-23-89
PAGE 1-00-023-A48
BY T. McClain
VOID AFTER 18692

85-134