Map of Part of Surplus Lot 26 Brownhelm Twp. Lorain Co. Ohio
Scale 1" 100' Aug. 8, 1978
By Arnold F.Koepp Registered Surveyor No. 4306

P.P.N 01-00-026-000-017-,018

#17461

APPROVED
LORAIN CO.
MAP DEPT.

DATE 6/12/87

PAGE 1-I

BY T. McNair
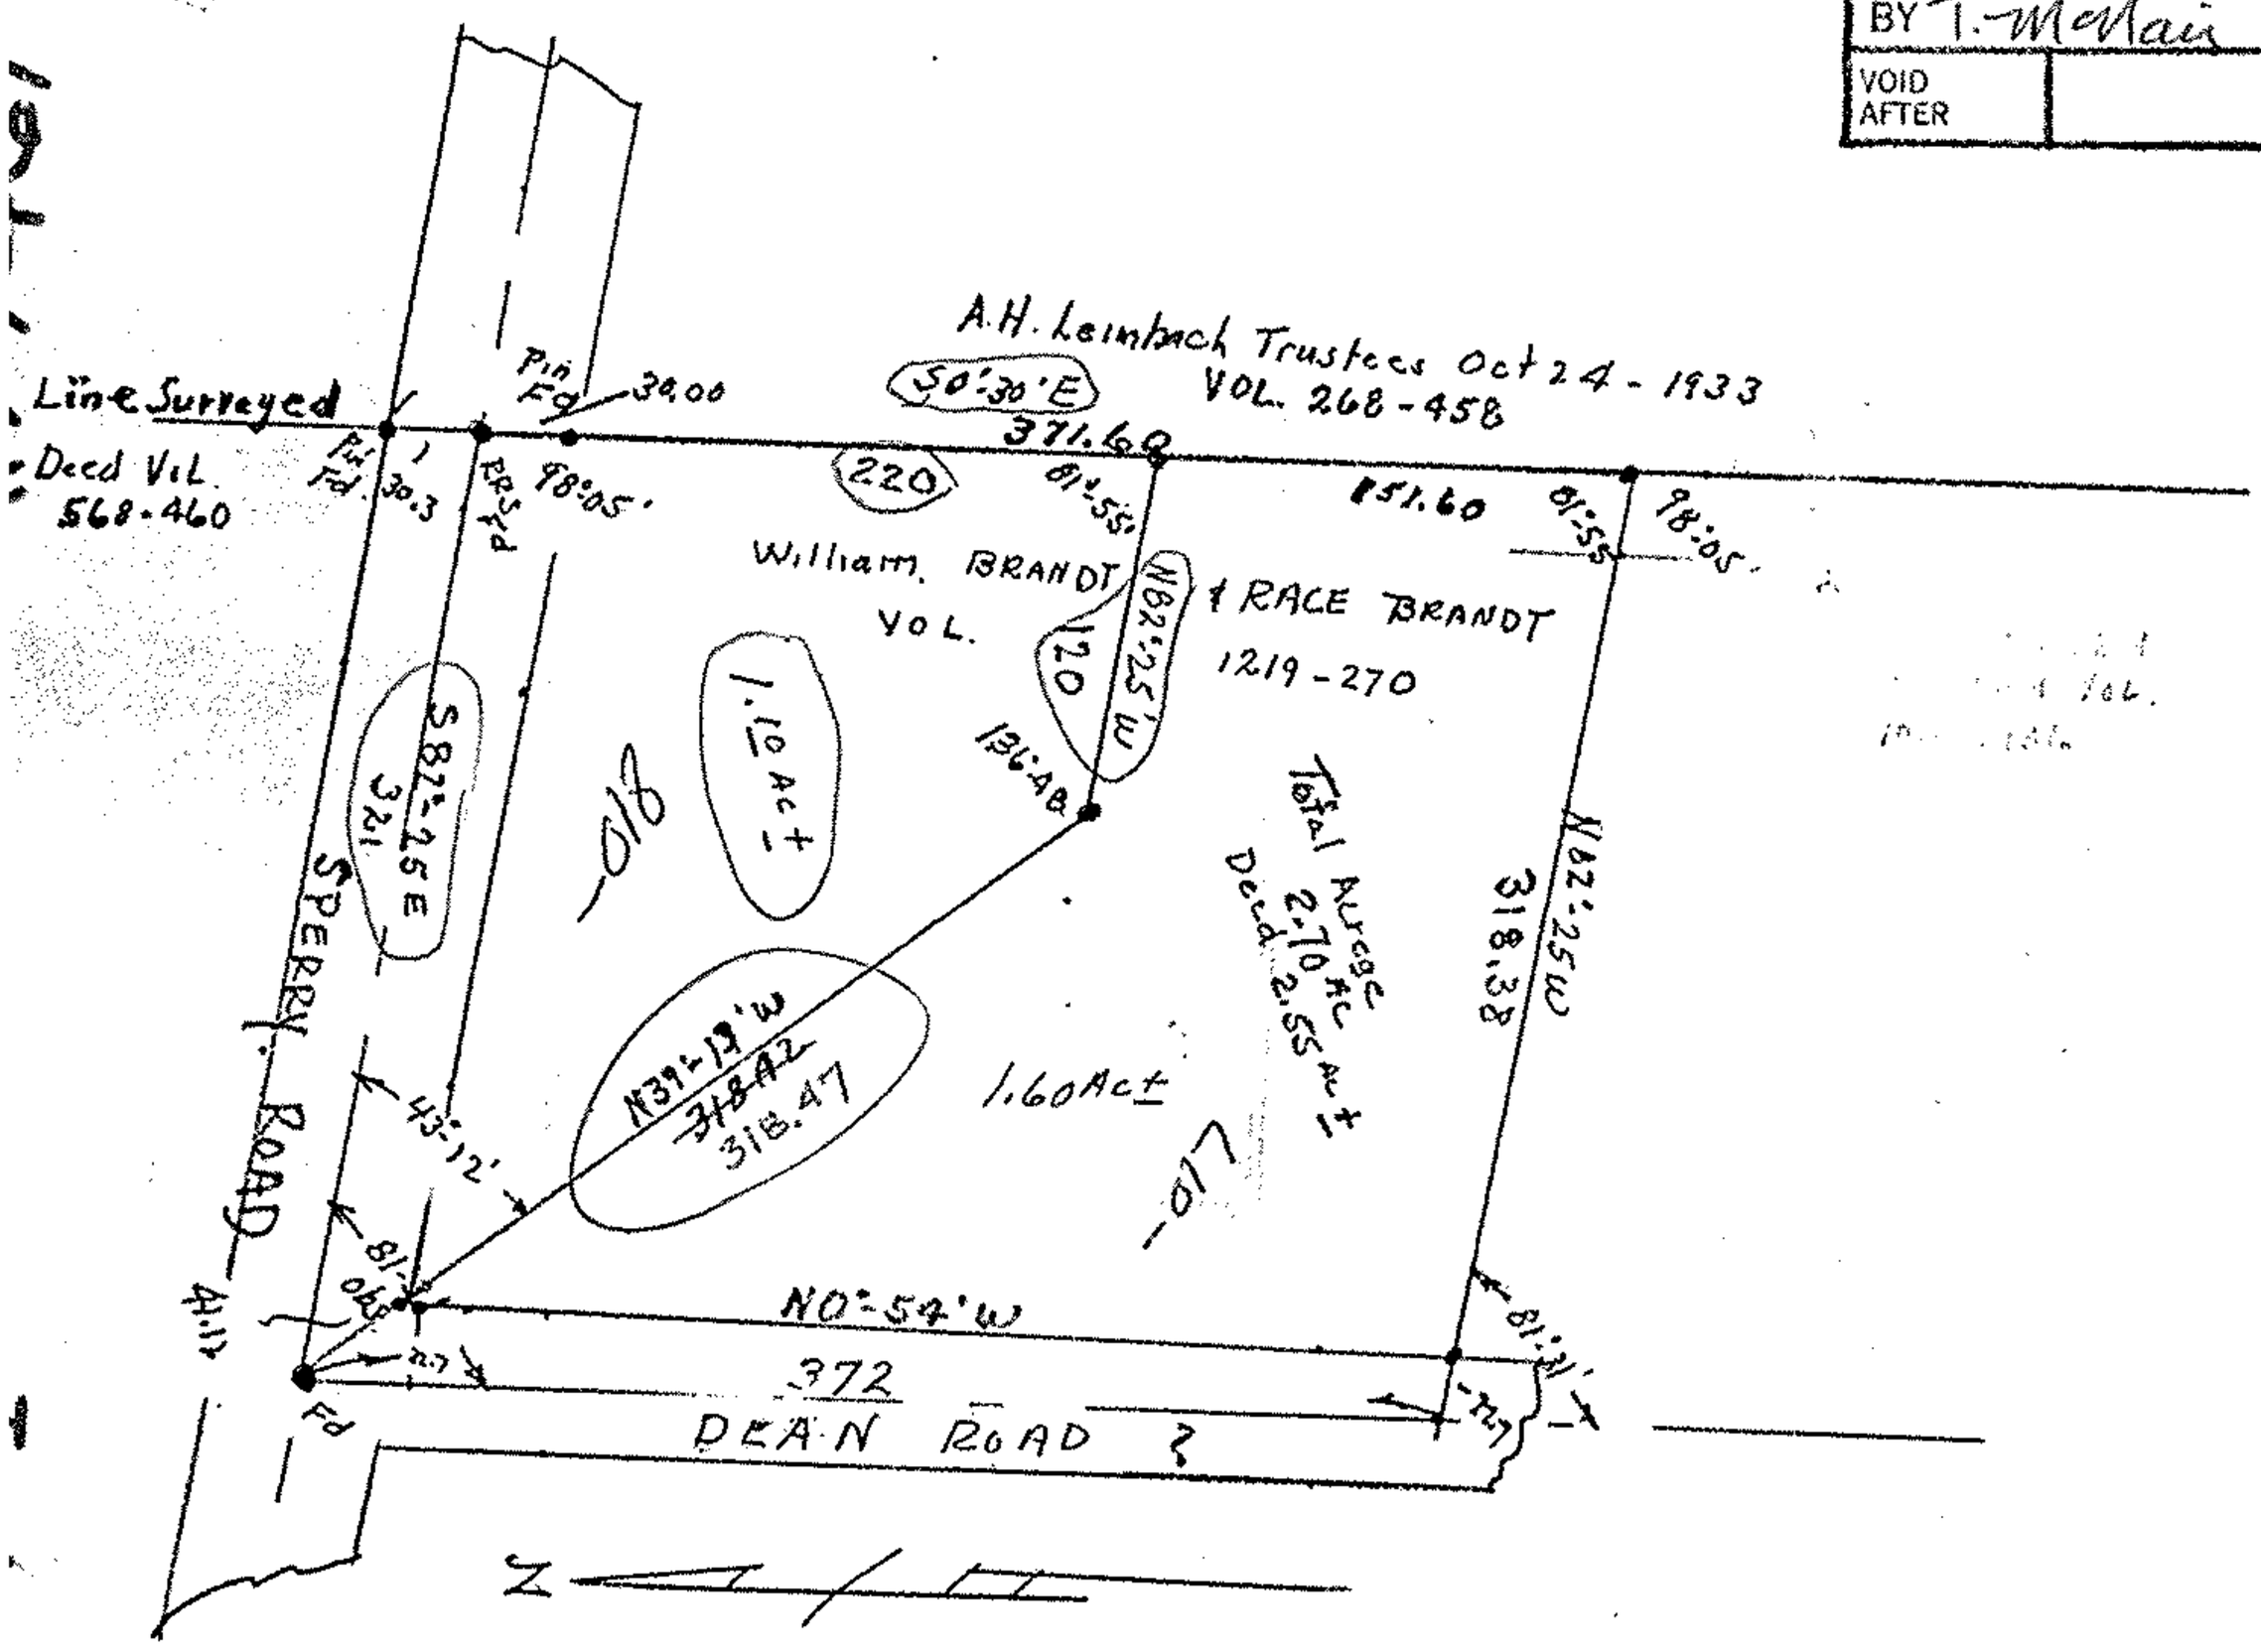
VOID AFTER