02-01-004-114-014

SCHAFER, HURA & ASSOCIATES, INC.

ENGINEERS AND SURVEYORS
4656 OBERLIN AVE.
LORAIN, OHIO

10th STREET 66'

℄ 02-01-004-114-014 ℄

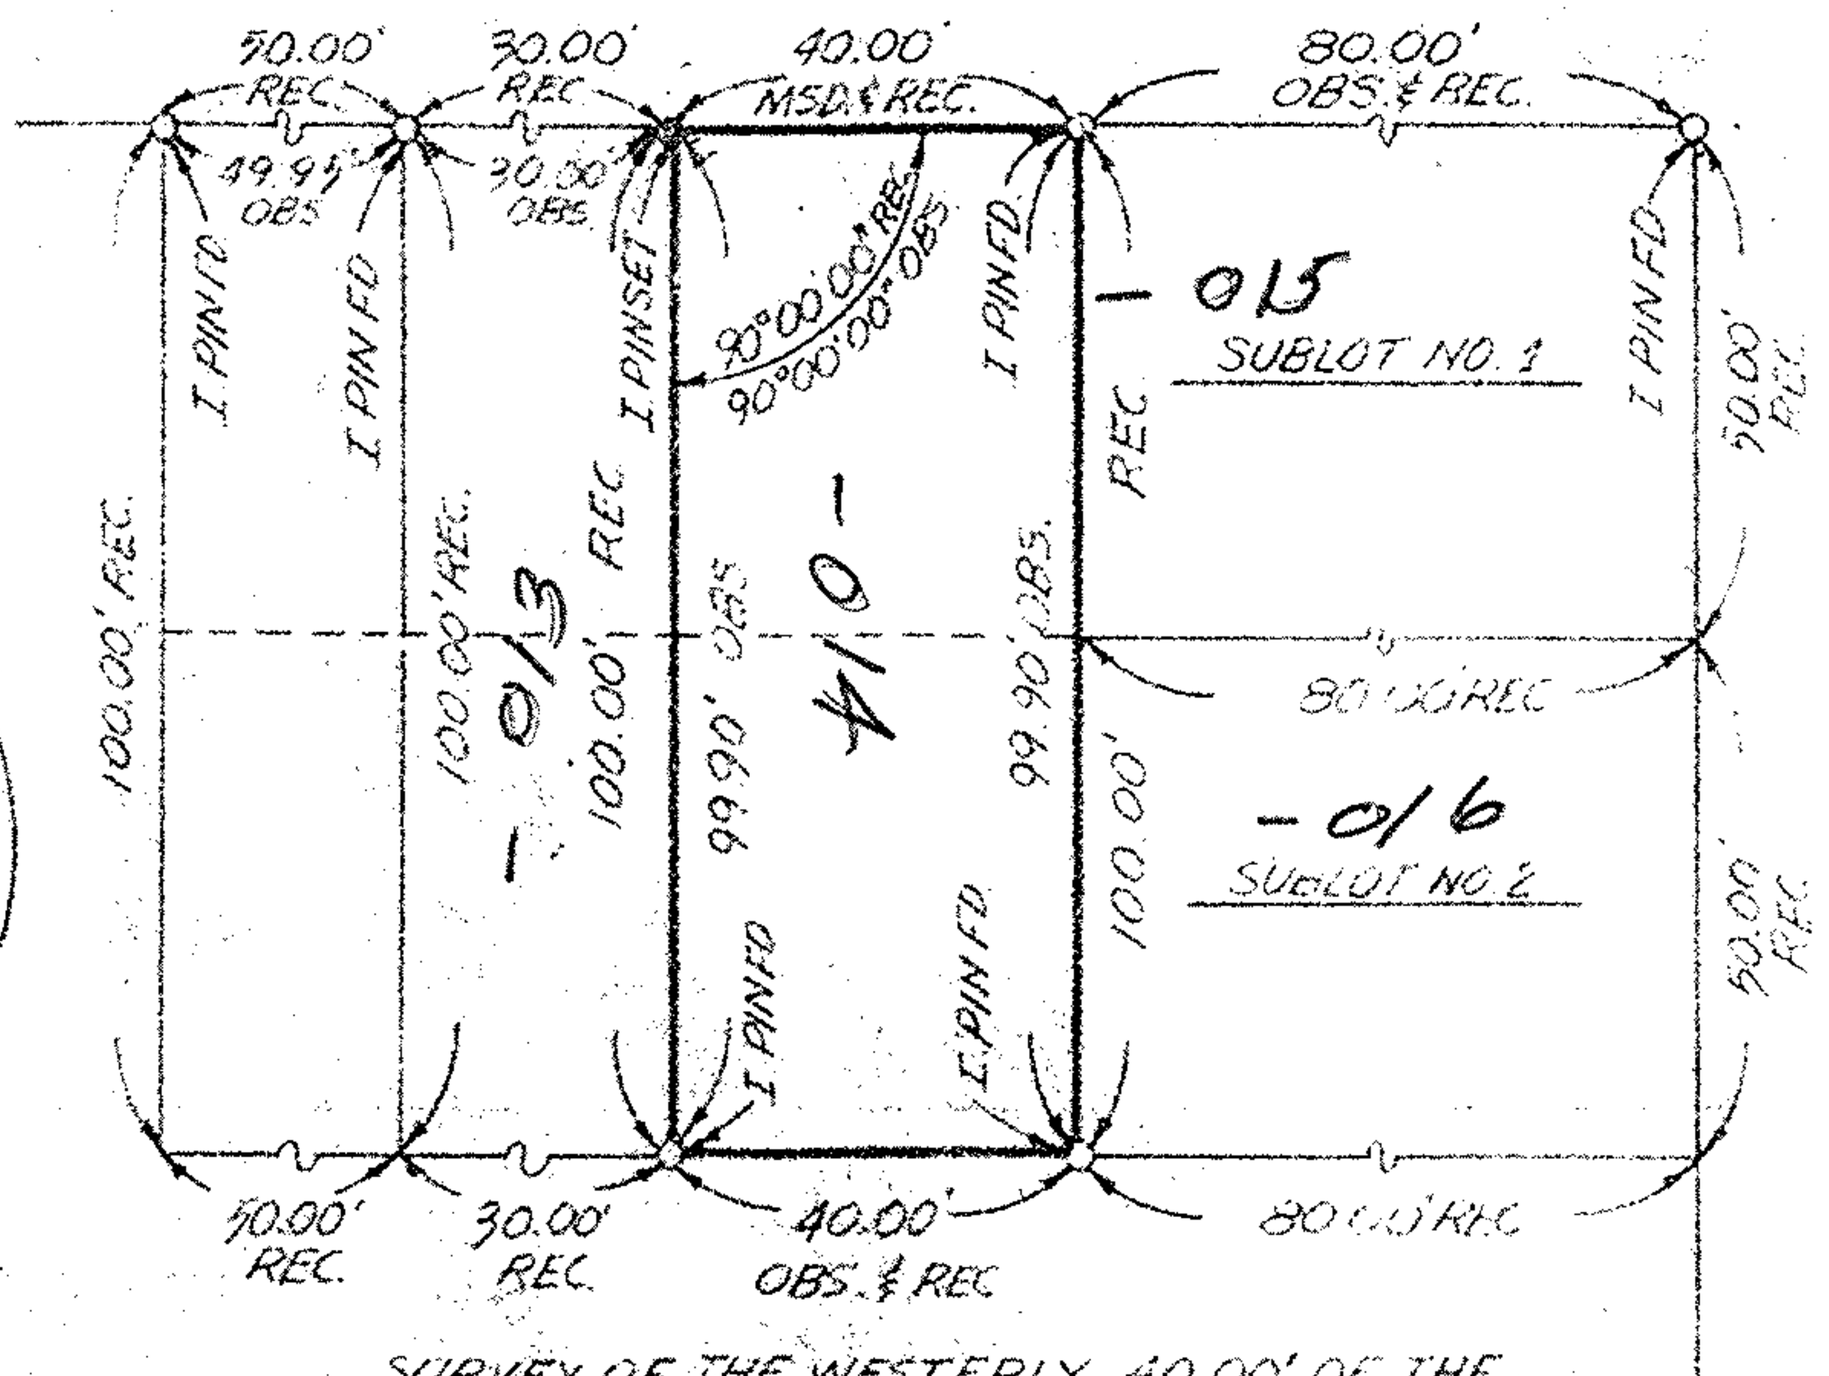

LONG AVENUE 66'

SURVEY OF THE WESTERLY 40.00' OF THE EASTERLY 120.00' OF SUBLOTS NO. 1 AND 2 OF CHAMBERLAIN'S ADDITION VOL. 2, PG. 11

DONALD THOMPSON
307 TENTH STREET
LORAIN, OHIO 44052

ORIGINAL LOT 4 TRACTS	DATE JULY 17, 1974
TOWNSHIP BLACK RIVER	SCALE 1" = 30'
CITY OF LORAIN	TITLE BOOK 225 Plat 67
COUNTY OF LORAIN	DRAWN BY R.W.H.
STATE OF OHIO	CHECKED BY J.F.H.
P. O. 2145	FILE NO. 2-01-4

PP # 02-01-004-114-014

02-01-004-114-014