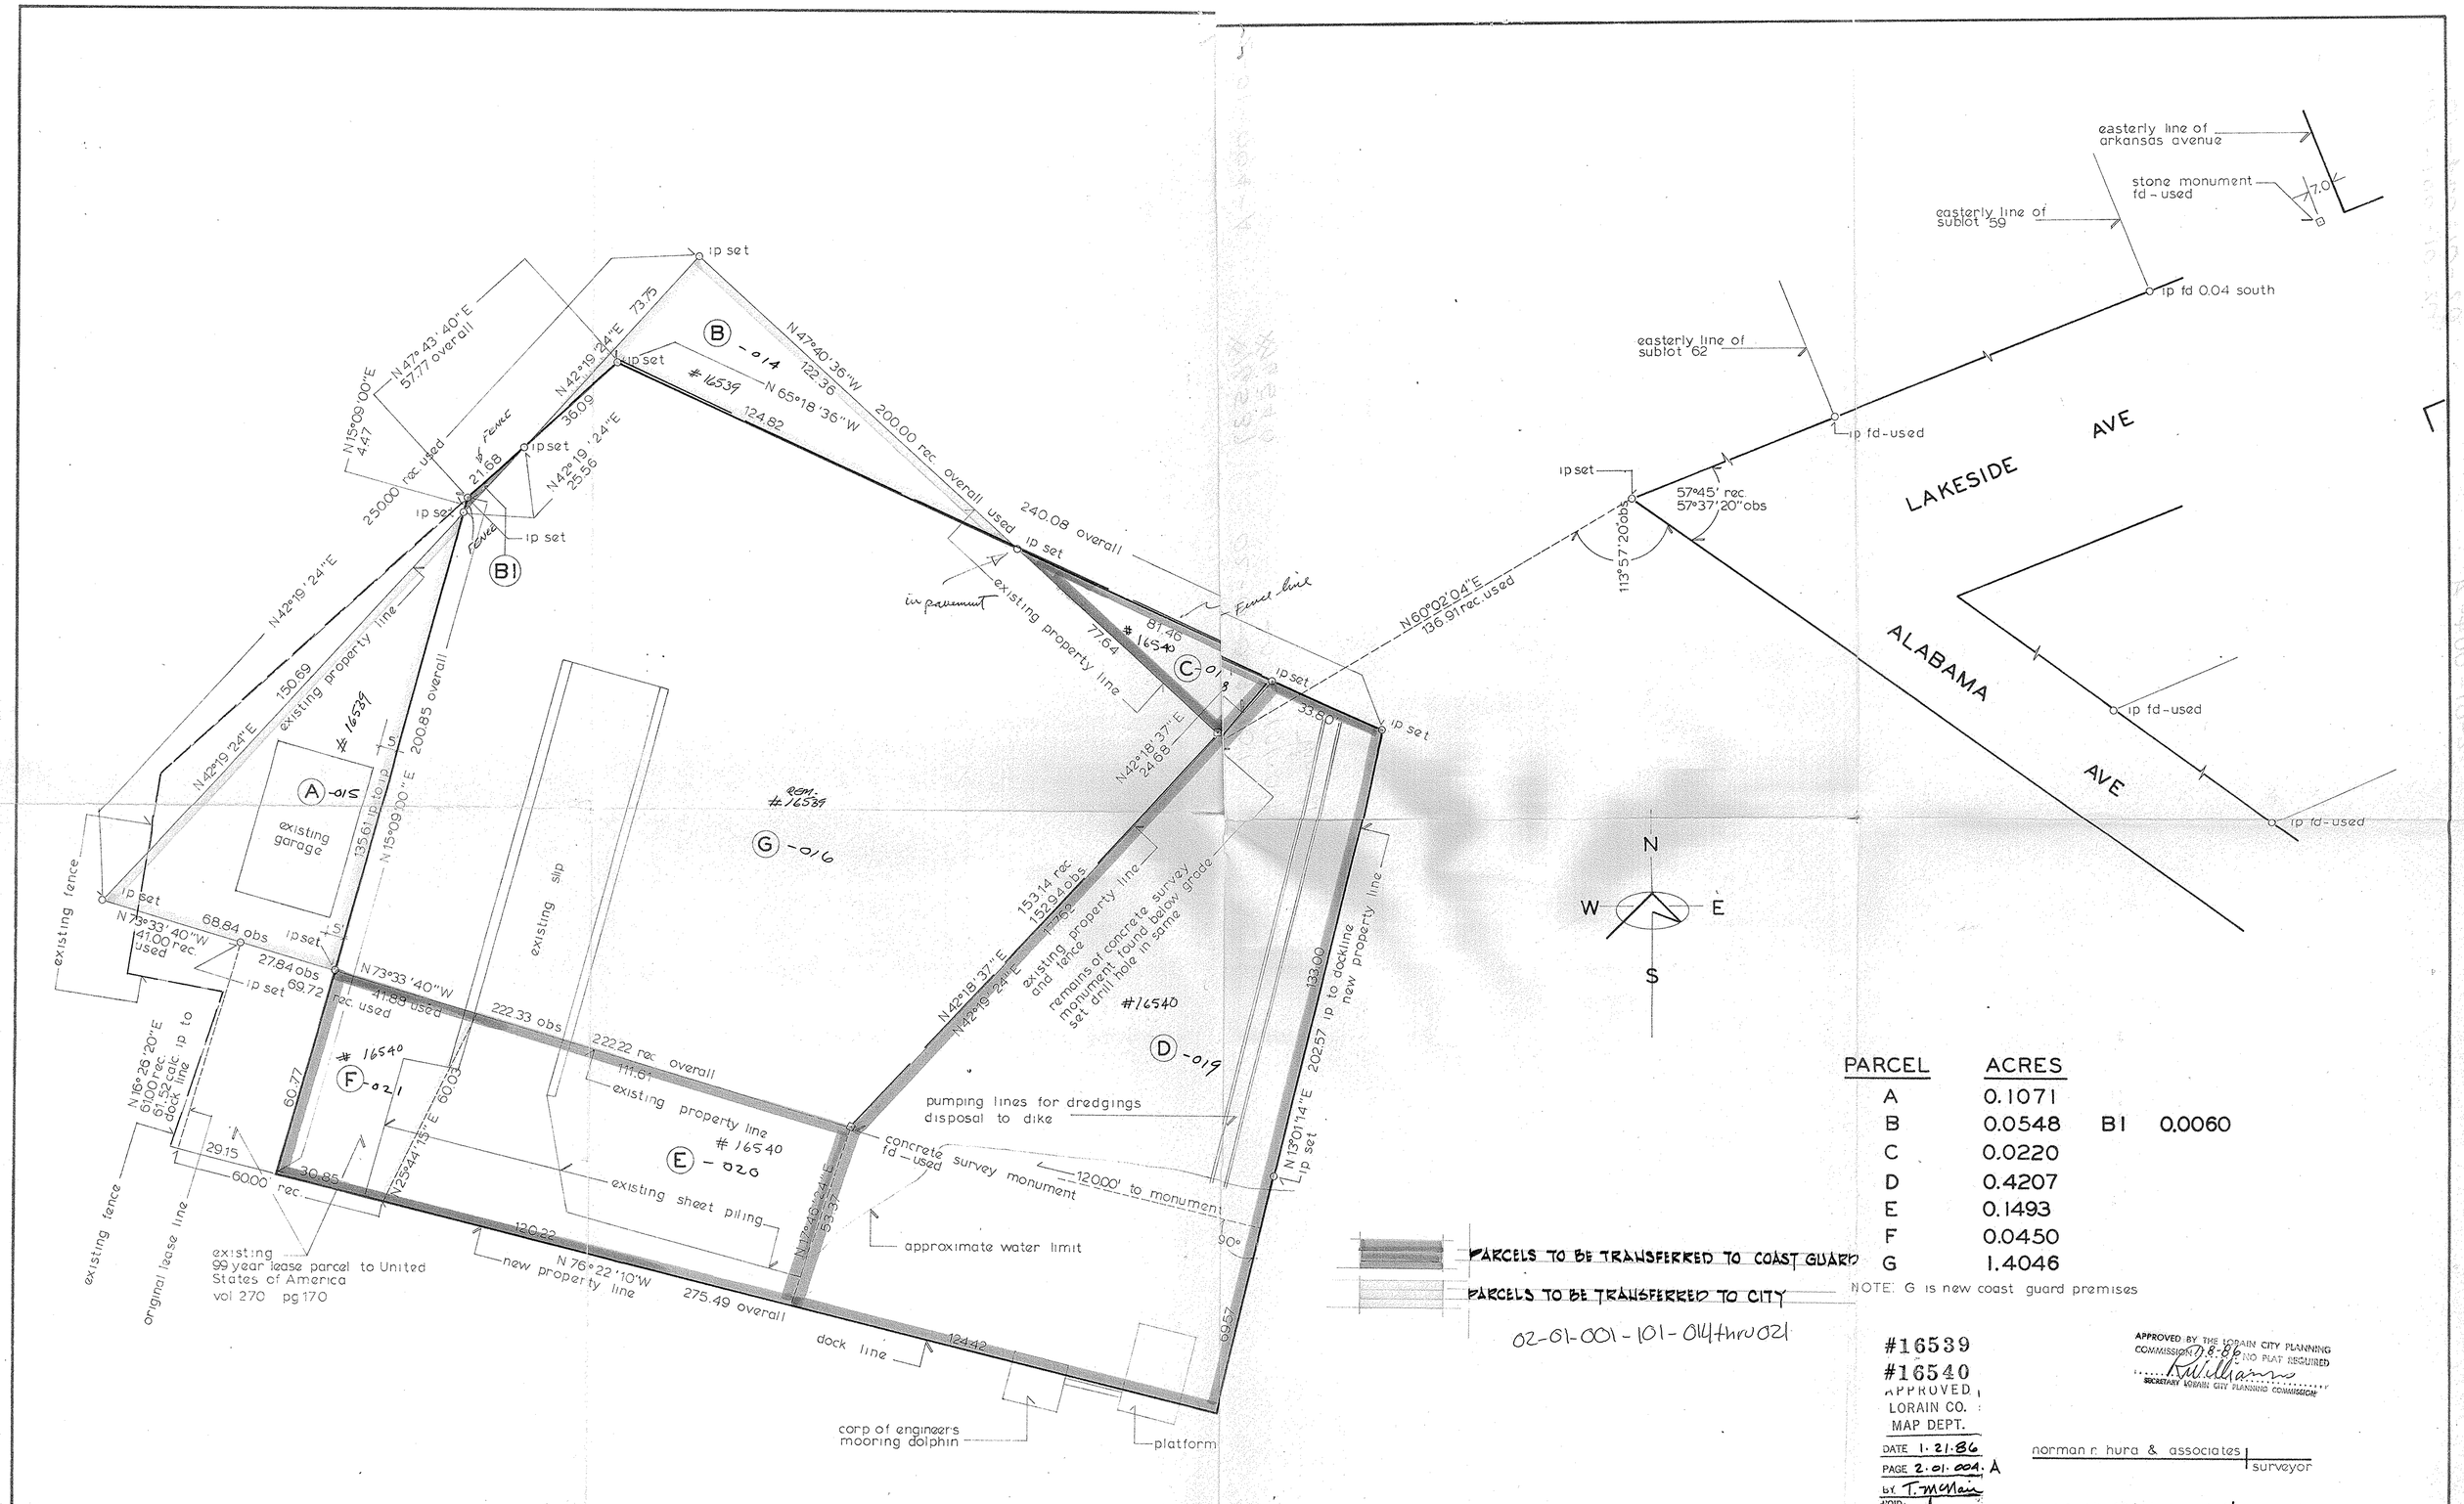

PARCEL	ACRES		
A	0.1071		
B	0.0548	B1	0.0060
C	0.0220		
D	0.4207		
E	0.1493		
F	0.0450		
G	1.4046		

NOTE: G is new coast guard premises

#16539
#16540
APPROVED
LORAIN CO.
MAP DEPT.
DATE 1.21.86
PAGE 2.01.004. A
BY T. McNair
VOID

APPROVED BY THE LORAIN CITY PLANNING COMMISSION 7-8-86 NO PLAT REQUIRED
R. Williams
SECRETARY LORAIN CITY PLANNING COMMISSION

norman r. hura & associates | surveyor

02-01-001-101-014 thru-021

STATE OF OHIO
N. R. HURA
S-5208
REGISTERED SURVEYOR

UNITED STATES COAST GUARD NINTH DISTRICT	PLAT OF SURVEY INDICATING ENCROACHMENTS AND LAND PARCELS TO BE EXCHANGED WITH CITY OF LORAIN	SCALE 1" = 20'-0" AUGUST 1983