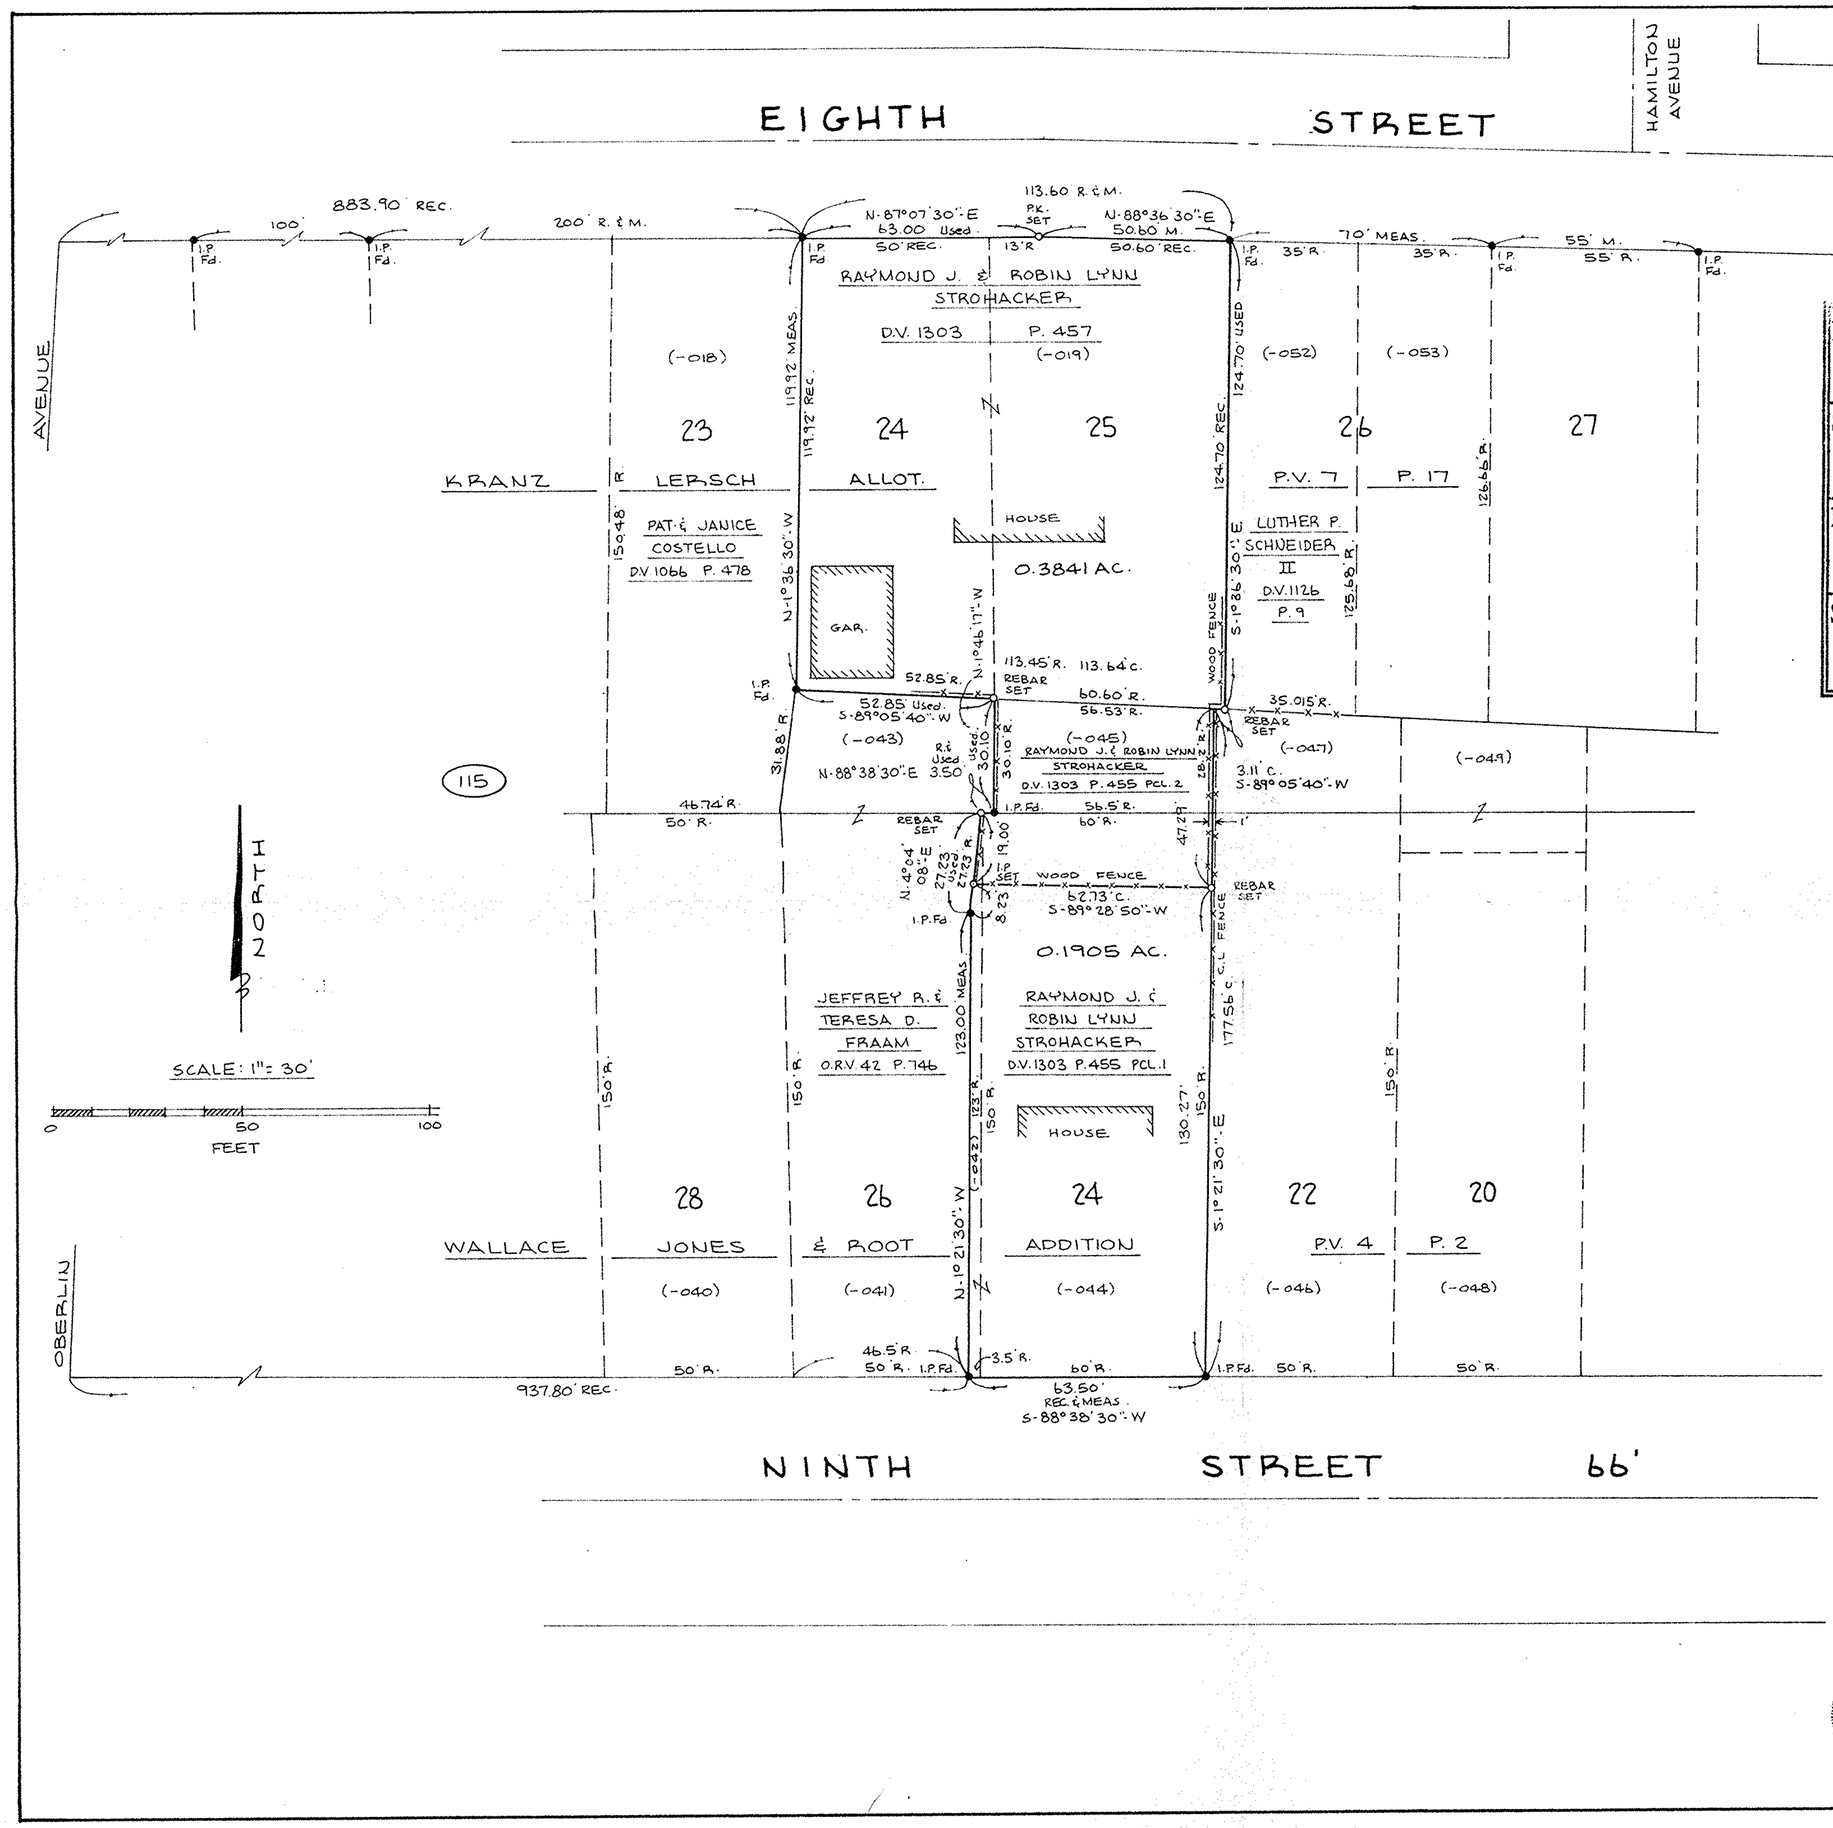

P.P. NO. 02-01-006-115-053, 052, 018, 019

SPLIT # 20270

DATE OF SURVEY

MAP PAGE 02-01-006-B

SURVEYOR David L. Elwell

20270

APPROVED
LORAIN CO.
MAP DEPT.
DATE 2-23-93
PAGE 2-01-006-B
BY CAROLYN FRANCIS
VOID AFTER # 20270

02-01-006-115

BOUNDARY SURVEY

SUBLOTS 24 & 25 IN KRANZ LERSCH ALLOTMENT
P.V. 7 P. 17

SUBLOT NO. 24 & PART OF SUBLOT NO. 26 IN WALLACE, JONES & ROOT ADDITION
P.V. 4 P. 2

PART OF ORIGINAL LOT NO. 6 IN TRACT NO. 1 OF BLACK RIVER TOWNSHIP

CITY OF LORAIN COUNTY OF LORAIN STATE OF OHIO

PREPARED BY
KS ASSOCIATES INC.
ENGINEERS SURVEYORS

STATE OF OHIO
DAVID L. ELWELL
6333
REGISTERED SURVEYOR

David L. Elwell
REG. SURVEYOR NO. 6333
1-18-93

92-599