HAPONEK & ASSOCIATES, INC. Engineers & Surveyors
34100 Center Ridge Road • NORTH RIDGEVILLE, OHIO 44039 • (440) 327-4776 • Lorain 288-4400

02-01-006-109-034, 035

SURVEY AND SPLIT
OF
SUBLOT 171 AND WESTERLY 3 FT. OF S/L 172
IN
ORIGINAL PLAT OF CHARLESTON PLAT VOL. J P. 446
CITY OF LORAIN COUNTY OF LORAIN
STATE OF OHIO

PREPARED FOR:
ELIN INVESTMENTS
PO BOX # 143
GRAFTON, OH 44044 02-01-006-109-034 & 035

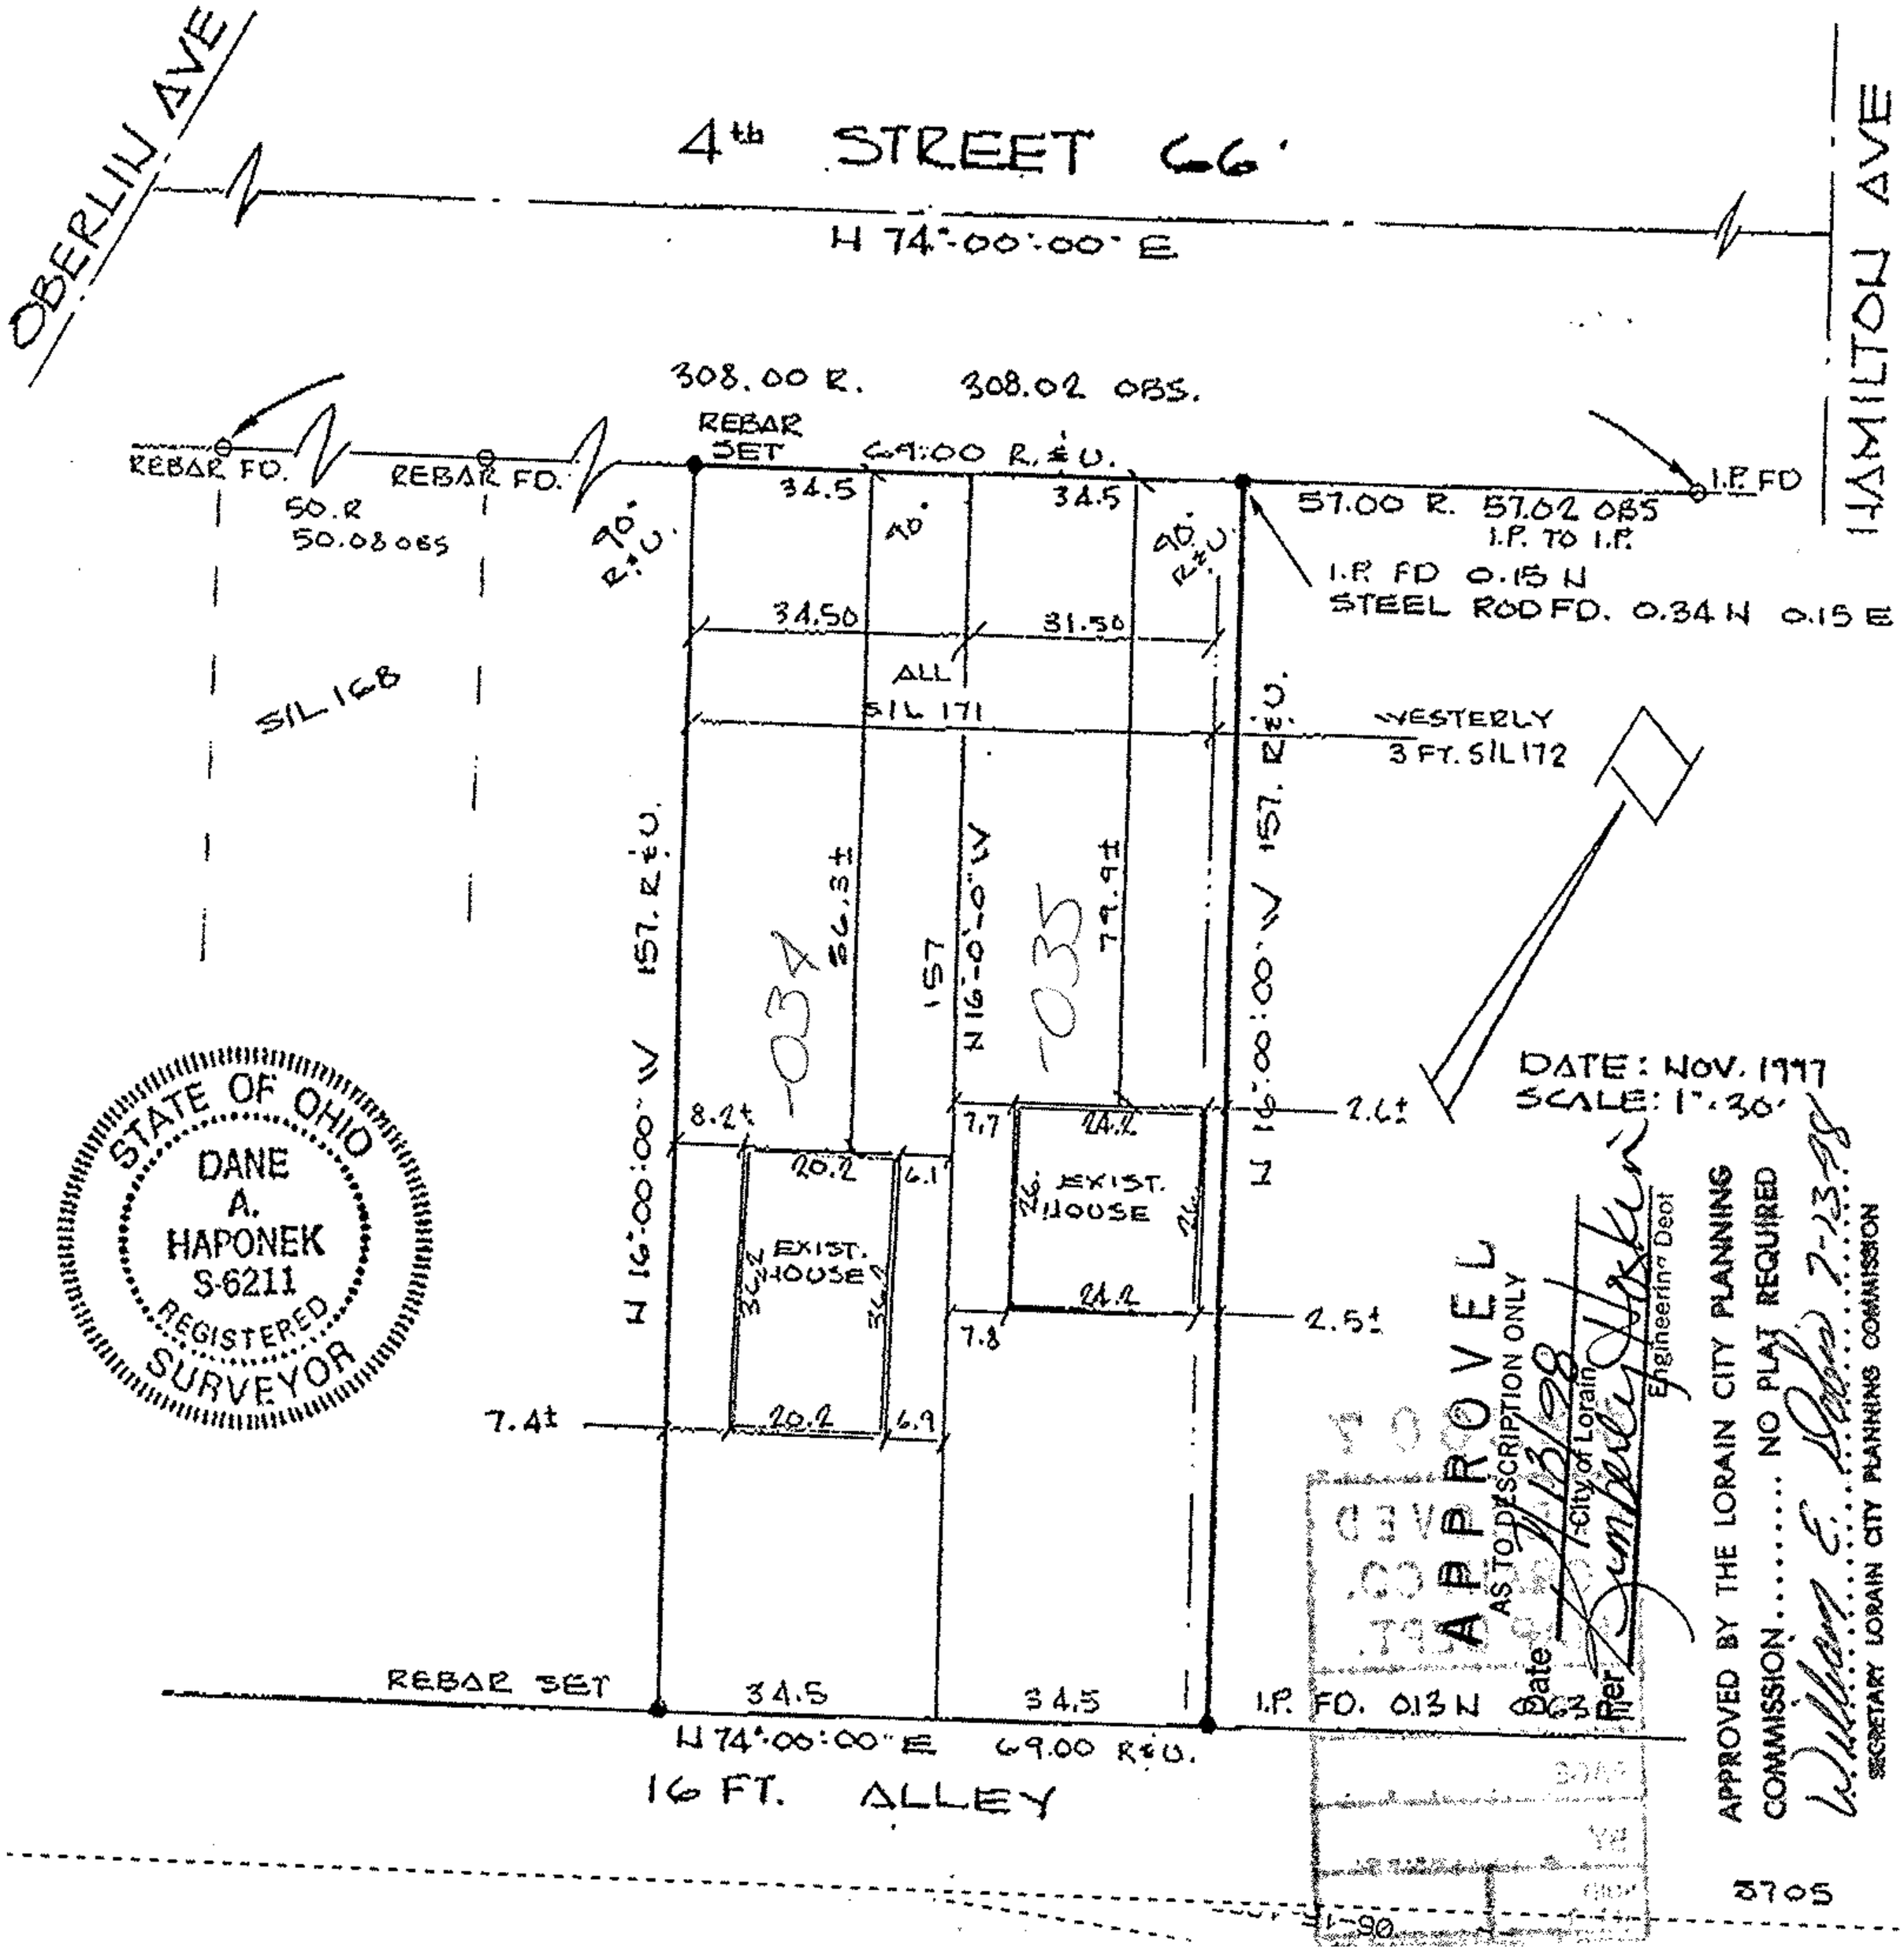

STATE OF OHIO
DANE
A.
HAPONEK
S-6211
REGISTERED
SURVEYOR