
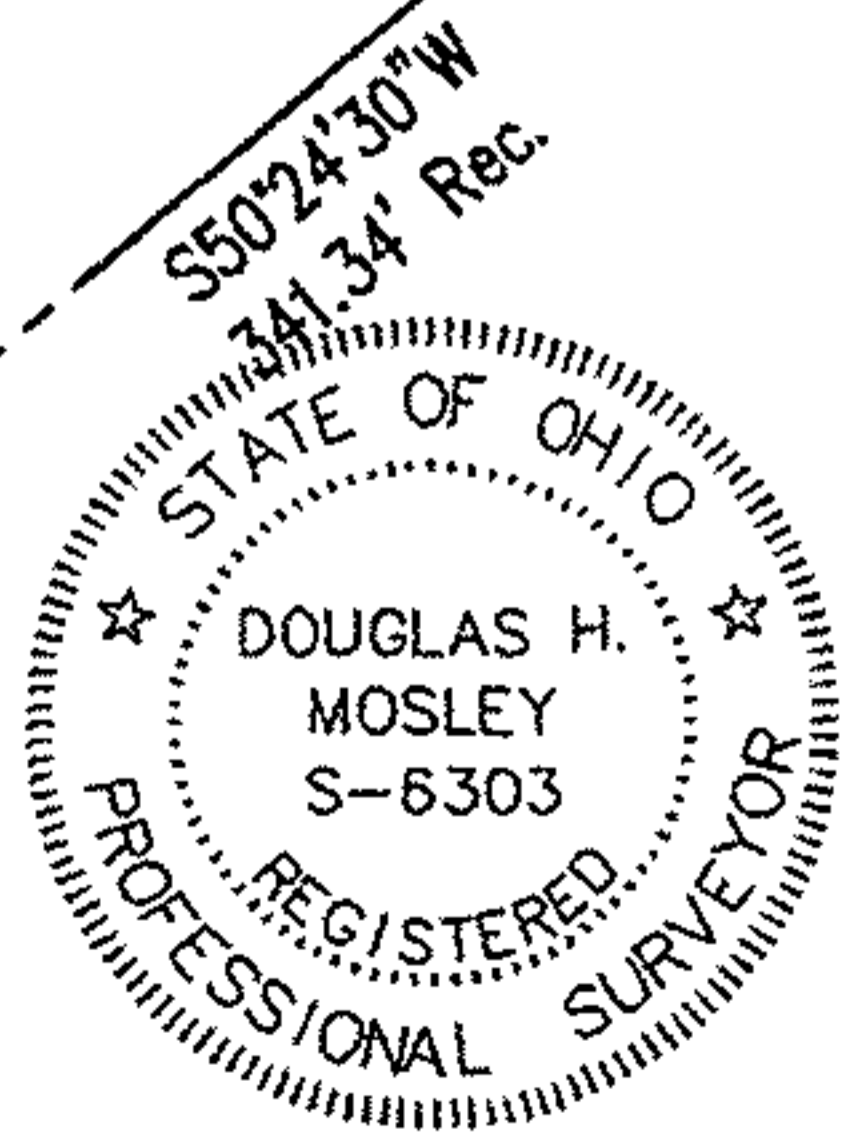


Butternut Ridge Road

APPROVED
LORAIN CO.
MAP DEPT
DATE 12/30/01
PAGE 11-00-093-A
BY D. Mosley
#01-0089-A

Survey Map
 Eaton Township ~ Lorain County ~ State of Ohio
 Part of Original Eaton Township Lot 93
 P.P.N. 11-00-093-102-064
 Deed Vol. 565 Pg. 427

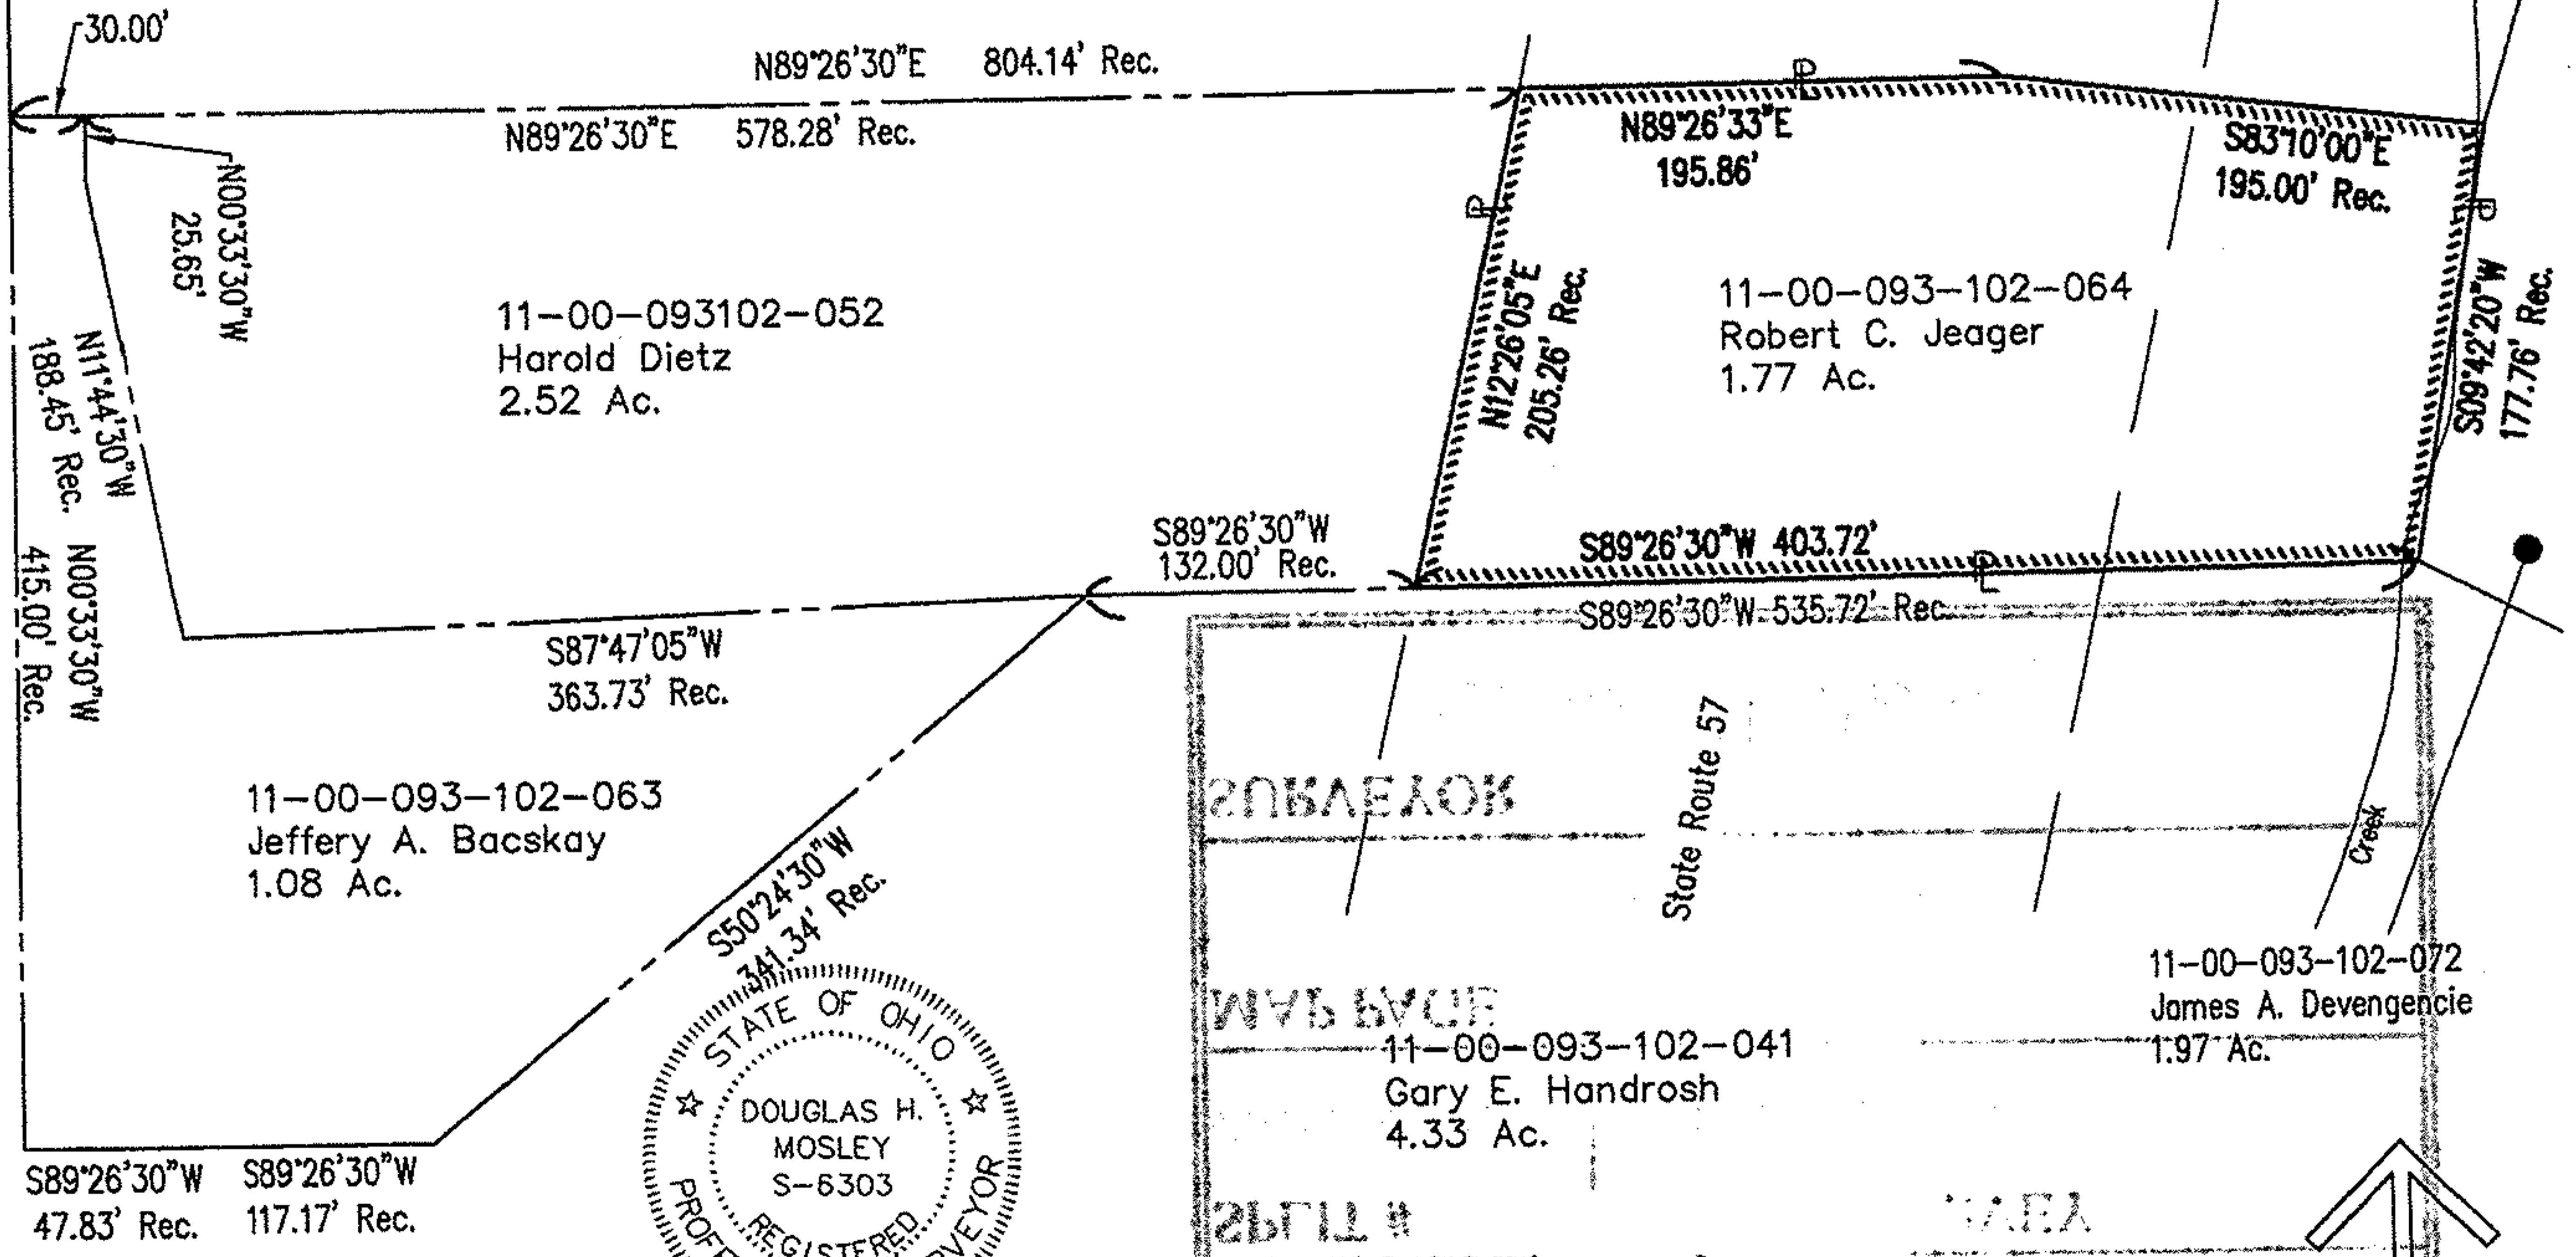

Doug Mosley
 1/1/04

Scale
 1" = 100ft

