PARENT PARCEL: 02-02-023-101-012

CHILD PARCEL: XX-XX-XXX-XXX-XXX

STARTING POINT: I.P. FOUND AT THE INTERSECTION OF THE EAST LINE OF S\L NO.286 & N. LINE OF HARBORVIEW BLVD..

NO. 22593-D

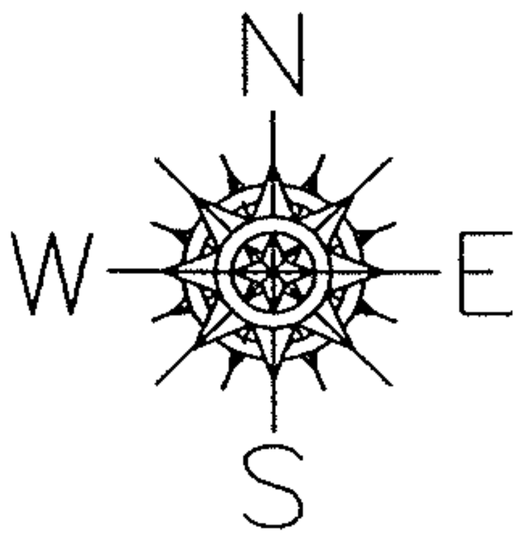

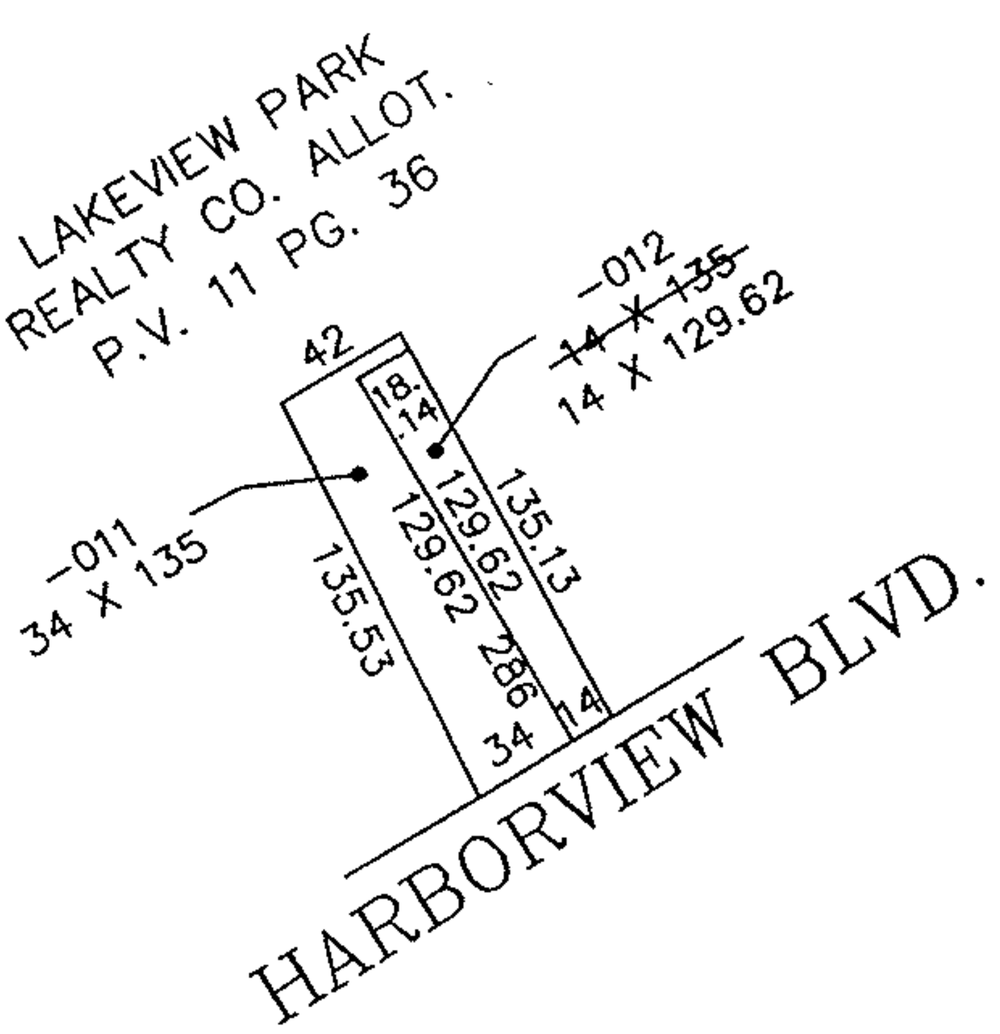

SPLITS/DEEDS PROCESSED

LORAIN COUNTY TAX MAP DEPARTMENT
226 MIDDLE AVE. ELYRIA, OHIO

SURVEYED BY: RAY E. HOLLIS

CLOSURE: CAN'T RUN

MAP PAGE(S): 02-02-023-A

APPROVED BY: TJS DATE: 07/22/98

SCALE: 1"= 100 PRIOR INSTRUMENT: DV 838/464