9940
9961
2-02-02 1B

2-02-021-113

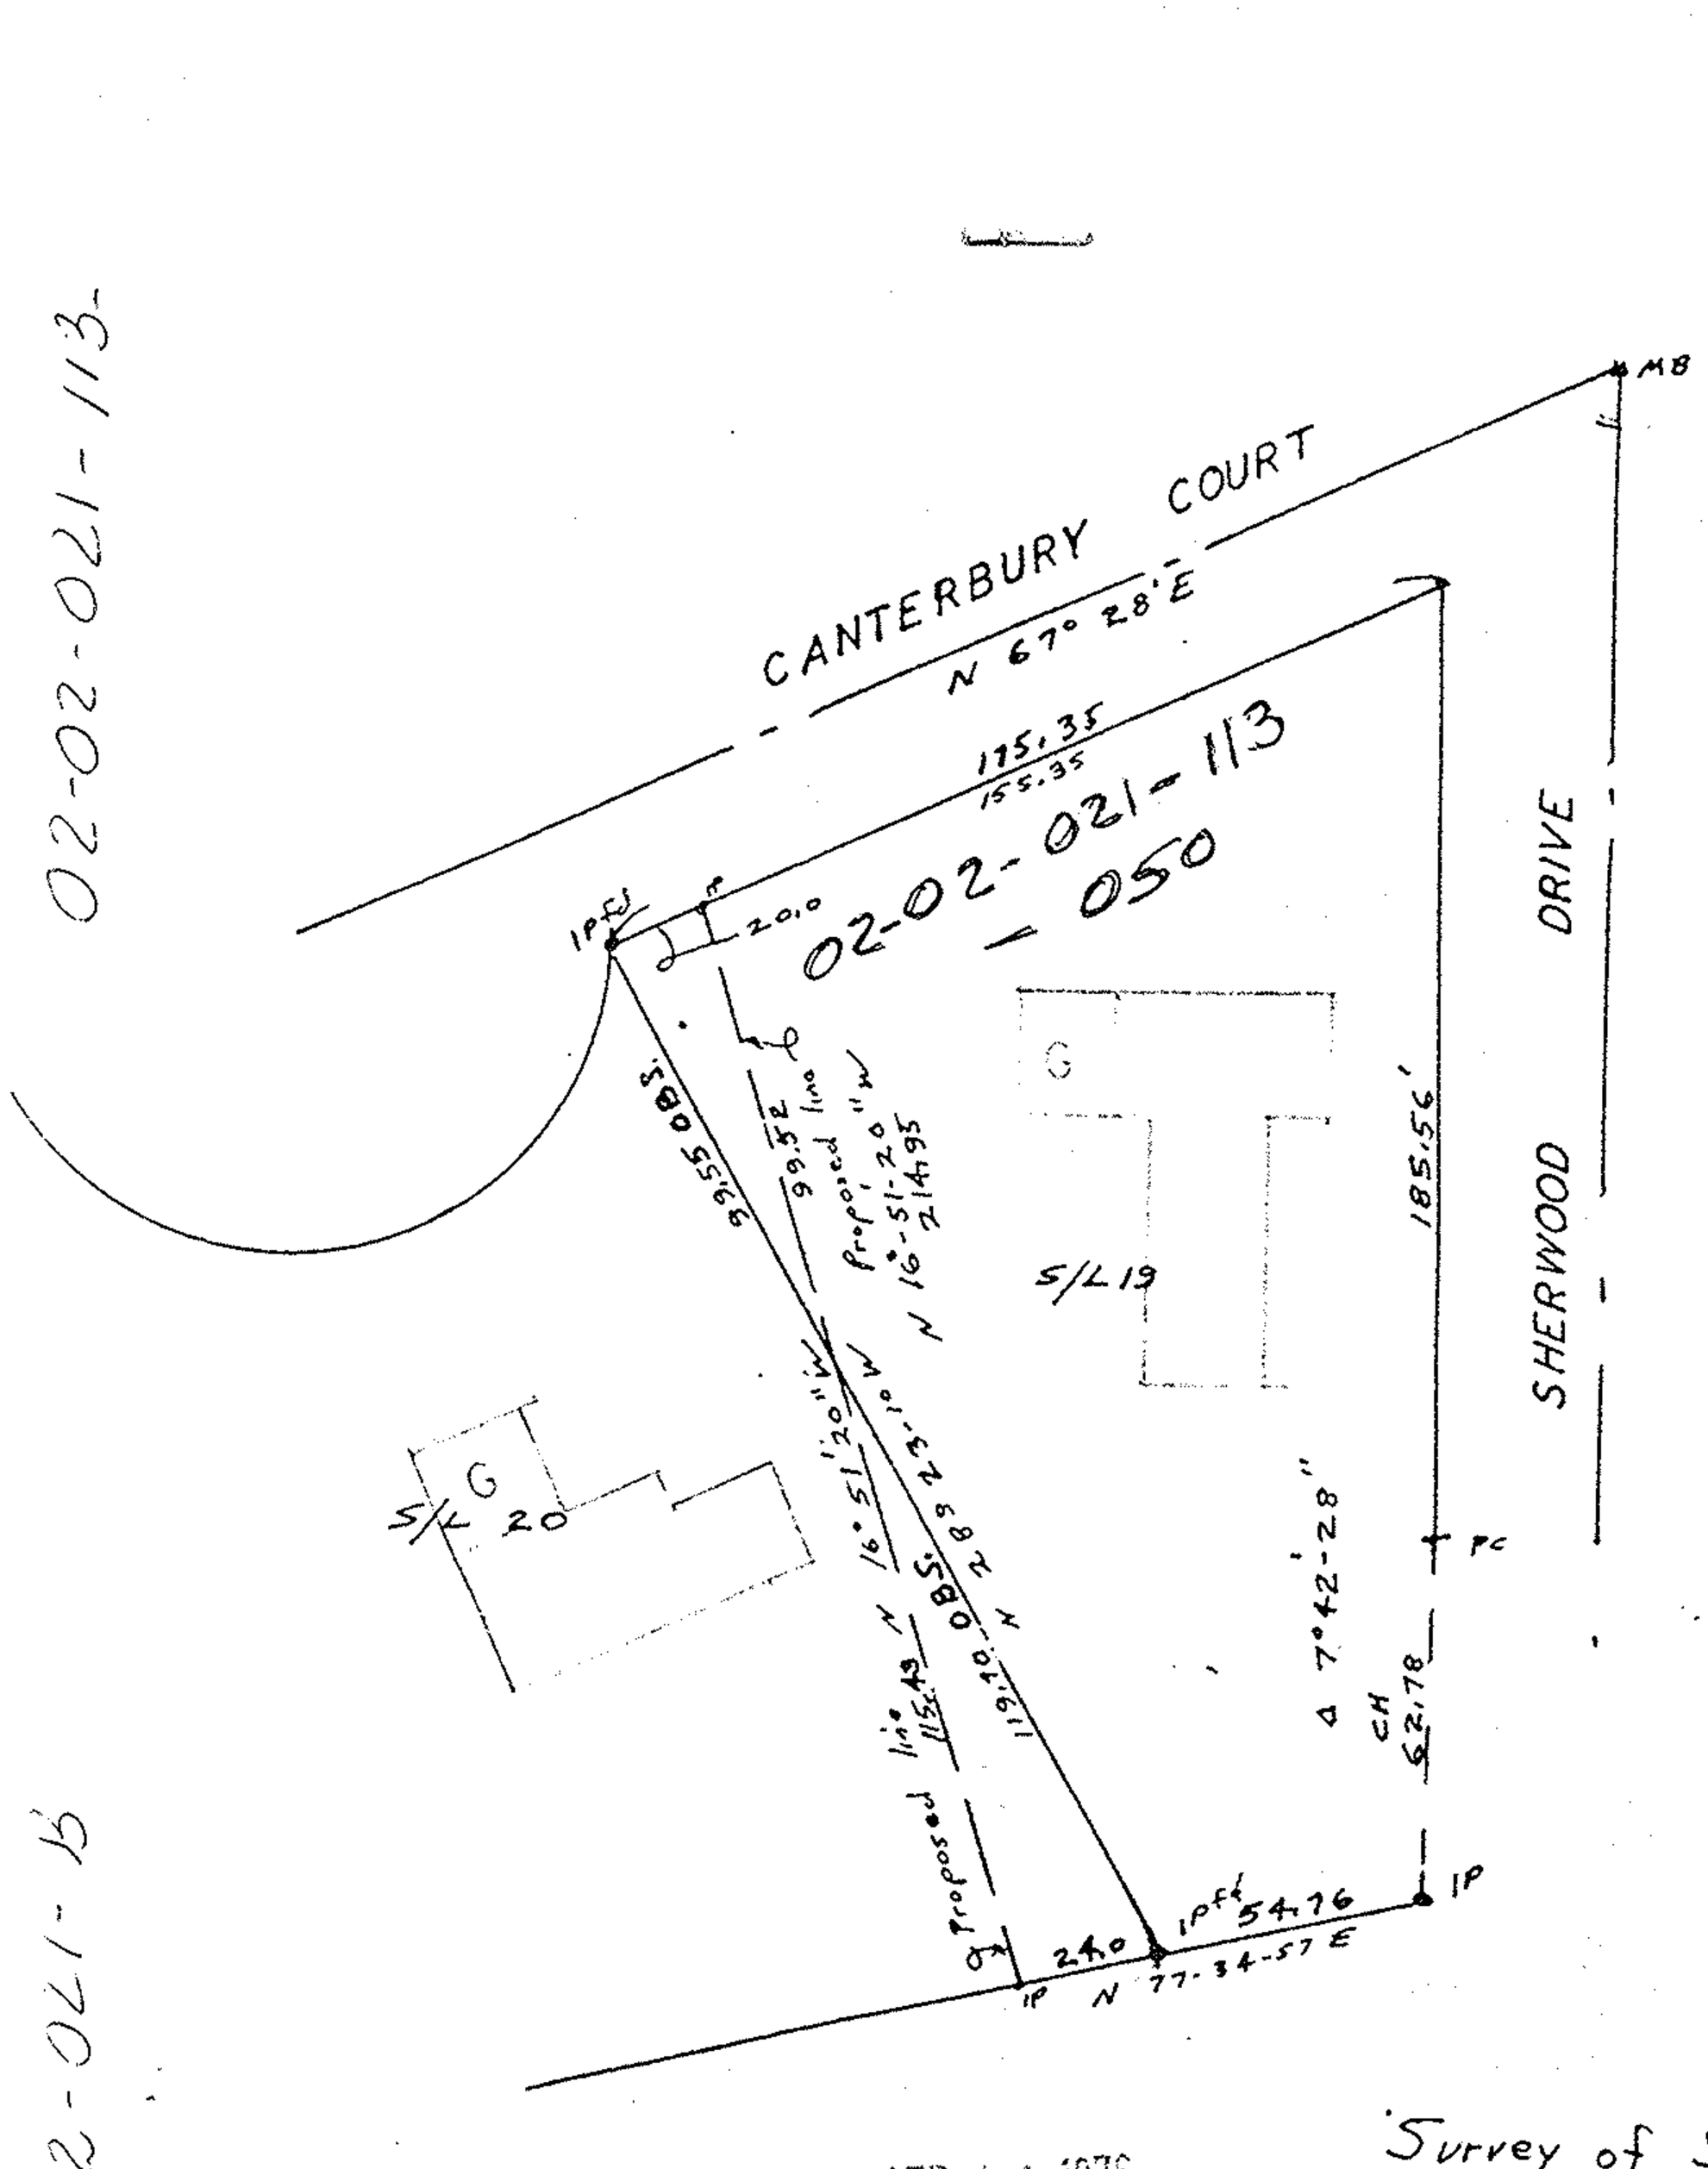

2-02-021-15

SEP 1 9 1976

John Pozywak
Reg Surveryor
#5292

APPROVED BY THE LORAIN CITY PLANNING COMMISSION
NO PLAT REQUIRED

Pat McGanna
APPROVED

Survey of Sublot 19
Sherwood Allotment
Plat Volume 17 Page 33
Tract 2 Original lot 21
Original Black River Twp
City of Lorain
Lorain County Ohio
CITY of Lorain
Lorain County Ohio
Scale 1" = 50' Aug 28, 1976

Revised