


N 0°41'10"E

ASHLAND AVE. 60'

02-02-016-109-033  
02-02-016-109

South East Pin

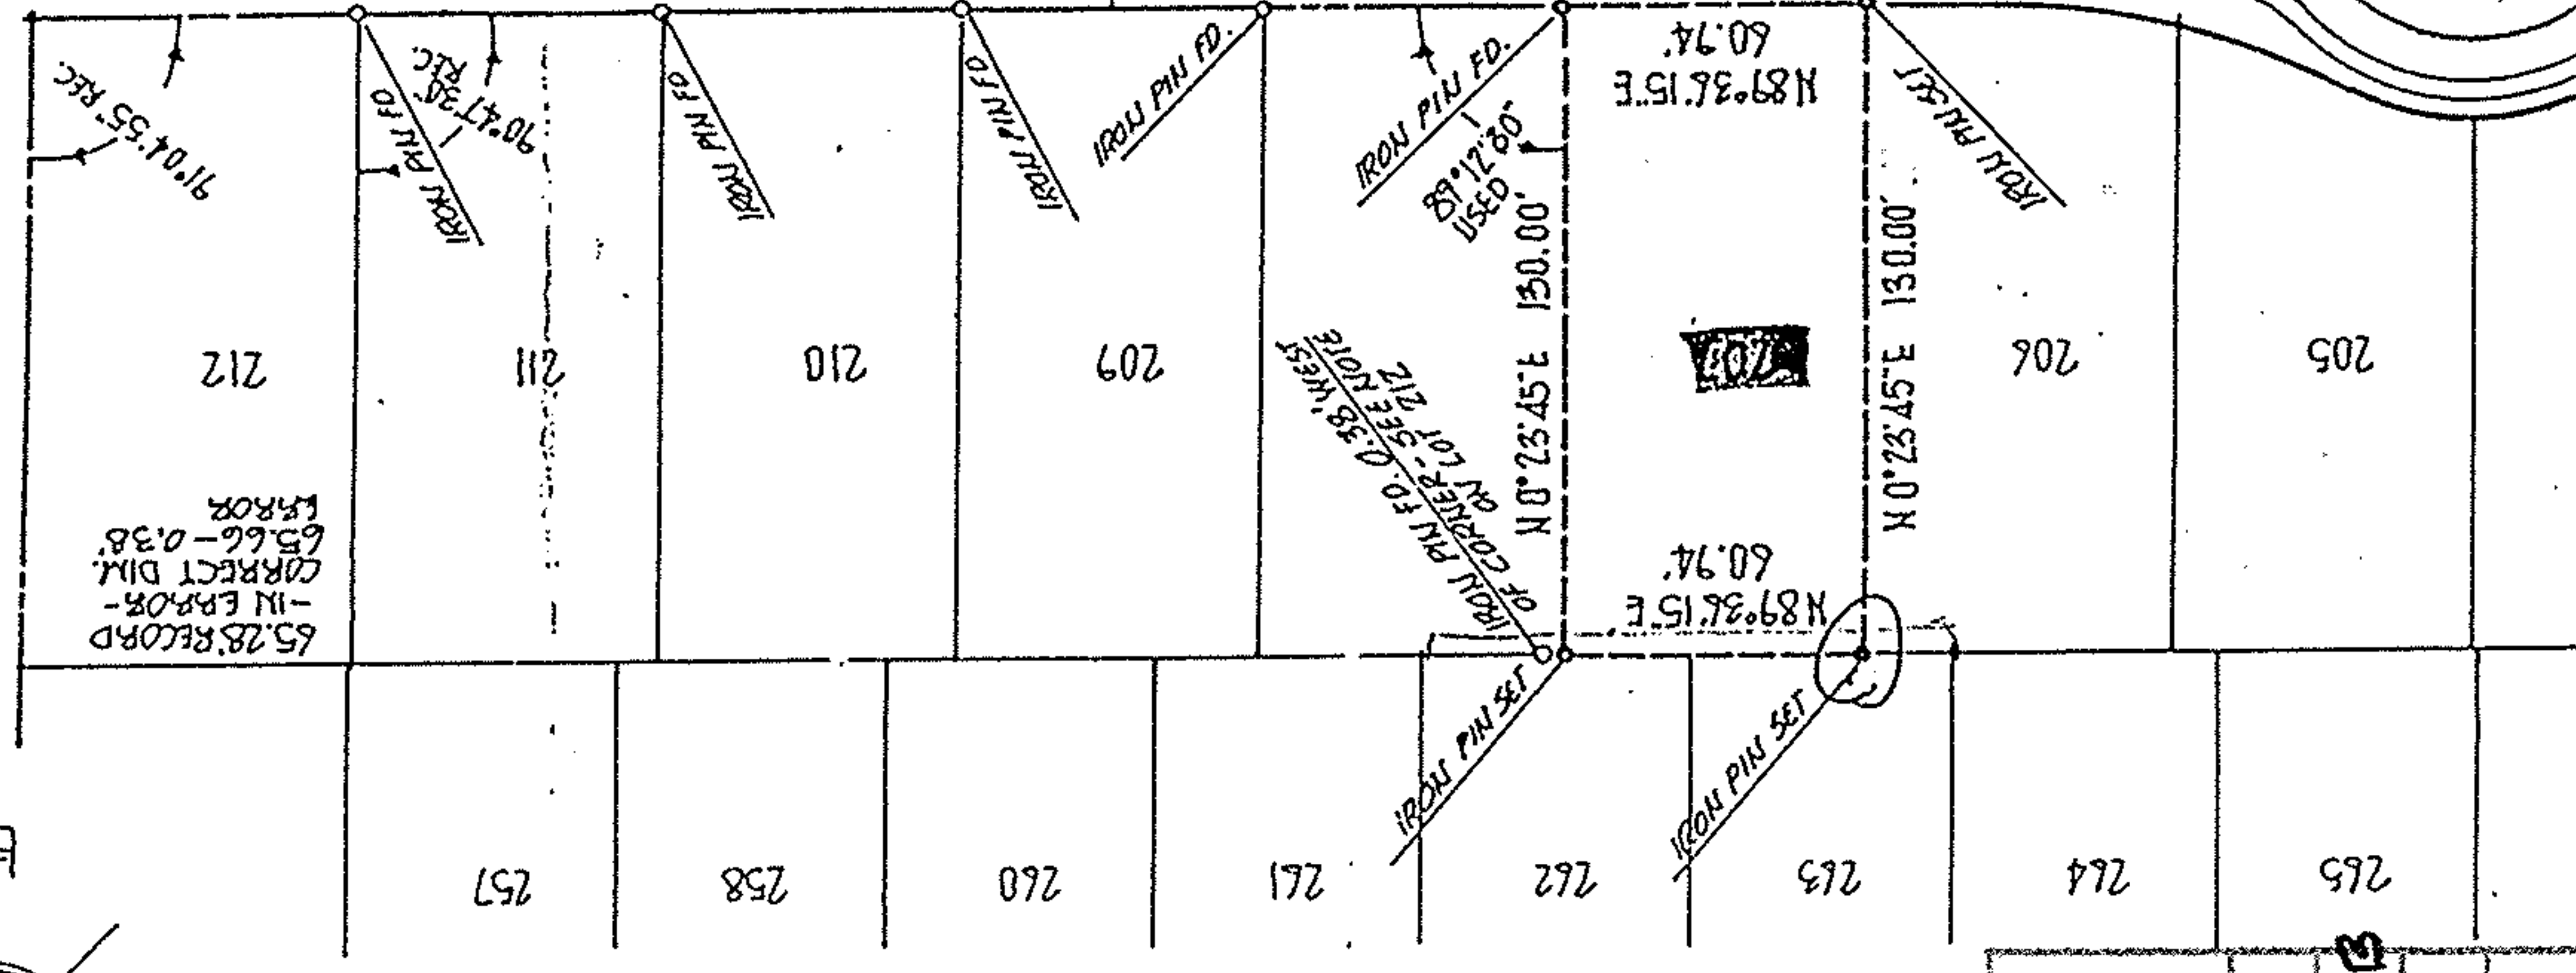

WEST 27th COURSE  
E N 89°24'15"E

#16642

APPROVED  
LORAIN CO.  
MAP DEPT.

DATE 3.18.86

PAGE 2.02.016.13

BY T. McMain


OID  
FTER

ACREAGE DATE 07-20-82 SCALE 1" = 60 FT. DRAWN MGH

PREPARED FOR: MR. & MRS. FREDERICK TRUSKOT  
1809 WEST 27th CT., LORAIN, OHIO  
SITUATED IN THE CITY OF LORAIN OHIO

PERMANENT PARCEL NO.  
2-02-016-109-033

Michael G. Hura and Associates  
3409 LIBERTY AVENUE VERMILION, OHIO  
**PERIMETER SURVEY**  
PART OF O.L. TR. SECTION OF  
BLACK RIVER Township LORAIN County, Ohio  
SUBLOT 207 of AMENDED HILLCREST ALLOTMENT  
VOL. 19 PAGE 32 OF PLATS

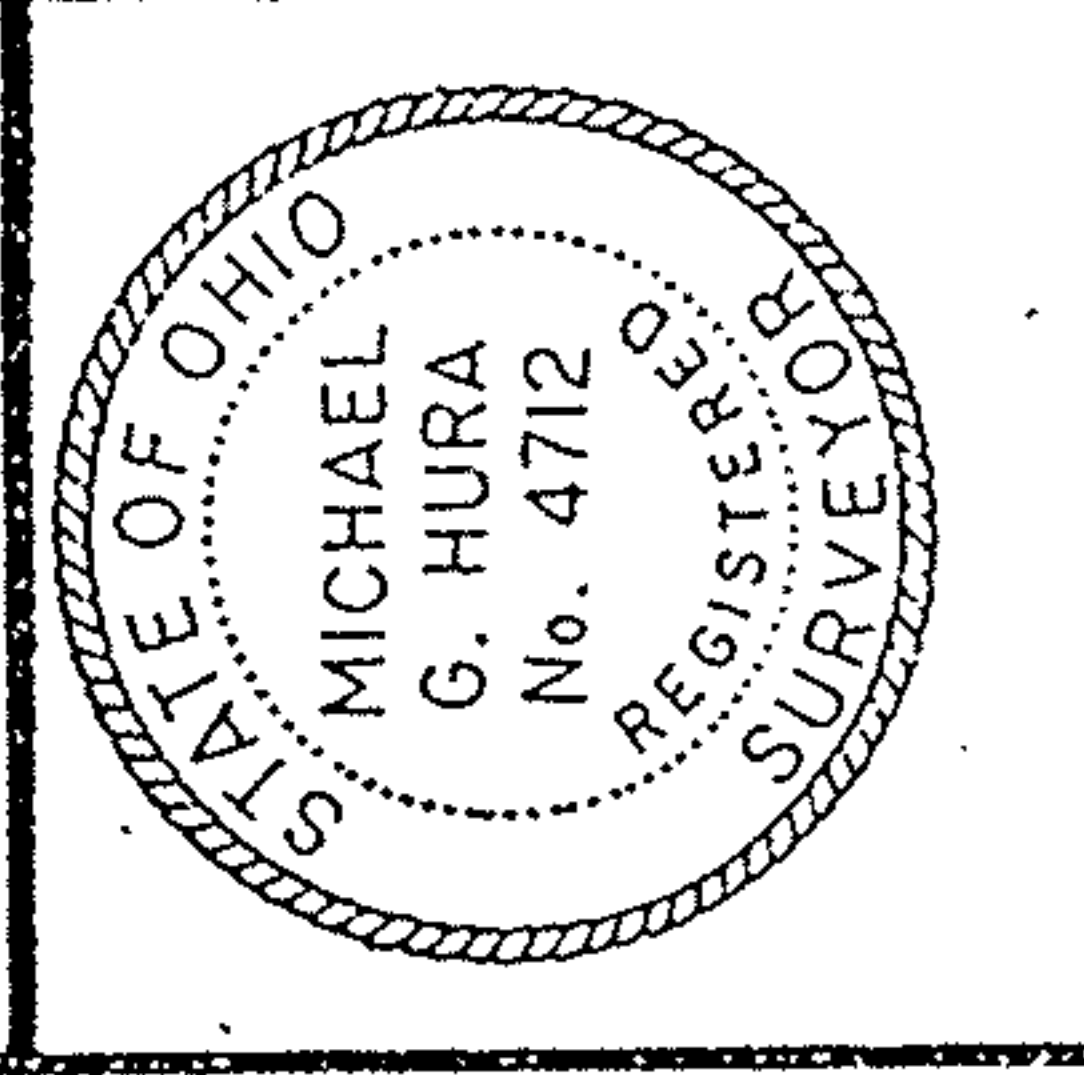

2-02-016-B