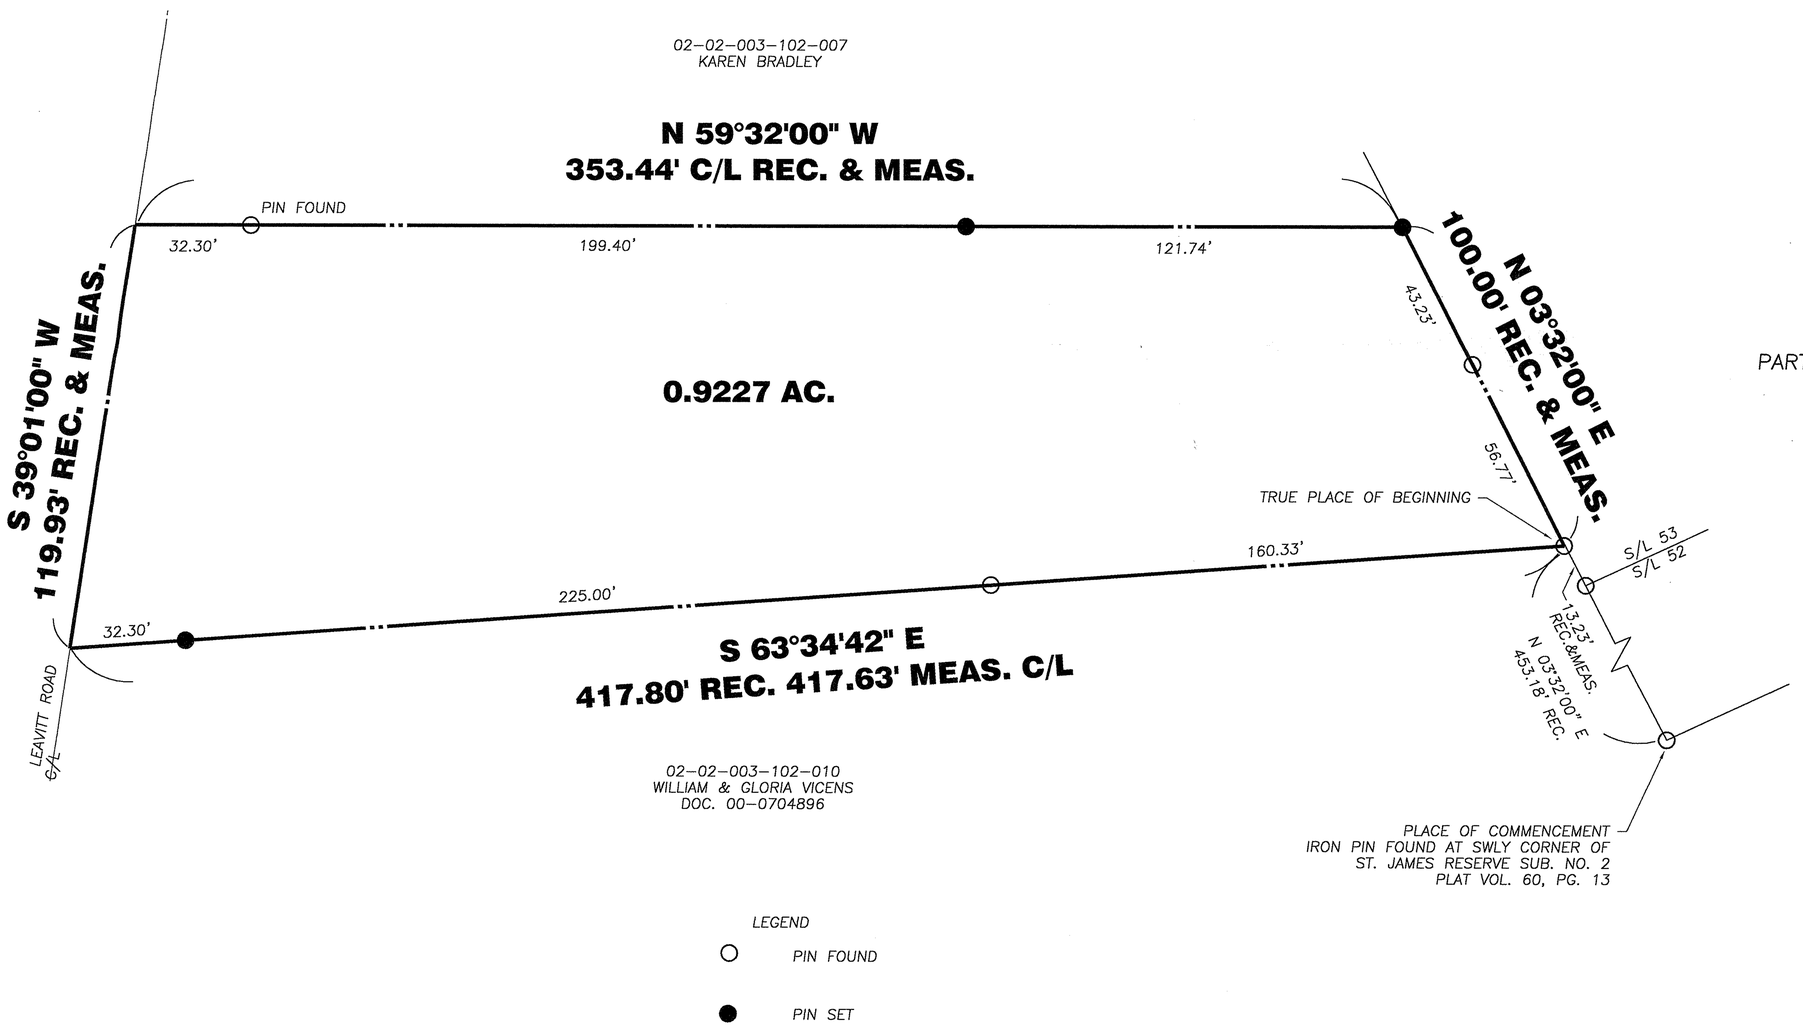

AREA MAP NO SCALE

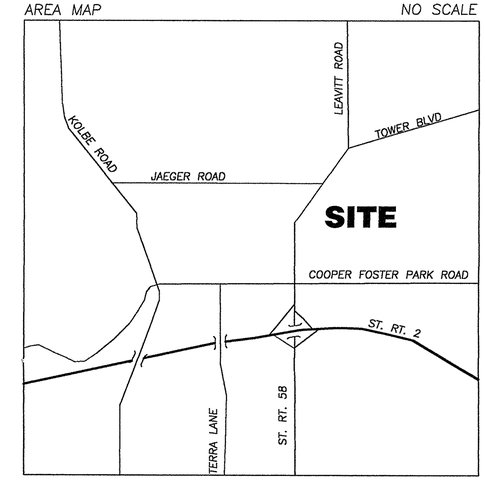

BOUNDARY SURVEY

CITY OF LORAIN LORAIN COUNTY
STATE OF OHIO
PART OF ORIGINAL BLACK RIVER TOWNSHIP 2, TRACT 2
DOC. 01-0730714
P.P.N. 02-02-003-102-016

SURVEYOR'S CERTIFICATION

THIS IS TO CERTIFY THAT AT THE REQUEST OF THE OWNERS I HAVE SURVEYED AND PLATTED 0.9227 ACRES OF LAND AS SHOWN HEREON IN ORIGINAL BLACK RIVER TOWNSHIP LOT 2, TRACT 2, CITY OF LORAIN, COUNTY OF LORAIN, STATE OF OHIO. DISTANCES ARE SHOWN IN FEET AND DECIMAL PARTS THEREOF. BEARINGS SHOWN ARE ASSUMED AND USED TO DESCRIBE ANGLES ONLY. ALL OF WHICH I CERTIFY TO BE CORRECT.

STATE OF OHIO
DOUGLAS H. MOSELEY
S-6303
REGISTERED PROFESSIONAL SURVEYOR

PREPARED FOR
JACQUELYN FRANTZ
4945 LEAVITT ROAD
LORAIN, OHIO

PREPARED BY
HAYWOOD CIVIL ENGINEERING
& LAND SURVEYING
630 CLEVELAND STREET
ELYRIA, OHIO 44035
(440) 365-9831
(440) 365-3426 FAX

02-02-003-102-016

N W E S

0 20 40 80
1 IN. = 40 FT.

No 00749-D

APPROVED
LORAIN CO.
MAP DEPT.
DATE 9-11-02
PAGE 2-02-003
BY R. MAINES
VOL. 02 PAGE 00749-D

Haywood
CIVIL ENGINEERING & LAND SURVEYING
ELYRIA, OHIO

9/10/02