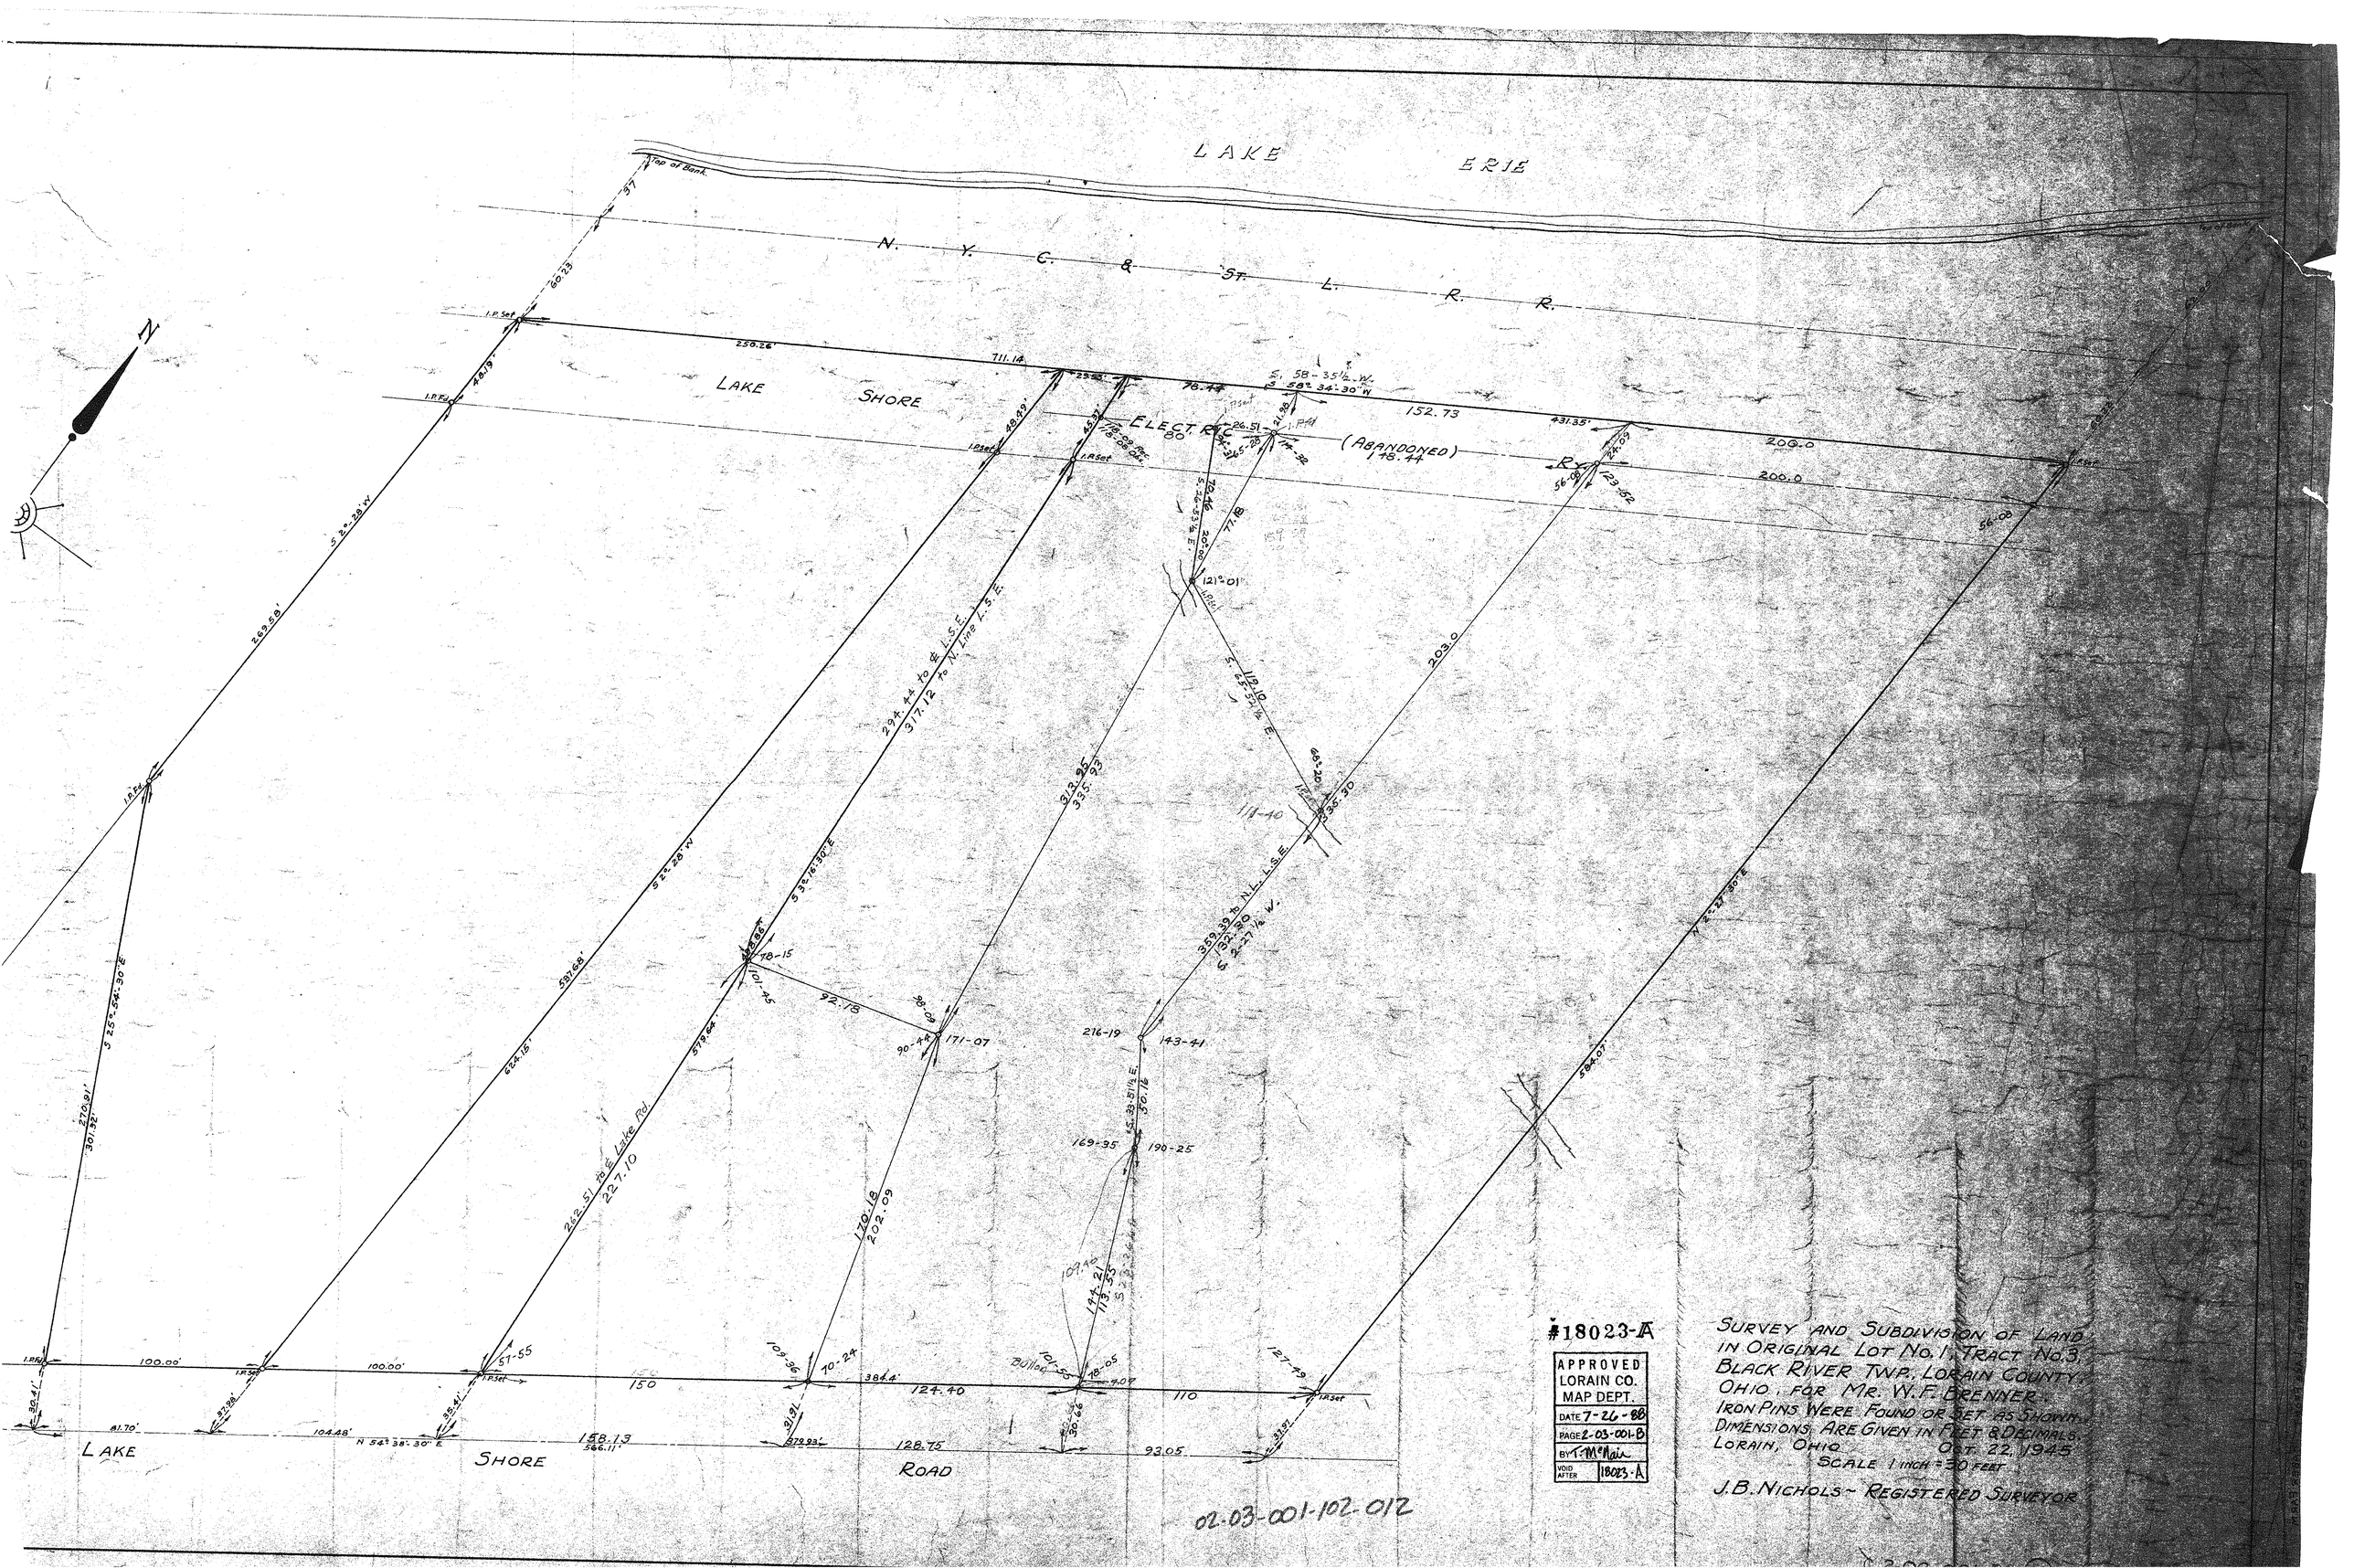

#18023-A

APPROVED LORAIN CO. MAP DEPT.
DATE 7-26-88
PAGE 2-03-001-B
BY T. McNair
VOID AFTER 18023-A

SURVEY AND SUBDIVISION OF LAND IN ORIGINAL LOT No. 1, TRACT No. 3, BLACK RIVER TWP., LORAIN COUNTY, OHIO, FOR MR. W. F. BRENNER.
IRON PINS WERE FOUND OR SET AS SHOWN.
DIMENSIONS ARE GIVEN IN FEET & DECIMALS.
LORAIN, OHIO OCT. 22, 1945
SCALE 1 INCH = 30 FEET

J. B. NICHOLS ~ REGISTERED SURVEYOR

02-03-001-102-012