Parcel # 07-00-023-102-045
Old # 07-00-023-102-063,066
Plat # 01817

SURVEY

OF PART OF

ORIGINAL RIDGEVILLE TOWNSHIP LOT 23

CITY OF N. RIDGEVILLE COUNTY OF LORAIN

AND

STATE OF OHIO

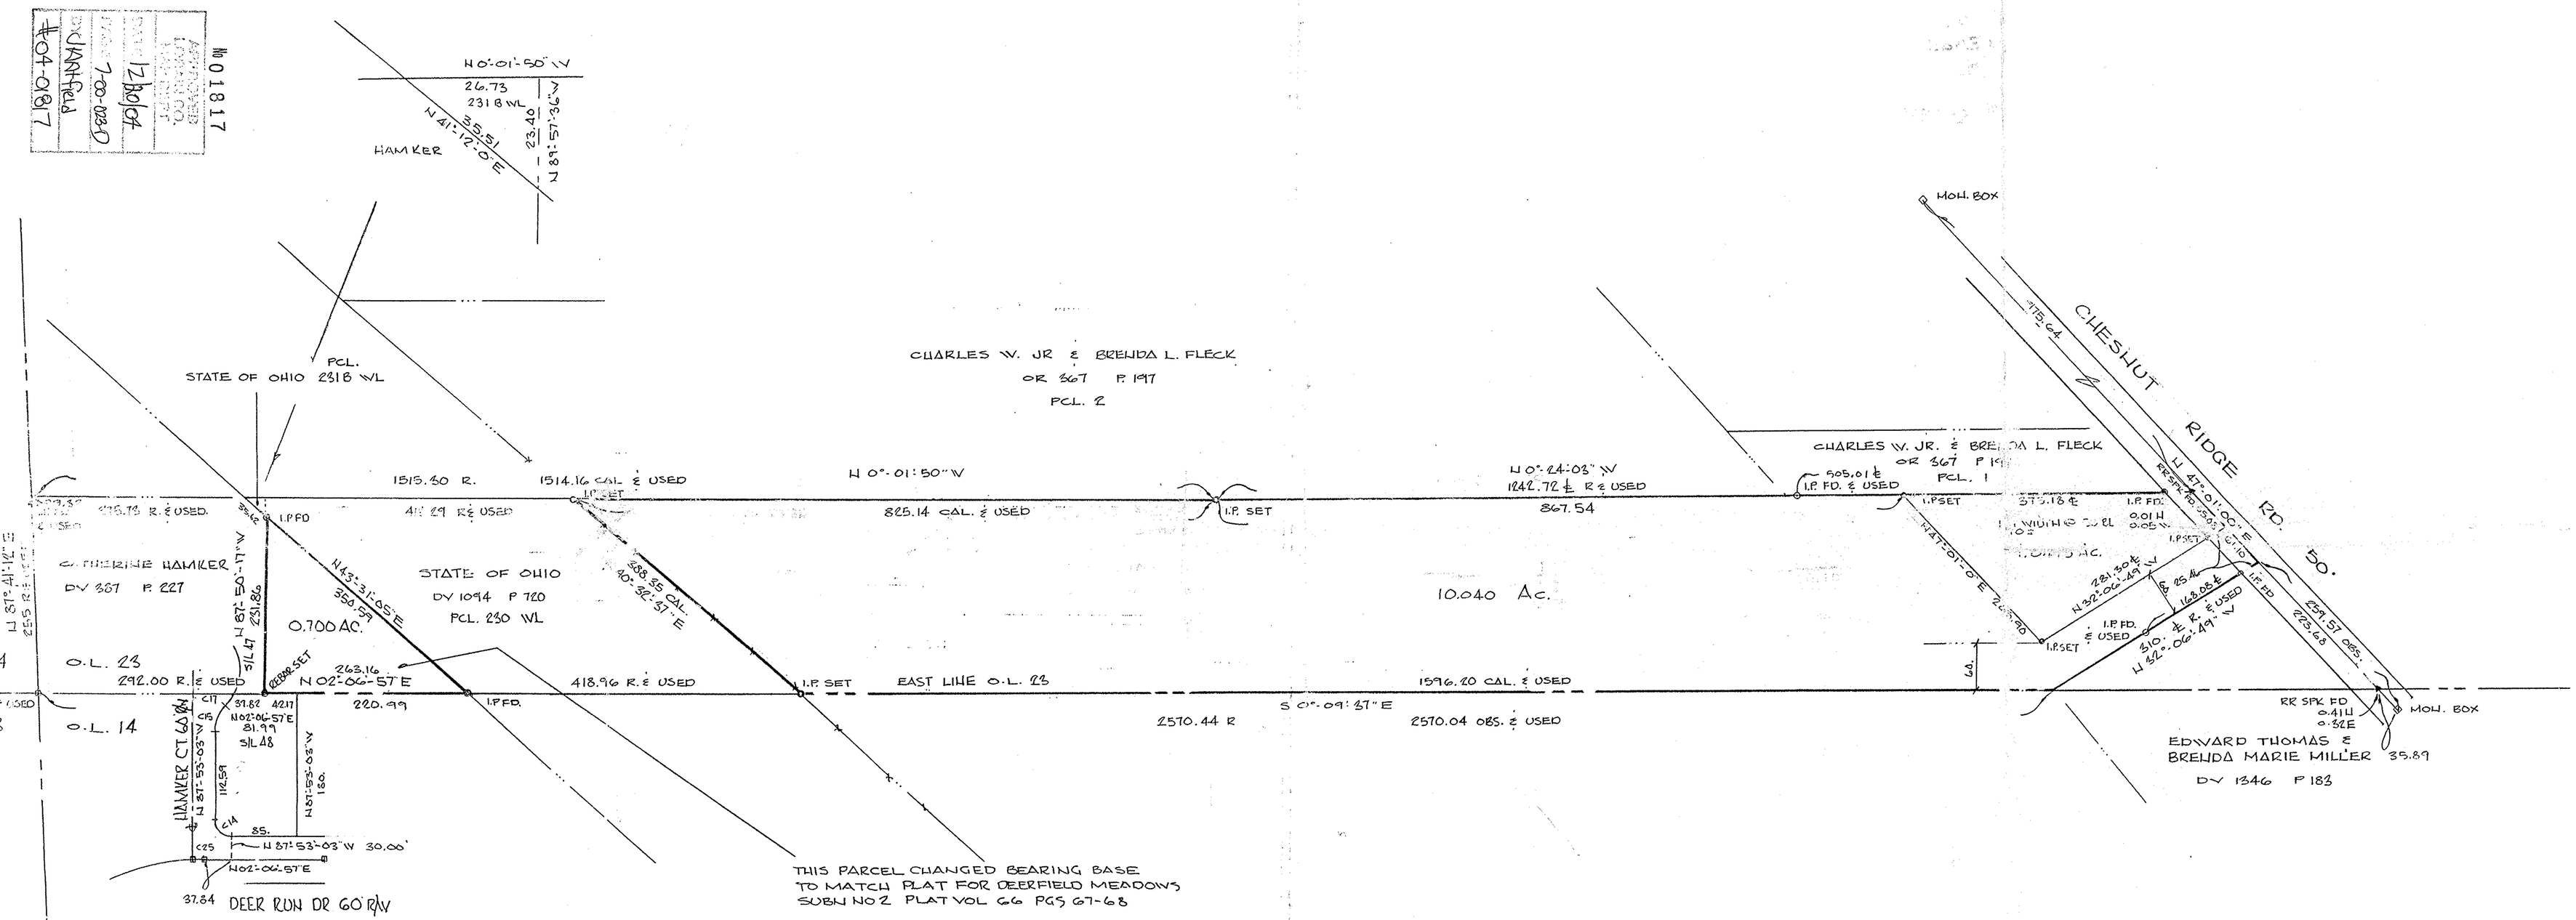

CURVE TABLE

CURVE	DELTA	RADIUS	ARC	TANG.	CHORD
C14	90°-00'-00"	20.00	31.42	20.00	S47°-06'-57" W 28.28
C15	43°-20'-26"	50.00	37.82	19.87	N 66°-12'-45" W 36.93
C17	15°-25'-23"	60.00	16.15	8.12	N 52°-15'-14" W 16.10
C25	02°-27'-55"	290.00	12.48	6.24	S 00°-52'-59" W 12.48

PREPARED FOR:

BENNY HAMM
35063 CHESTNUT RIDGE RD
N. RIDGEVILLE, OH

AND

AL KENA
34828 DEER RUN DR.
N. RIDGEVILLE, OH.

DATE: FEB, 1994
SCALE: 1" = 100'

PREPARED BY:

HAPONEK AND ASSOC.
SURVEYORS AND ENGINEERS
N. RIDGEVILLE, OH

STATE OF OHIO
DANE A. HAPONEK
S-6211
REGISTERED SURVEYOR

REVISED OCT, 2004 ADDED S/L48 AND
REVISED 4-24-94 ADDED SPLIT

94-03