SURVEY
OF PART OF
ORIGINAL LOT NO 9 TRACT NO. 7
BRIGHTON TOWNSHIP
TWP. OF BRIGHTON COUNTY OF LORAIN
STATE OF OHIO

PREPARED FOR
BRENT ZIEGLER
49200 JONES ROAD
WELLINGTON, OH. 44090

PREPARED BY
DANE A. HAPONEK
REG. SURVEYOR
5444 STONEY RIDGE RD.
N. RIDGEVILLE, OH.

STATE OF OHIO
DANE A. HAPONEK
S-6211
REGISTERED SURVEYOR

DATE: JUNE 2004
SCALE: 1" = 100'

PCL 17-07-009-000-019 REMAINDER 170.96±

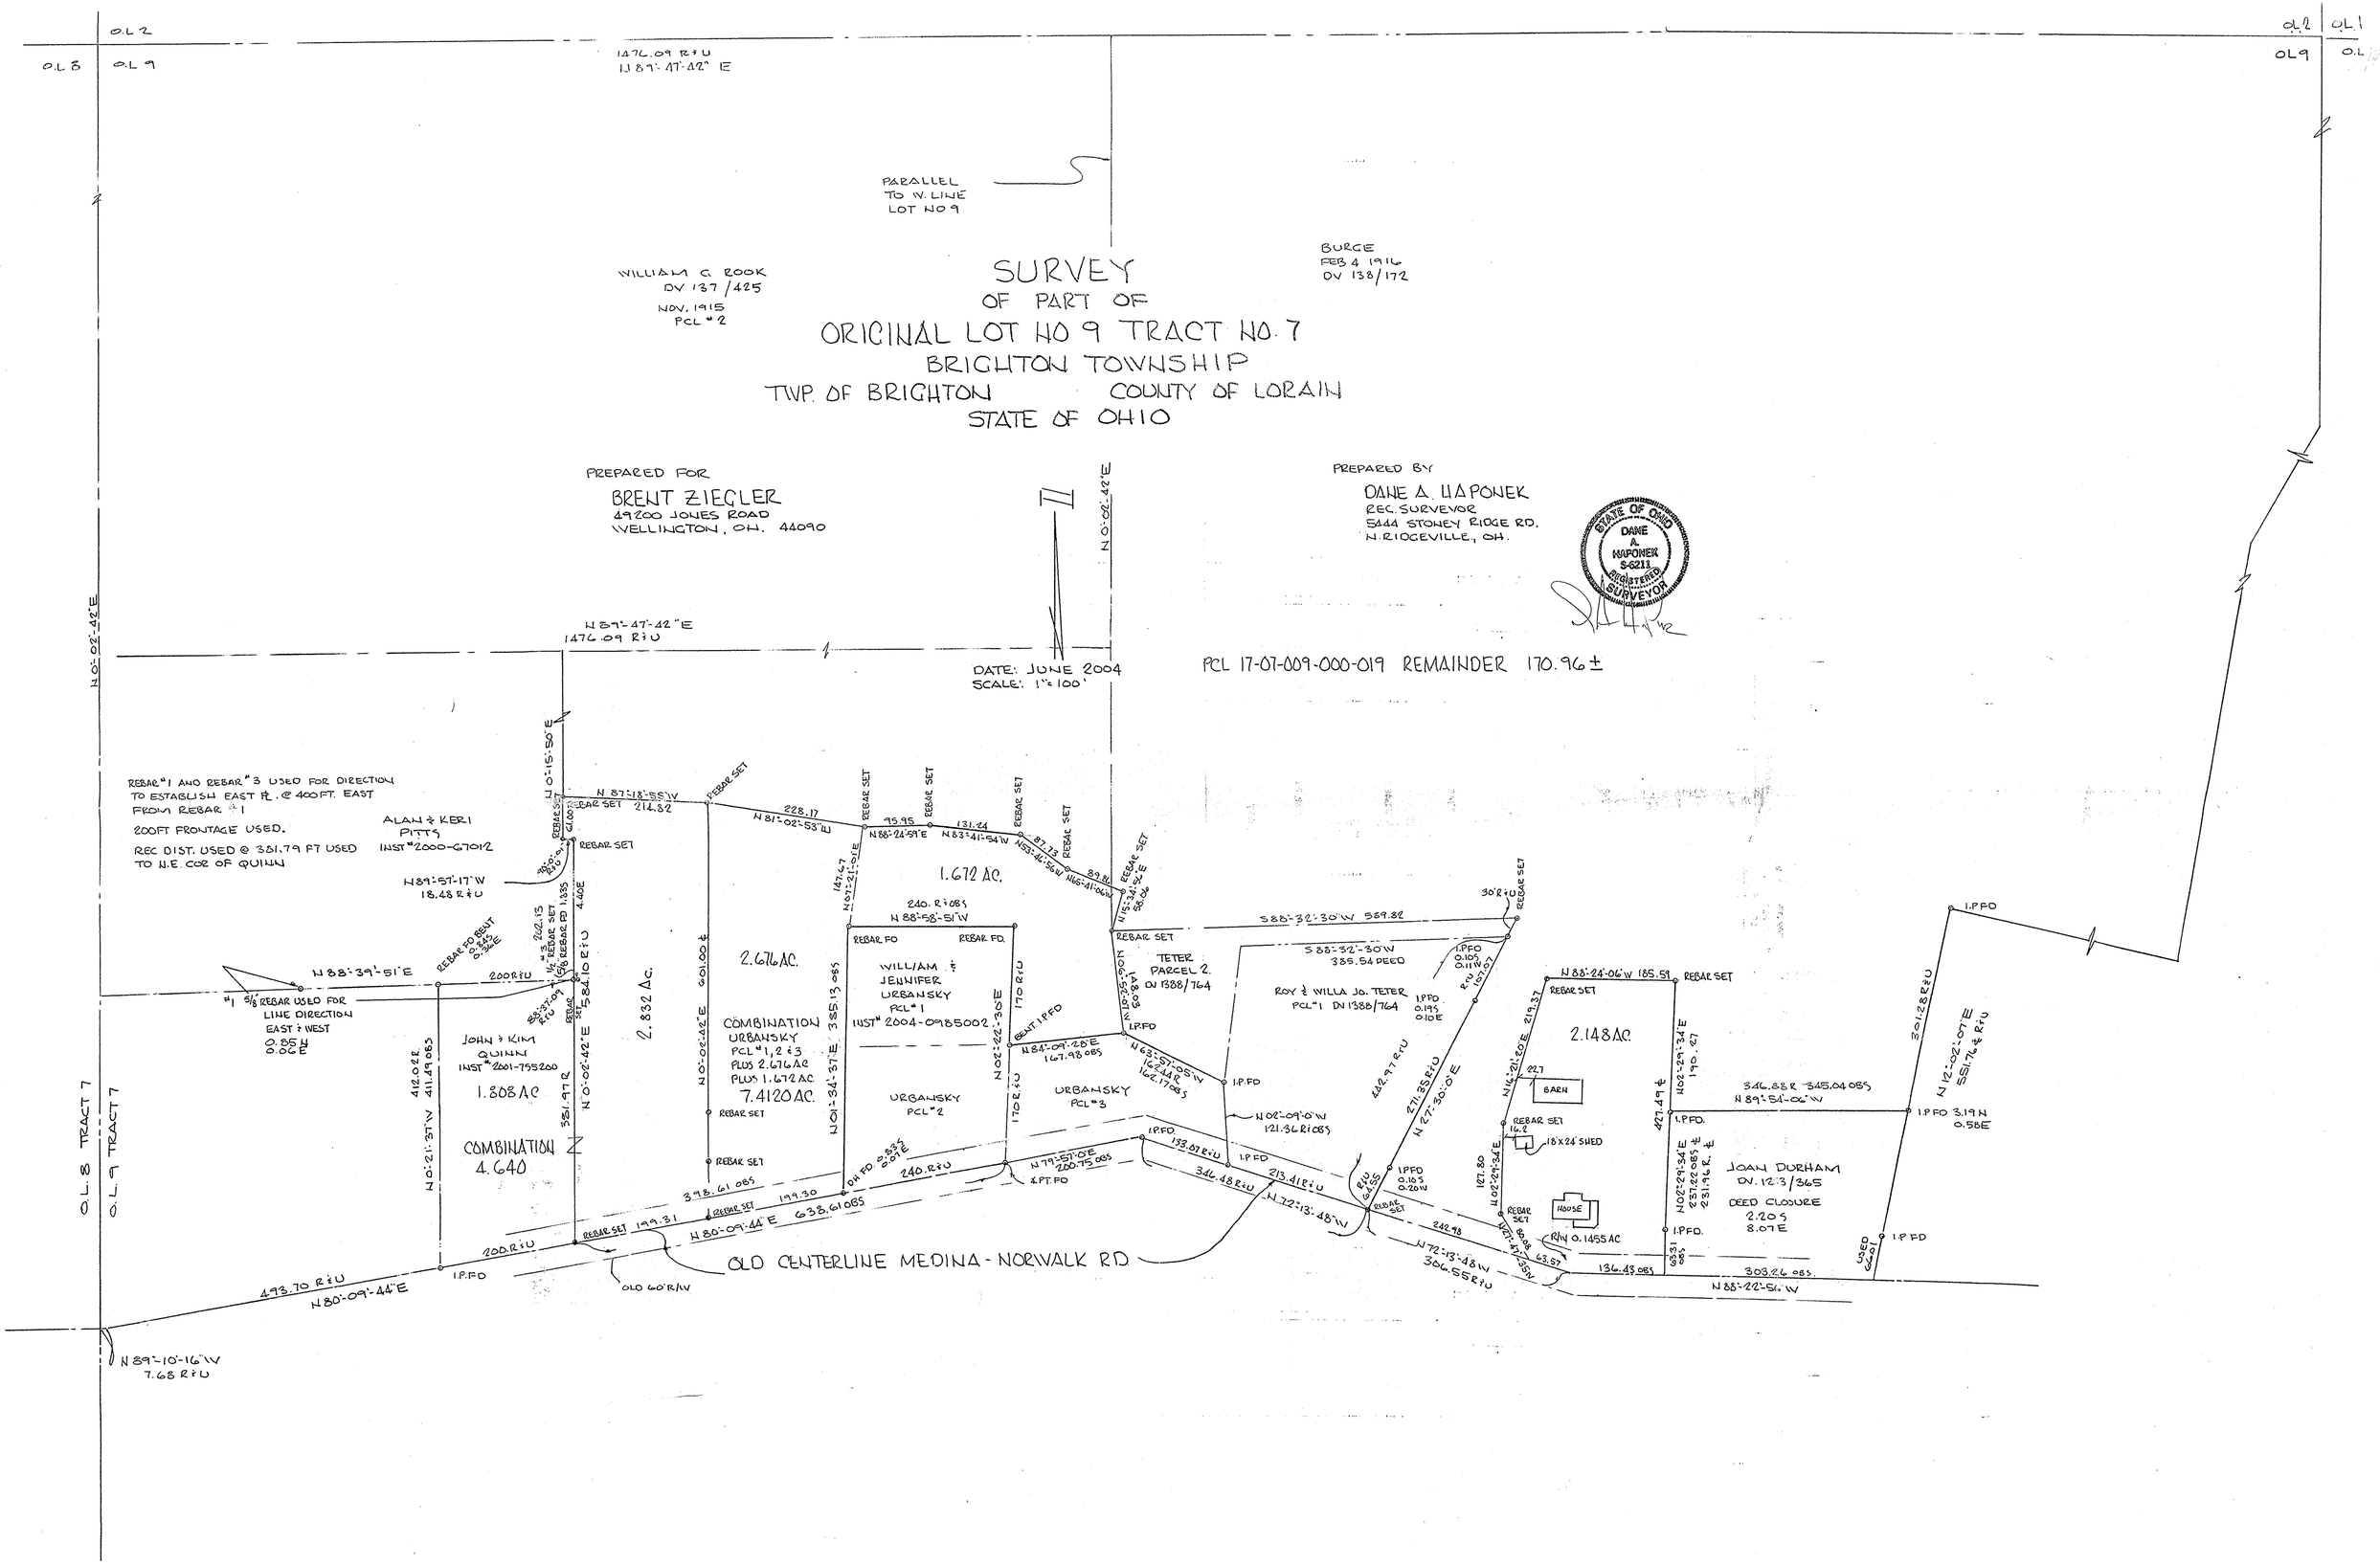

04-03