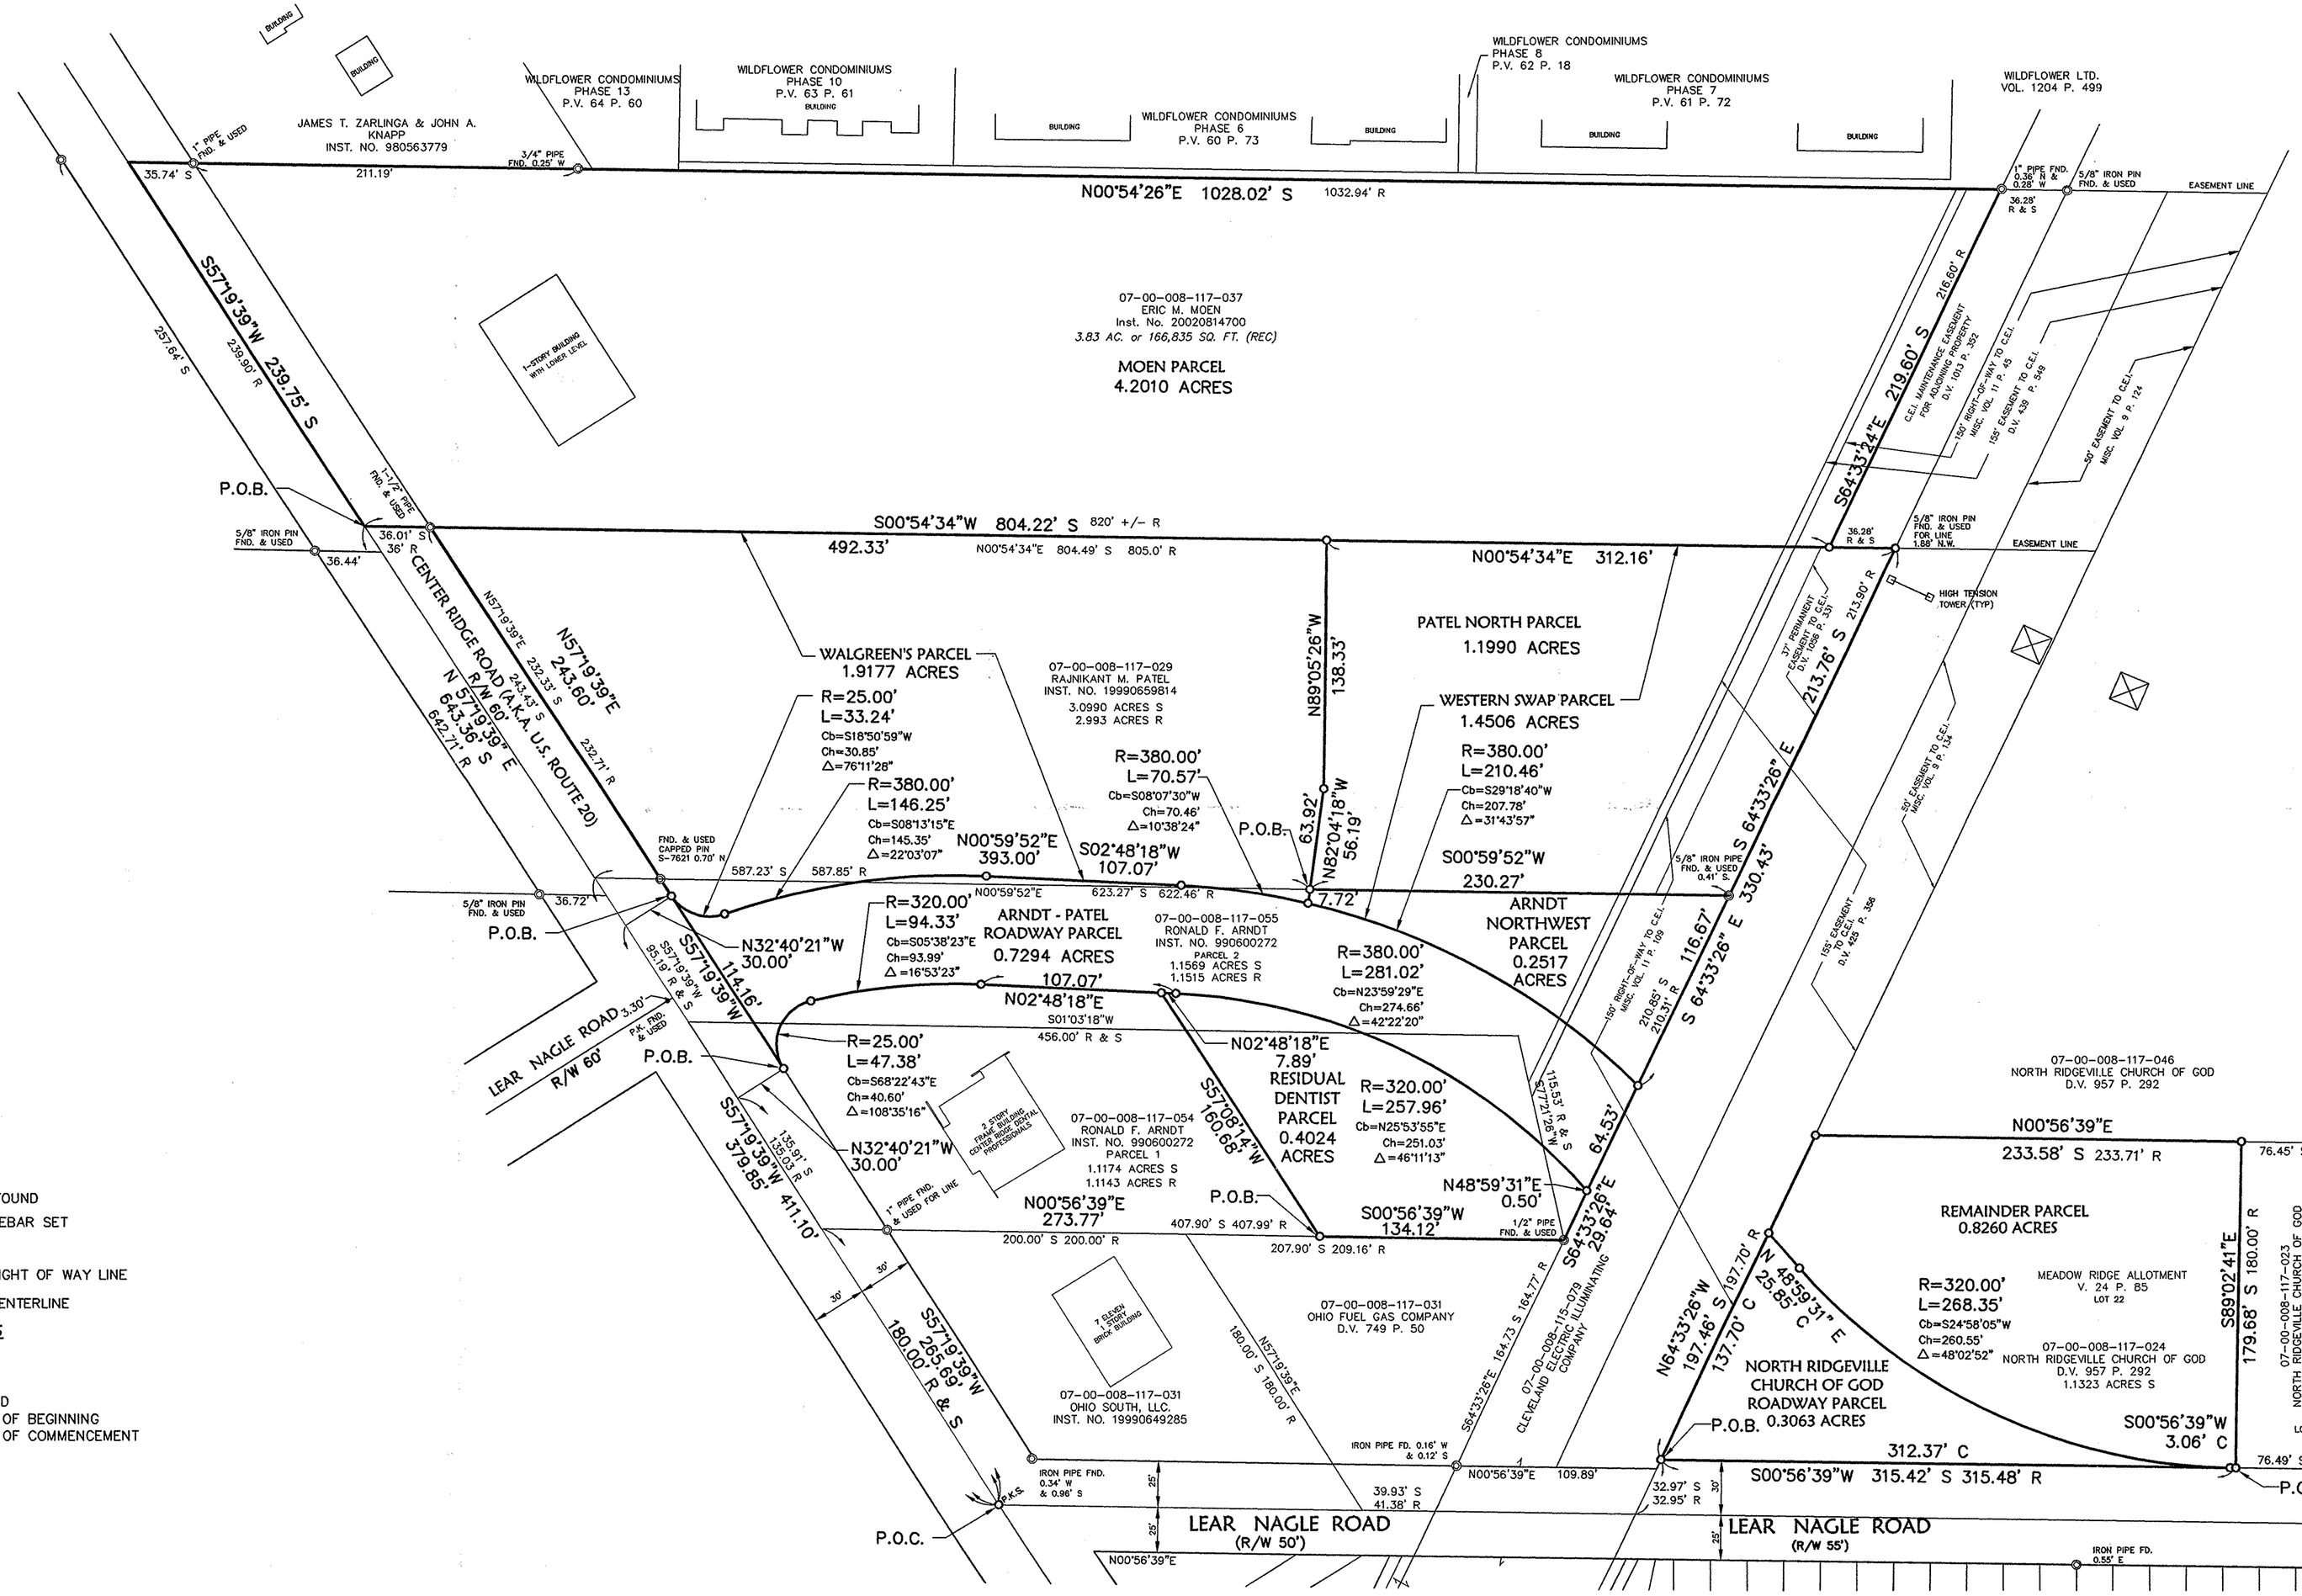

No 01833
APPROVED
LORAIN CO.
MAP DEPT
DATE 1-10-05
PAGE 7-00-008-C
BY JHatfield
05-01833

LEGEND

- IRON PIN/PIPE FOUND
- 5/8" CAPPED REBAR SET
- P.K.S.O SET PK NAIL
- RIGHT OF WAY LINE
- CENTERLINE

ABBREVIATIONS

FND. = FOUND
R = RECORD
S = SURVEYED
C = CALCULATED
P.O.B. = POINT OF BEGINNING
P.O.C. = POINT OF COMMENCEMENT

SURVEYOR'S NOTES:

1) BEARINGS ARE BASED ON OHIO STATE PLANE "GRID NORTH" NAD83 1995 FROM OBSERVATIONS PERFORMED AUGUST 1, 2000.

2) THERE ARE EXISTING IMPROVEMENTS NOT SHOWN HEREON.

3) PERTINENT RECORDS USED ARE AS SHOWN HEREON.

50 0 50 100
SCALE IN FEET
1"= 50'

DATE: 04-OCT-04
DRAWN BY: MAM
CH'D BY:
DWG. NAME: 0-SPLIT04.dwg
PATH: R:\03000\03157\CONTROL
F.B. NA

REVISIONS	DATE	DESCRIPTION	BY

KS ASSOCIATES
KS Associates, Inc.
860 Burns Rd., Suite 100
Elyria, Ohio 44035
Phone (440) 365-4730
Fax (440) 365-4790
mailroom@ksassoc.com
www.ksassoc.com

PARCEL MAP

OF PART OF ORIGINAL RIDGEVILLE TOWNSHIP LOT NO. 8
CITY OF NORTH RIDGEVILLE
COUNTY OF LORAIN, STATE OF OHIO

SHEET 1 OF 1

JOB NO. 03157